
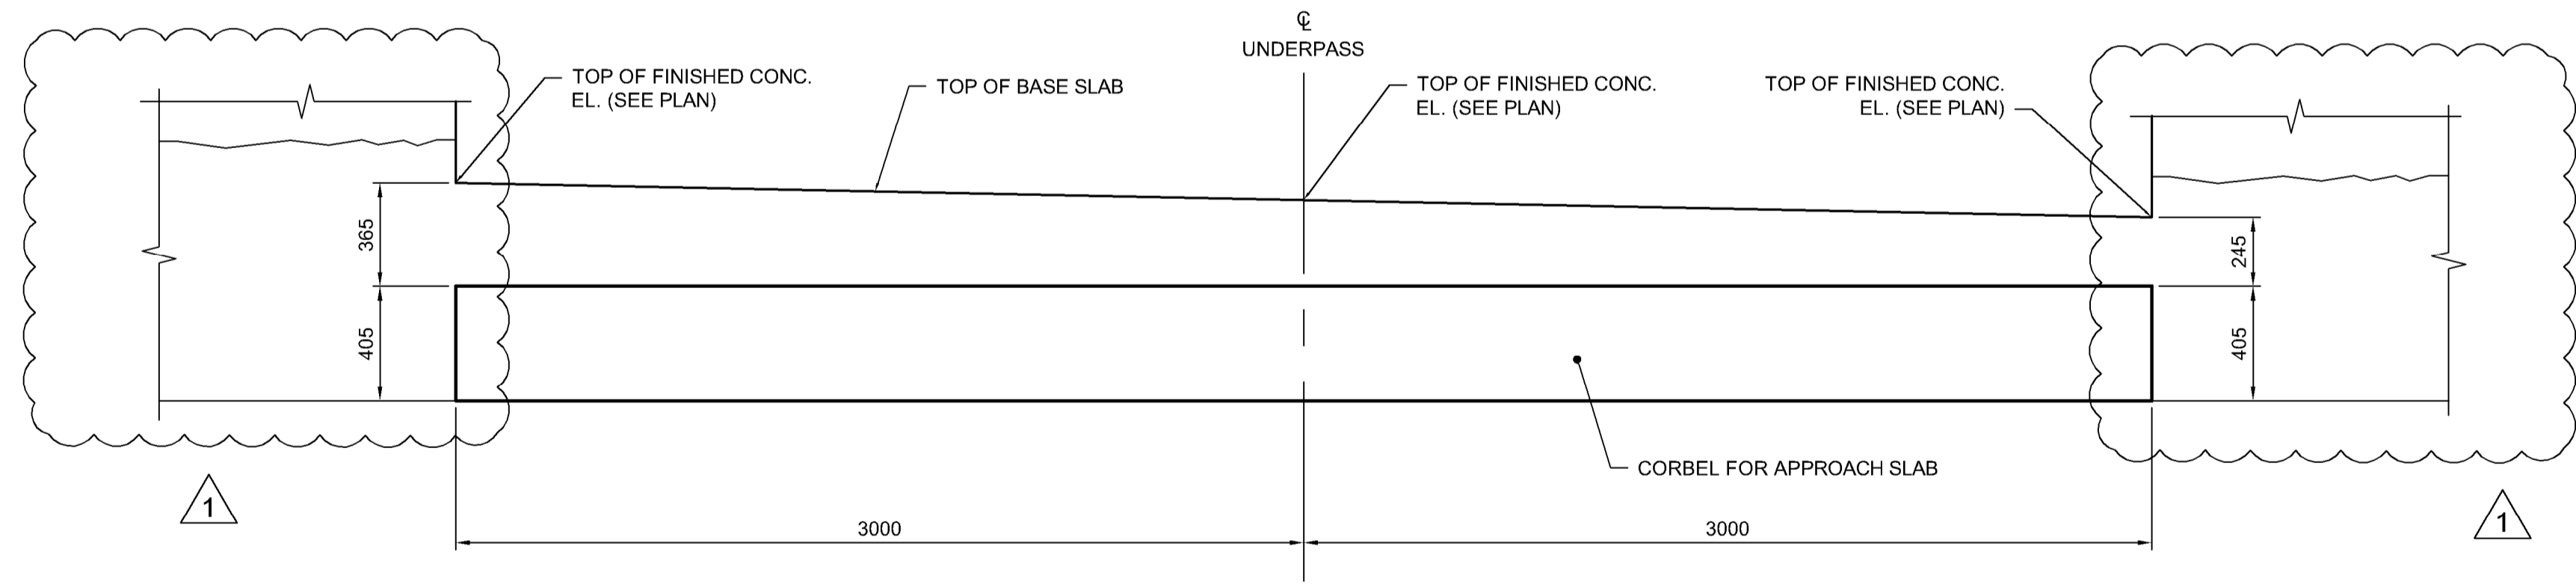


G:\CAD\175932\Drawings\Structural\Contract\UNDERPASS\175932-UNDERPASS-CON-CS-CONC-DETAILS_2.dwg

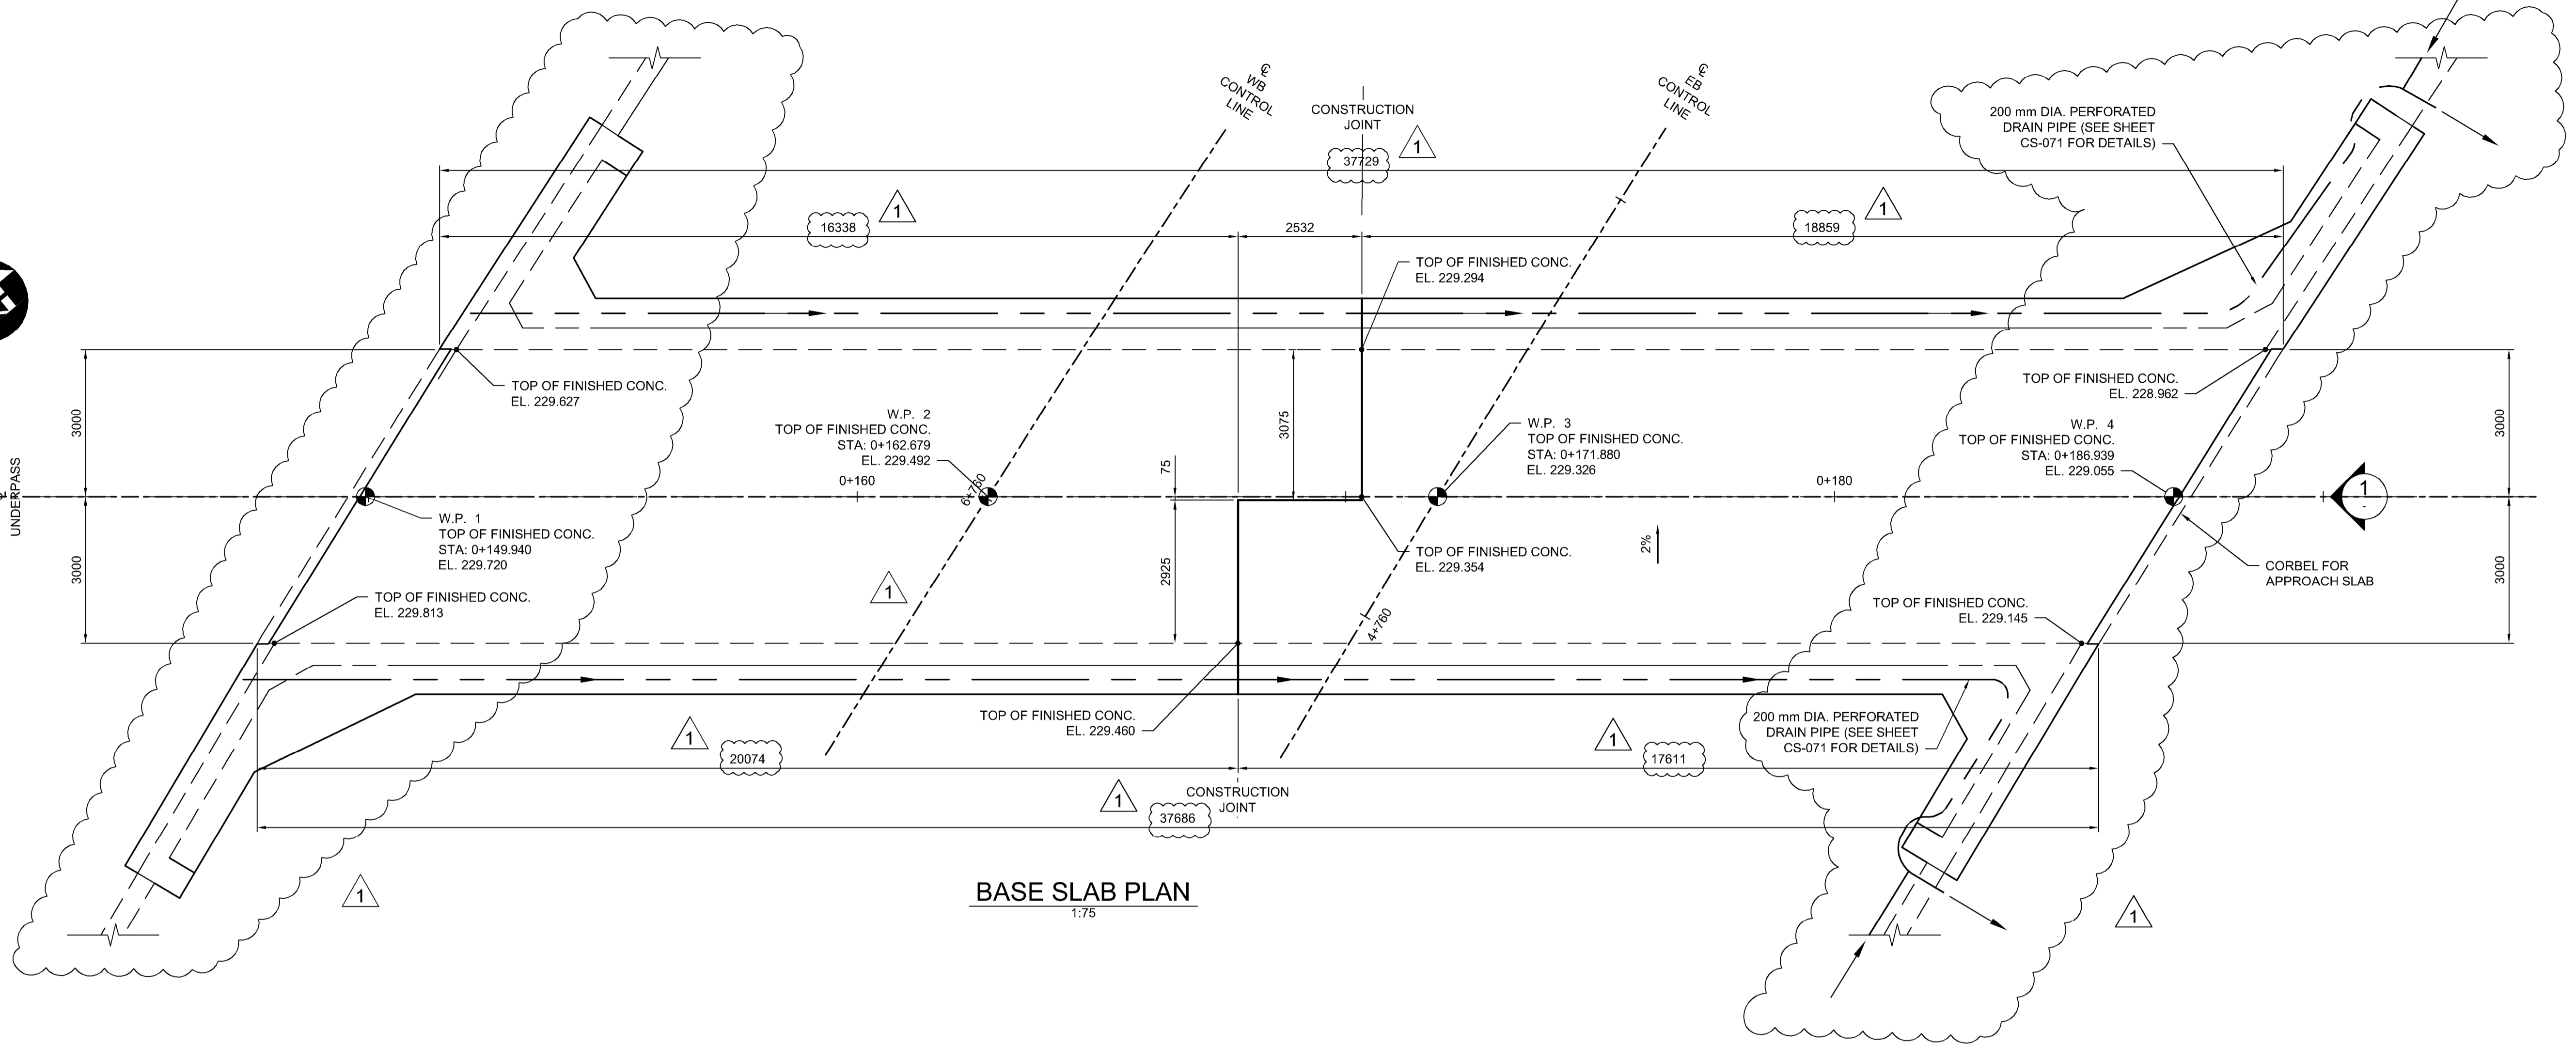

NO.	REVISIONS	DATE	BY
1	ADDENDUM #5	18/03/16	DRA
0	ISSUED FOR TENDER	18/02/09	DRA

DILLON CONSULTING	
DESIGNED BY: DRA	CHECKED BY: SSR
DRAWN BY: CGC / DB	APPROVED BY: MBL
HOR. SCALE: AS SHOWN	RELEASED FOR CONSTRUCTION
VERTICAL SCALE: AS SHOWN	DATE: 2018/02/09

ENGINEER'S SEAL

PROVINCE OF MANITOBA
D.R.C. AMORIM
Member 33215
REGISTERED PROFESSIONAL ENGINEER

CONSULTANT PROJECT NUMBER
17-5932

THE CITY OF WINNIPEG
PUBLIC WORKS DEPARTMENT

FERMOR AVENUE BRIDGE OVER SEINE RIVER
BRIDGE REHABILITATION, PEDESTRIAN-CYCLIST UNDERPASS STRUCTURE AND ROADWORKS FROM ST. ANNE'S ROAD TO ARCHIBALD STREET

PEDESTRIAN-CYCLIST UNDERPASS
CONCRETE DETAILS 2 OF 3

CITY DRAWING NUMBER: U-243-2017-CS-070
SHEET 070 OF 100
CONSULTANT DRAWING NUMBER: CS-070