



**EXISTING PROFILE**  
Scale N.T.S.

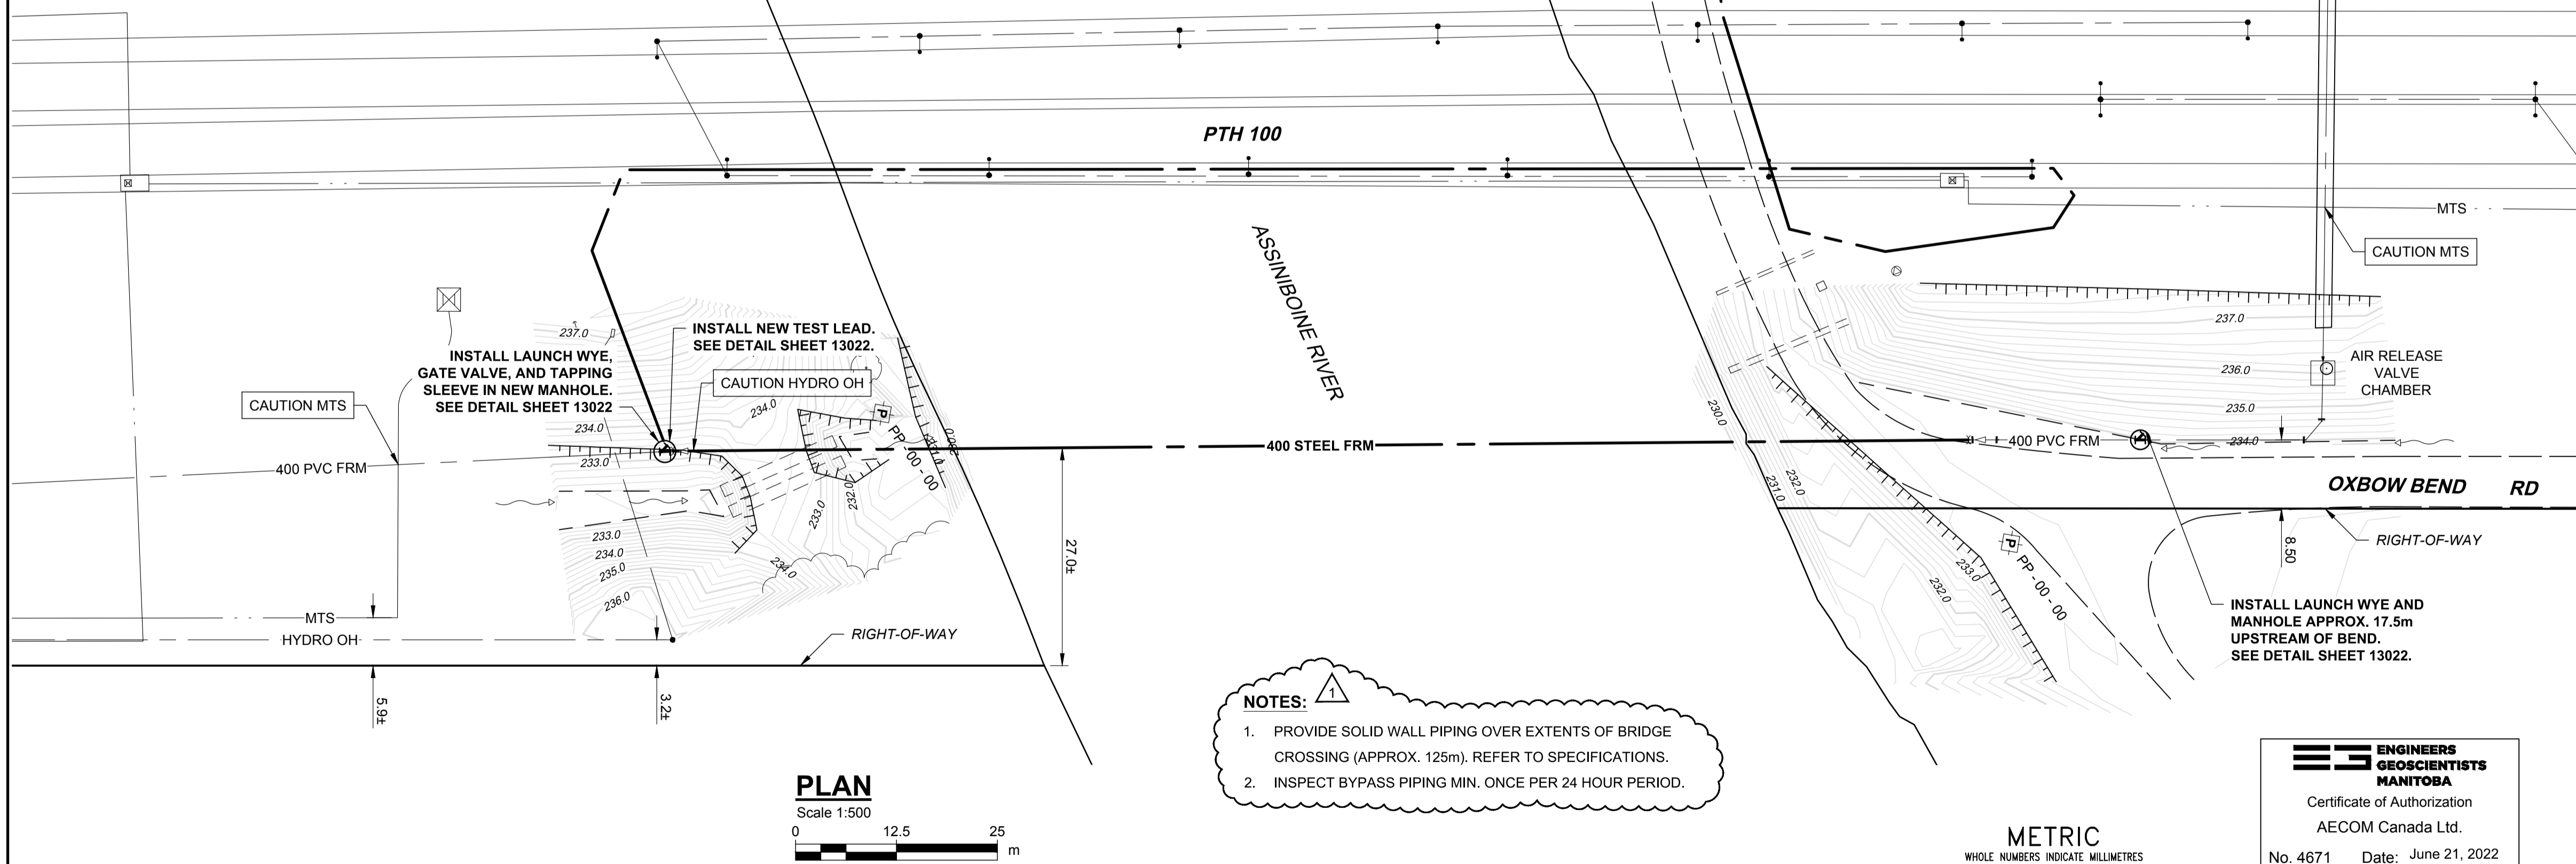


**PLAN**  
Scale 1:500

- NOTES:**
1. PROVIDE SOLID WALL PIPING OVER EXTENTS OF BRIDGE CROSSING (APPROX. 125m). REFER TO SPECIFICATIONS.
  2. INSPECT BYPASS PIPING MIN. ONCE PER 24 HOUR PERIOD.

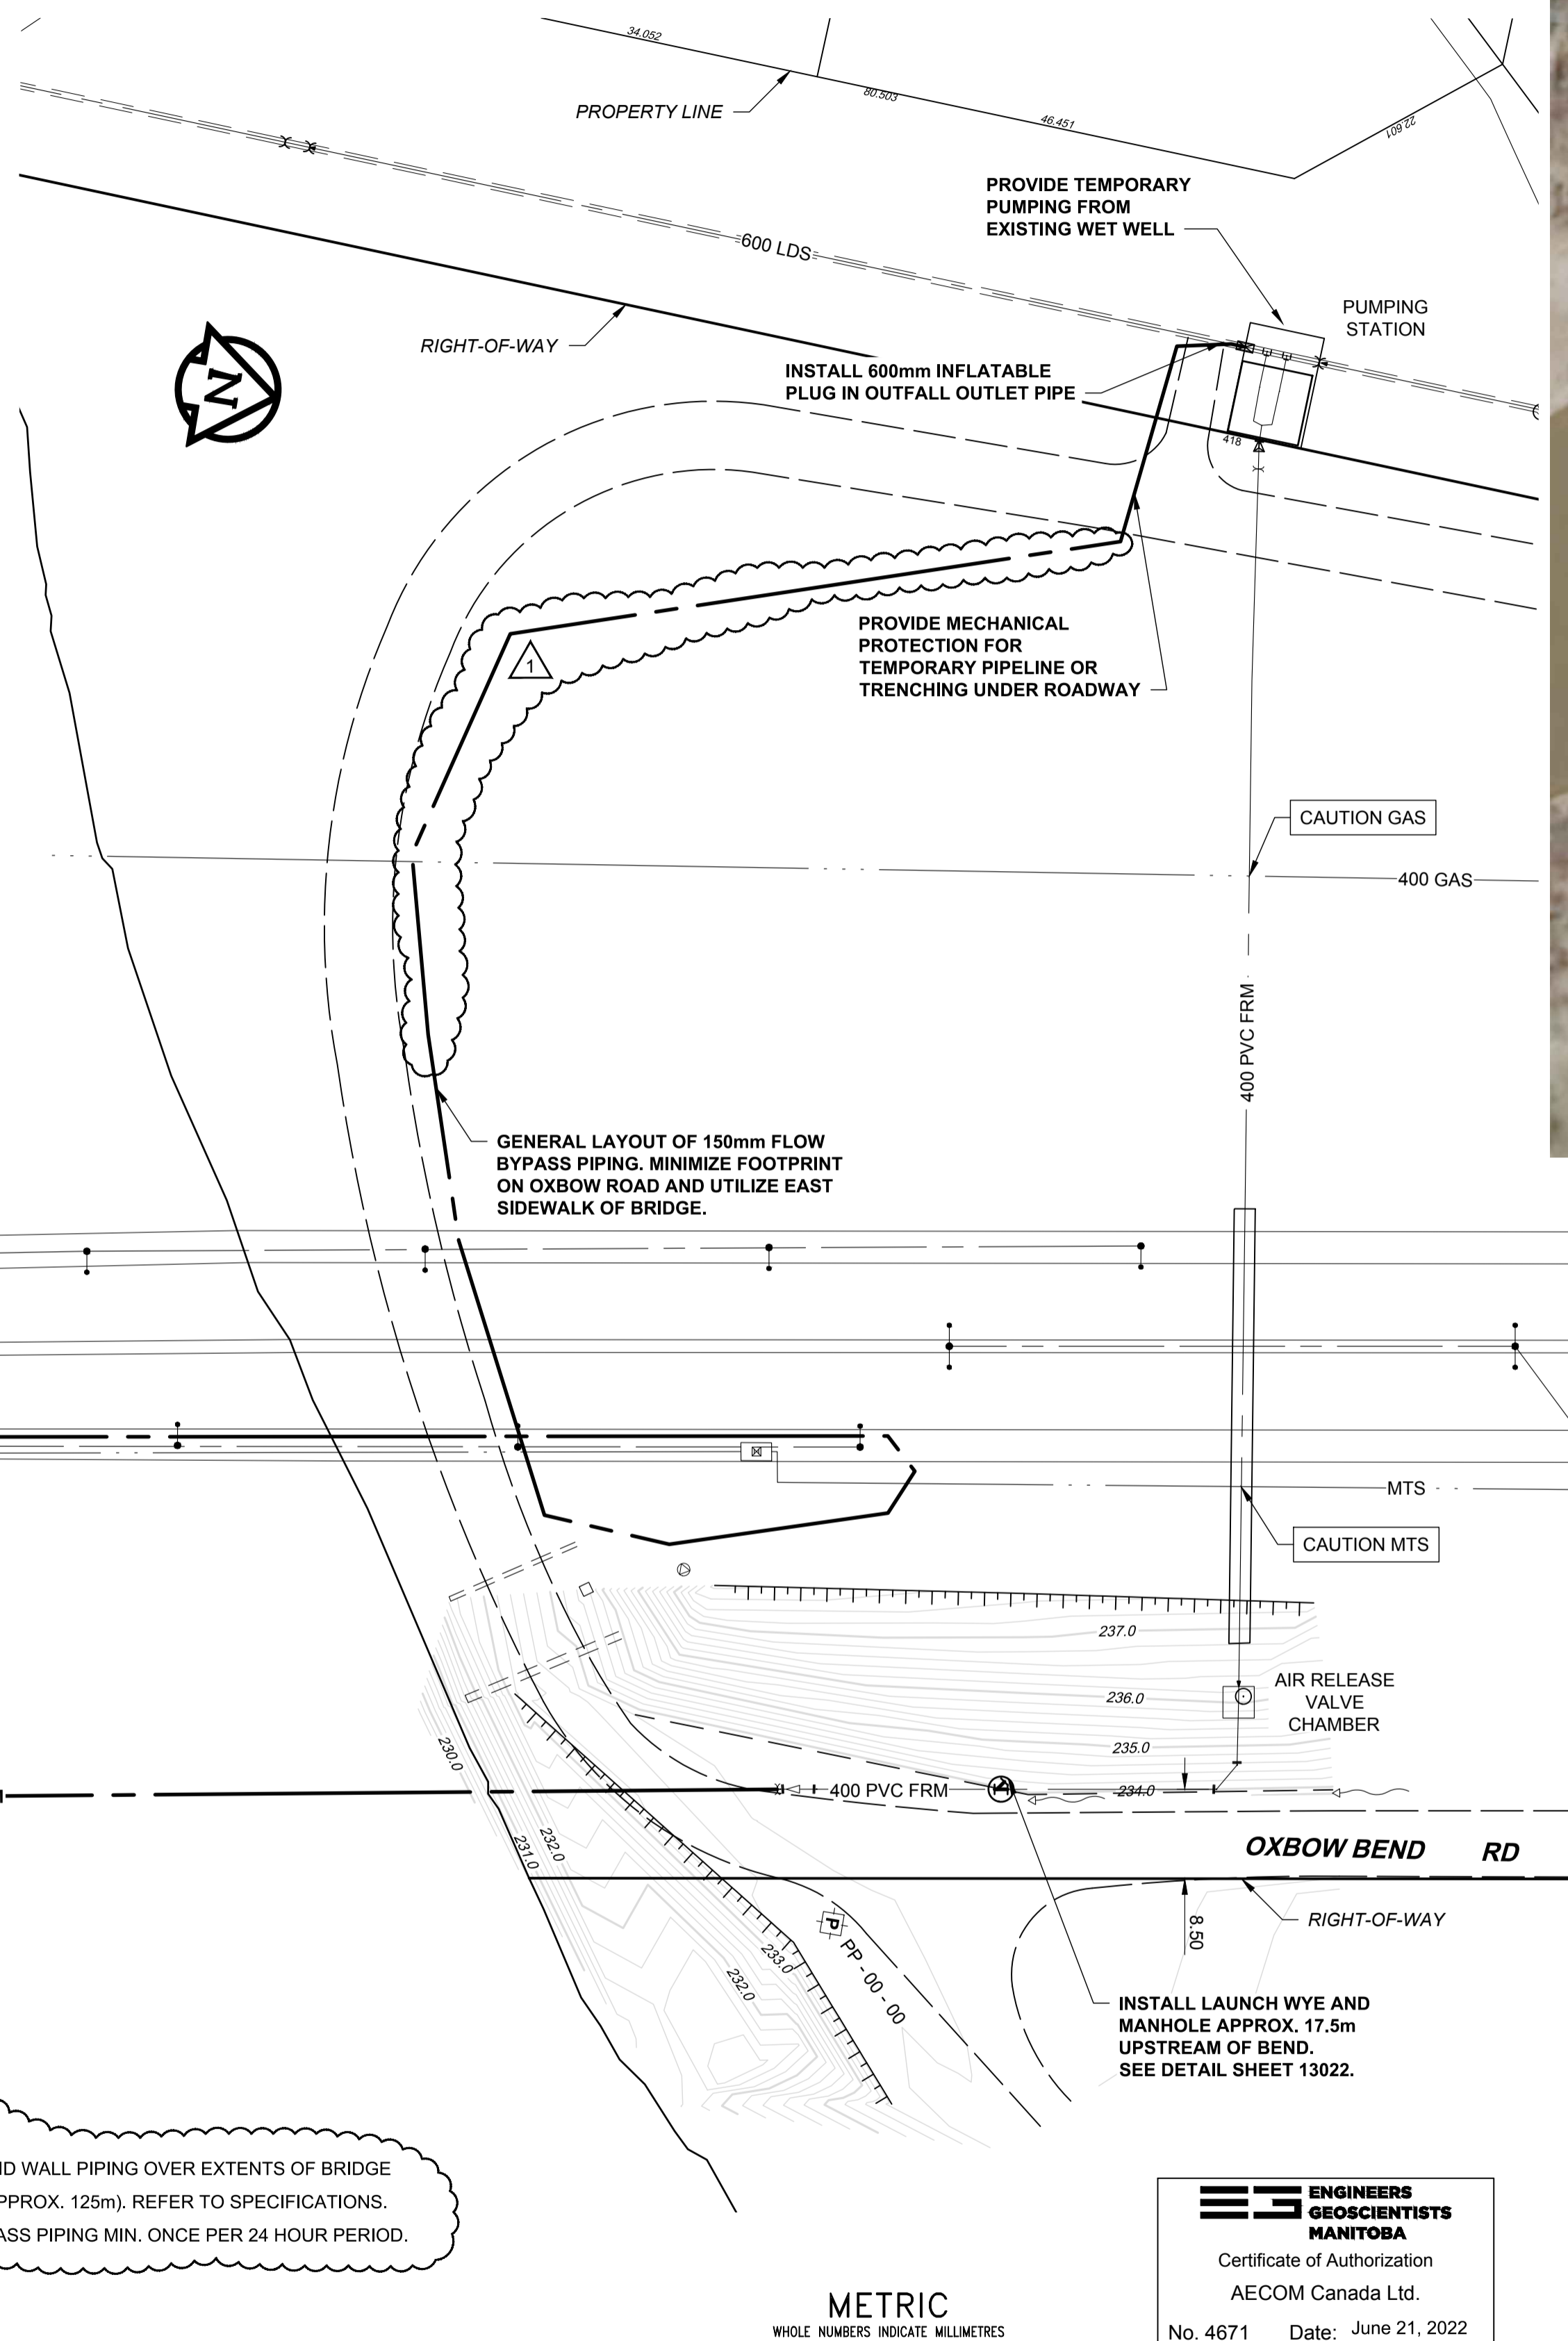

**SITE PLAN**  
Scale 1:1500

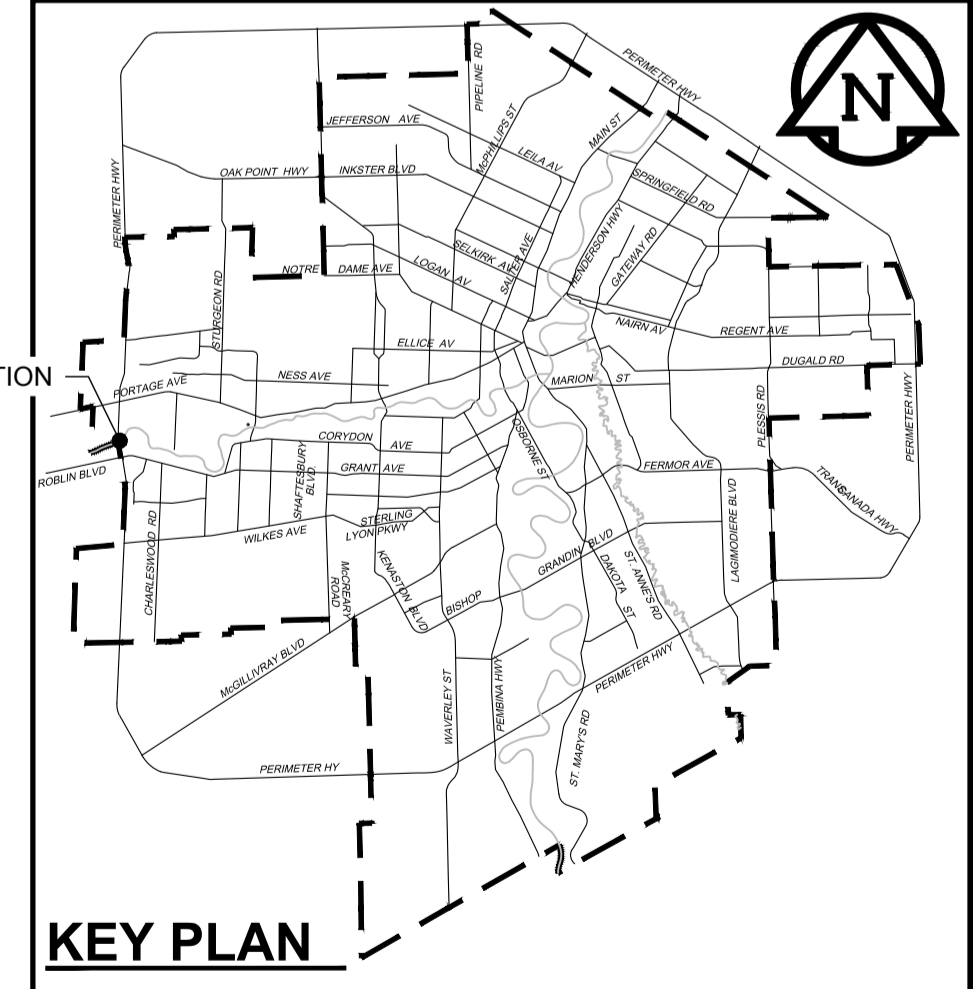

**ENGINEERS GEOSCIENTISTS MANITOBA**  
Certificate of Authorization  
AECOM Canada Ltd.  
No. 4671 Date: June 21, 2022

**METRIC**  
WHOLE NUMBERS INDICATE MILLIMETRES  
DECIMALIZED NUMBERS INDICATE METRES

**WARNING**  
IF POWER EQUIPMENT OR EXPLOSIVES ARE TO BE USED FOR EXCAVATION ON THIS PROJECT THE CONTRACTOR MUST:  
1) NOTIFY THE GAS COMPANY OF THE PROPOSED LOCATION OF EXCAVATION.  
2) TAKE PRECAUTION TO AVOID DAMAGE TO GAS COMPANY INSTALLATIONS.  
SEE PROVINCIAL REGULATION 21072 FOR DETAILS

**LOCATION APPROVED UNDERGROUND STRUCTURES**  
SUPV. U/G STRUCTURES COMMITTEE DATE  
NOTE:  
LOCATION OF UNDERGROUND STRUCTURES AS SHOWN ARE BASED ON THE BEST INFORMATION AVAILABLE BUT NO GUARANTEE IS GIVEN THAT ALL EXISTING UTILITIES ARE SHOWN OR THAT THE GIVEN LOCATIONS ARE EXACT. CONFIRMATION OF EXISTENCE AND EXACT LOCATION OF ALL SERVICES MUST BE OBTAINED FROM THE INDIVIDUAL UTILITIES BEFORE PROCEEDING WITH CONSTRUCTION.

B.M. 84R505 N.W. Cor. Saskatchewan Ave. & Midland St., Tbt. on top of 0.05 m dia. x 1.2 m iron pipe 10.2 m S. of N.L. of Saskatchewan Ave. & 5.6 m E. of W.L. of Midland St.			
CONSTRUCTION COMPLETION DATE: YYYY MM DD			
NO.	ISSUED FOR	DATE	BY
1	ISSUED FOR ADDENDUM 2	22/07/11	ADL
0	ISSUED FOR TENDER	22/06/15	ADL

<b>AECOM</b>	
DESIGNED BY	TJB
CHECKED BY	MGM
DRAWN BY	ADL
APPROVED BY	KWF
RELEASED FOR CONSTRUCTION	Paul Bortoluzzi
DATE	2022 07 11
DATE	Jun 21/22

ENGINEER'S SEAL  
ORIGINAL SIGNED BY J. Thompson  
June 21, 2022  
CONSULTANT DRAWING NUMBER C-1005

**THE CITY OF WINNIPEG**  
WATER AND WASTE DEPARTMENT  
ENGINEERING DIVISION  
PROVISION OF PIPELINE ACCESS MODIFICATIONS, CLEANING AND SUPPORT SERVICES FOR RIVER CROSSING INSPECTIONS - PHASE THREE  
SITE 5  
WEST PERIMETER FORCE MAIN  
SHEET 06 OF 11  
CITY DRAWING NUMBER 13021