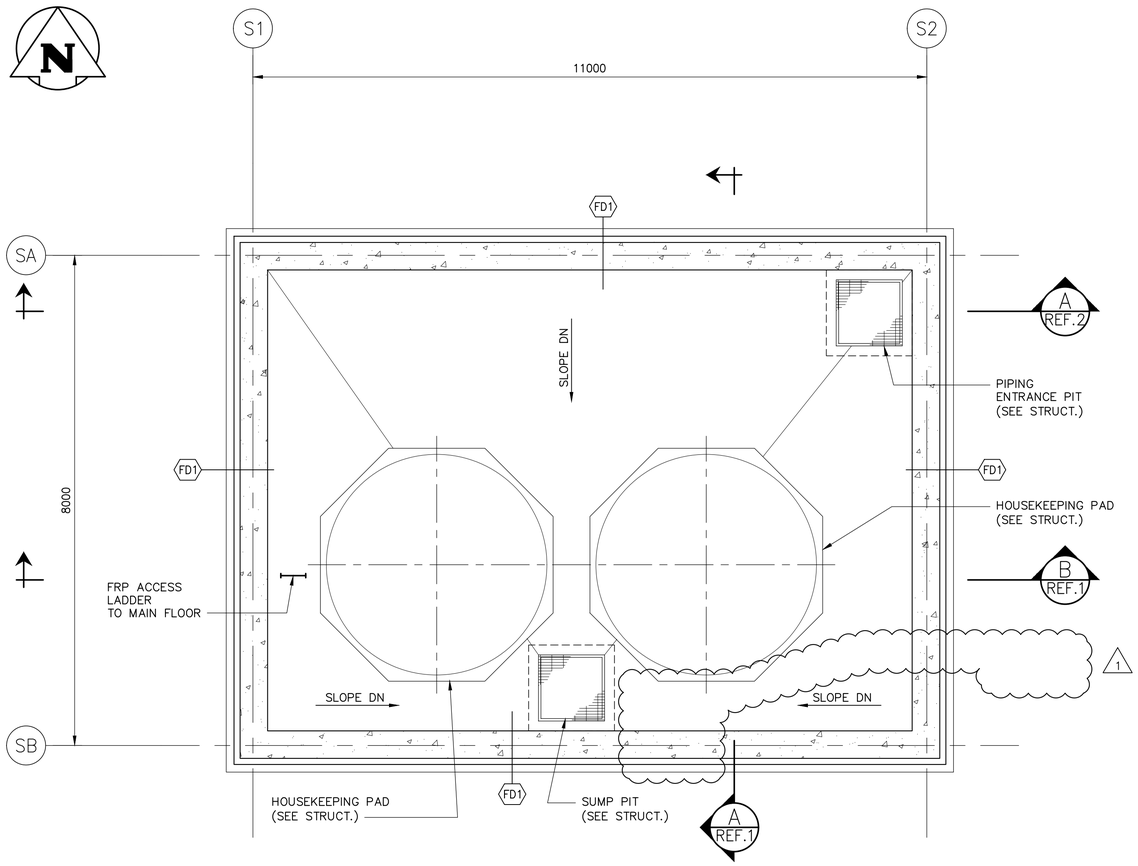

CONTAINMENT PLAN

SCALE: 1:50

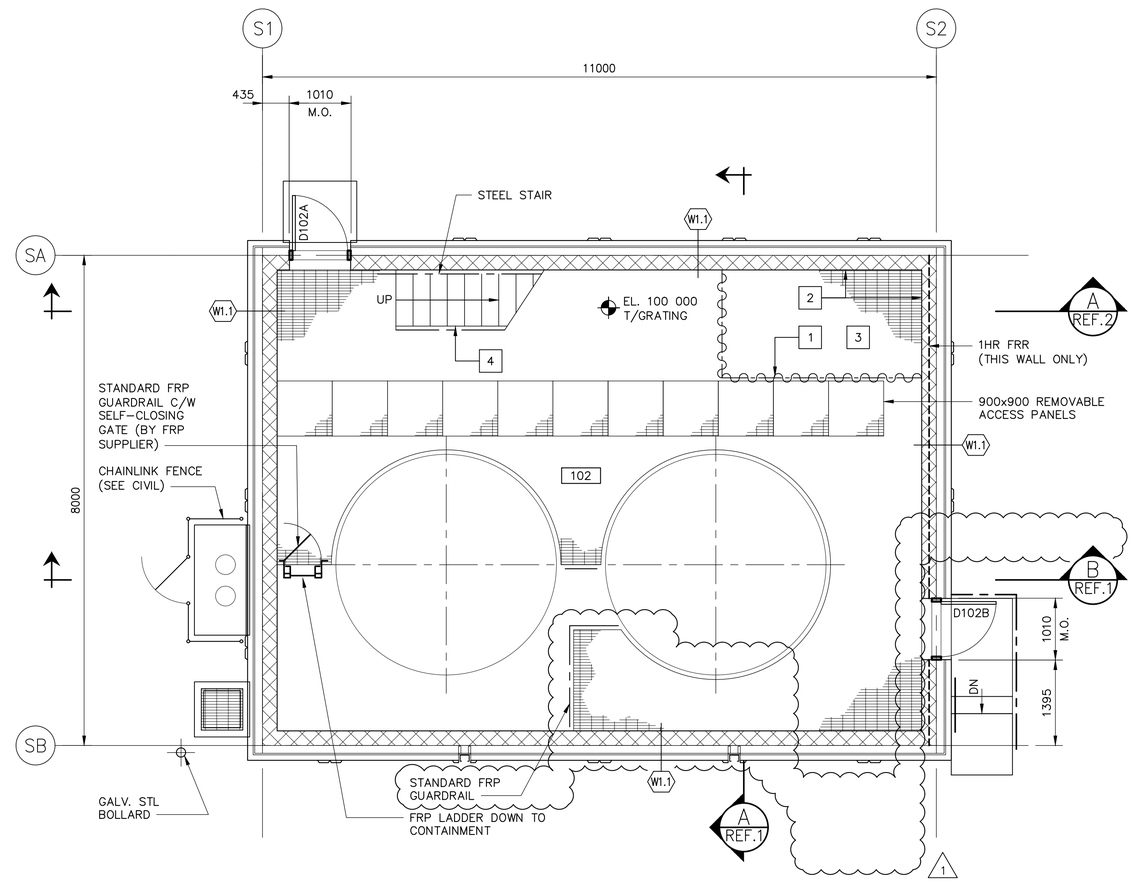

MAIN FLOOR PLAN

SCALE: 1:50

KEYNOTES:

1 CHEMICAL SAFE CURTAINS ON TRACK FASTENED TO STRUCT. ABOVE. PROVIDE SUPPORT FRAMING AS REQ'D.

2 CHEMICAL RESISTANT PAINT ON CONC. BLK WITHIN LIMITS OF CURTAINS.

3 CHEMICAL RESISTANT FRP PANELS TO BE HUNG FROM FLOOR STRUCTURE ABOVE WITHIN THE LIMITS OF CURTAINS TO PROTECT HVAC UNIT ABOVE. PROVIDE FRAMING TO SUIT FRP PANEL SUPPORT.

4 STEEL STAIR C/W HANDRAIL ON BOTH SIDES (SEE STRUCT.).

NO.	DRAWING NUMBER	REFERENCE DRAWING TITLE
10	–	–
9	–	–
8	–	–
7	–	–
6	–	–
5	–	–
4	–	–
3	–	–
2	1-0101-BGAD-F212-002	BUILDING SECTIONS
1	1-0101-BGAD-F212-001	BUILDING SECTIONS

REFERENCE DRAWINGS

ENGINEERS GEOSCIENTISTS MANITOBA
Certificate of Authorization
KGS Group
No. 245

B.M.
ELEV.

CONSTRUCTION COMPLETION DATE: YYYY MM DD

NO.	REVISIONS	DATE	BY
1	RE-ISSUED FOR CONSTRUCTION	2022 06 17	JMW
0	ISSUED FOR CONSTRUCTION	2022 05 18	JMW

KGS GROUP

DESIGNED BY	SNH	CHECKED BY	JMW
DRAWN BY	SNH	APPROVED BY	JMW
SCALE:	1:50	RELEASED FOR CONSTRUCTION	
DATE	2022 02 22	DATE	

PLOT DATE: 2022 06 17

ENGINEER'S SEAL

PROVINCE OF MANITOBA
J.M. WALTER
Member 24941
REGISTERED PROFESSIONAL ENGINEER
2022-06-17

CONSULTANT DRAWING NUMBER
21-0107-015_B2.201

BID OPPORTUNITY: 197-2022
CONTRACT NUMBER:

Winnipeg

THE CITY OF WINNIPEG

WATER AND WASTE DEPARTMENT
ENGINEERING DIVISION

NORTH END SEWAGE TREATMENT PLANT (NEWPCC)
INTERIM PHOSPHOROUS REMOVAL
AREA F – CHEMICAL RECEIVING AND STORAGE FACILITY

CONTAINMENT & MAIN FLOOR PLAN
BUILDING 102

CITY DRAWING NUMBER: 1-0101-BGAD-F205-001

SHEET 1 OF 1

FILE PATH: \\192.168.0.226\r-data\Projects\2021\21-0107-015\Dwg\Struct\
FILE NAME: 1-0101-BGAD-F205-001.dwg