
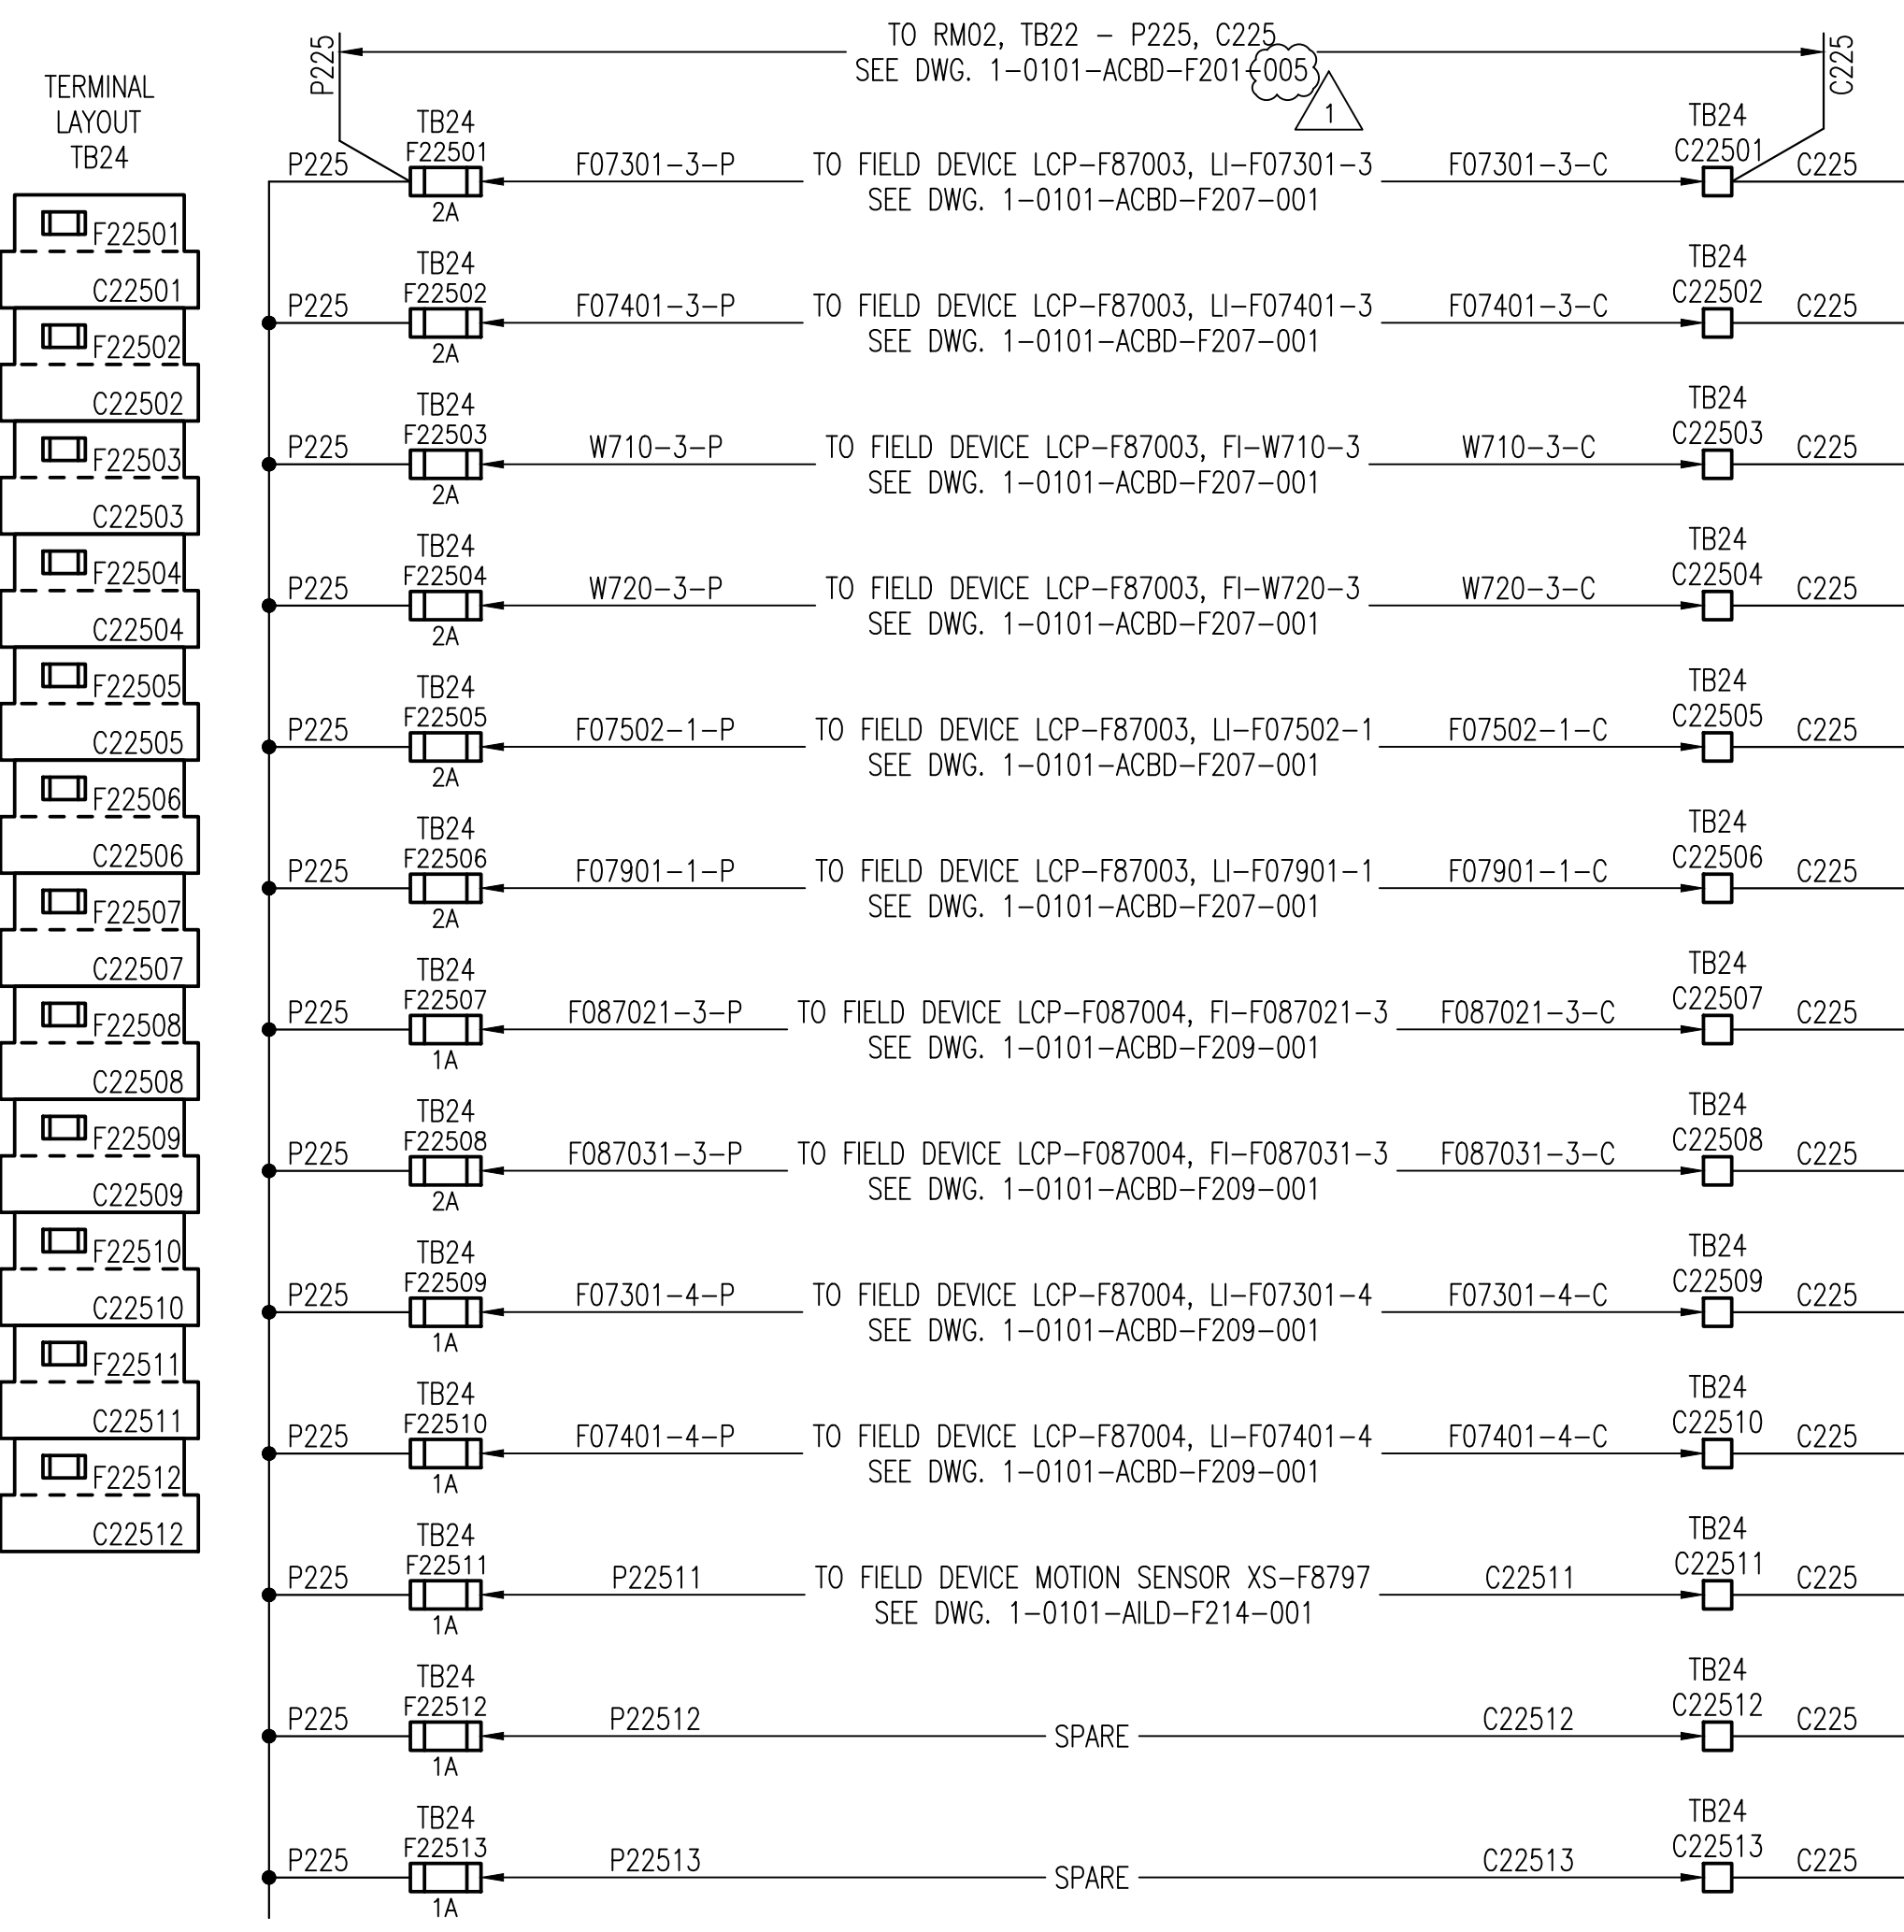


GENERAL NOTES:

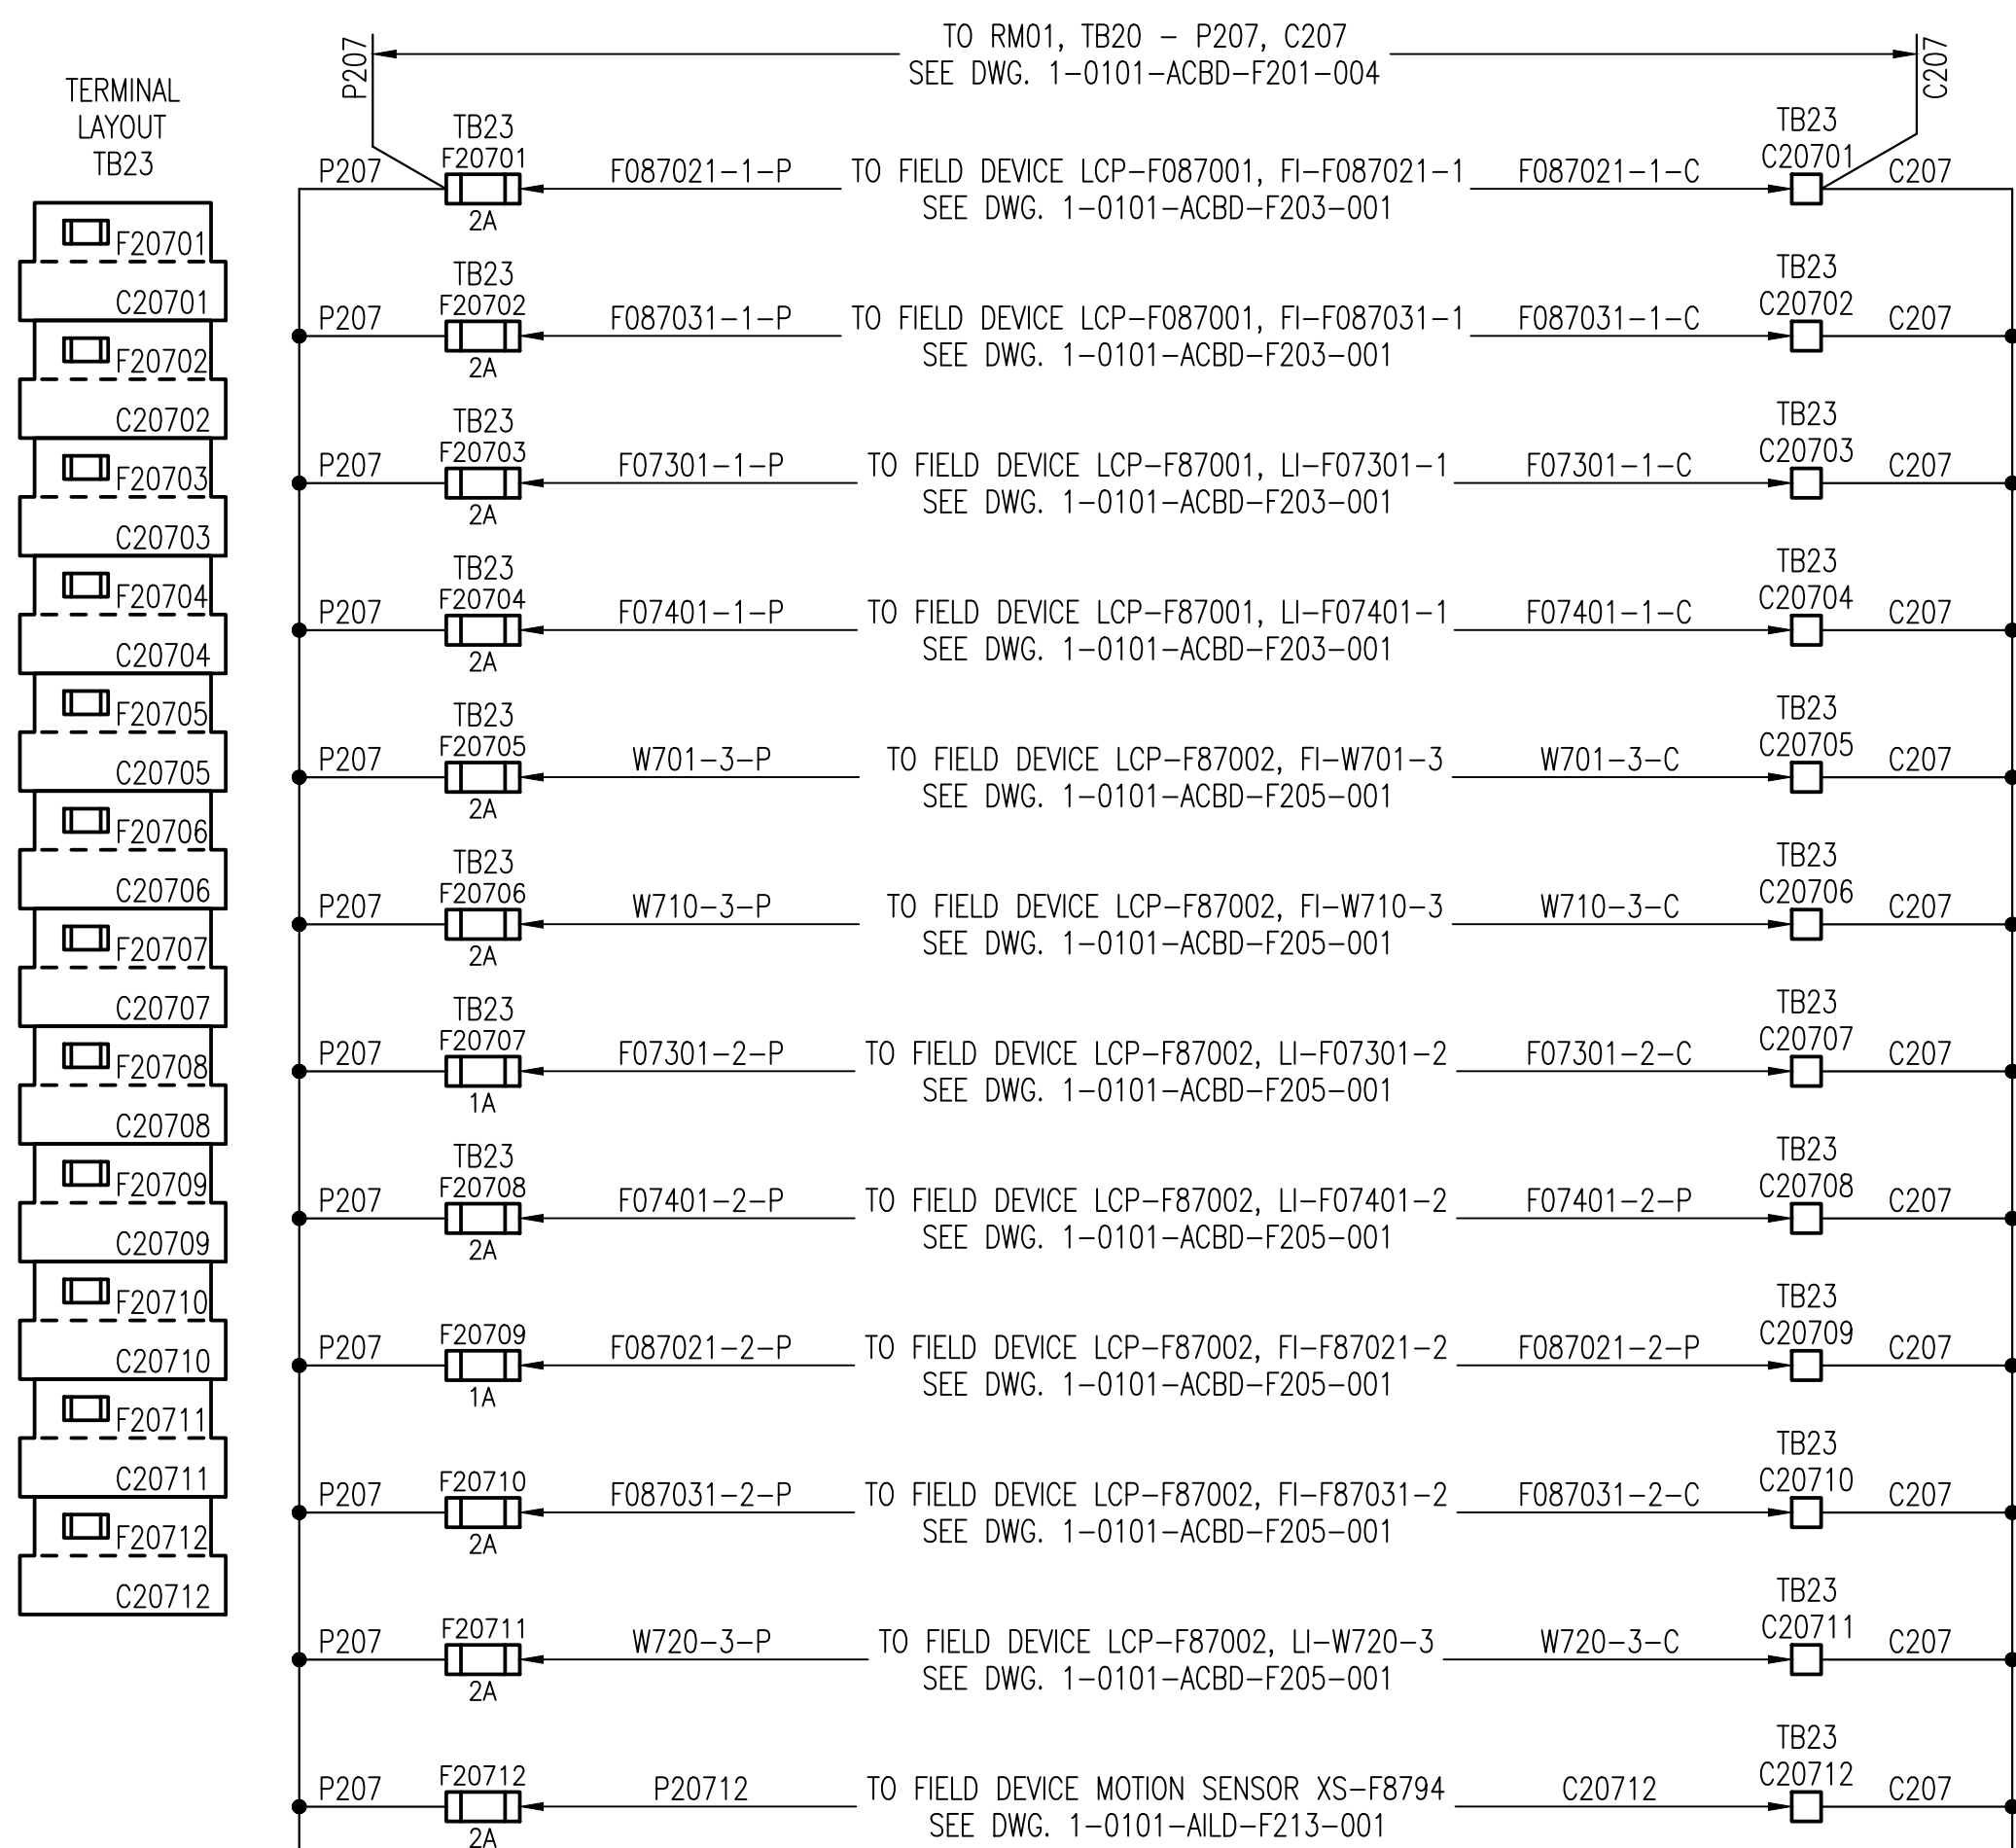

FUSE SCHEDULE			
TB	IDENTIFIER	SIZE	RATING
TB23	F20701	5x20mm	2A TD
	F20702	5x20mm	2A TD
	F20703	5x20mm	2A TD
	F20704	5x20mm	2A TD
	F20705	5x20mm	2A TD
	F20706	5x20mm	2A TD
	F20707	5x20mm	1A FA
	F20708	5x20mm	2A TD
	F20709	5x20mm	1A FA
	F20710	5x20mm	2A TD
	F20711	5x20mm	2A TD
	F20712	5x20mm	2A TD
TB24	F22501	5x20mm	2A TD
	F22502	5x20mm	2A TD
	F22503	5x20mm	2A TD
	F22504	5x20mm	2A TD
	F22505	5x20mm	2A TD
	F22506	5x20mm	2A TD
	F22507	5x20mm	1A FA
	F22508	5x20mm	1A FA
	F22509	5x20mm	1A FA
	F22510	5x20mm	1A FA
F22511	5x20mm	1A FA	
F22512	5x20mm	1A FA	

NOTES
 FA = FAST ACTING
 TD = TIME DELAY

10	-	-
9	-	-
8	-	-
7	-	-
6	-	-
5	-	-
4	-	-
3	-	-
2	-	-
1	-	-
NO.	DRAWING NUMBER	REFERENCE DRAWING TITLE
REFERENCE DRAWINGS		



B.M. ELEV.	
CONSTRUCTION COMPLETION DATE: YYYY MM DD	
DESIGNED BY	DG
CHECKED BY	JAB
DRAWN BY	RG
APPROVED BY	JAB
SCALE:	NTS
RELEASED FOR CONSTRUCTION	
NO.	REVISIONS
1	RE-ISSUED FOR CONSTRUCTION 2022 07 05 JAB
0	ISSUED FOR CONSTRUCTION 2022 05 18 JAB
DATE	2022 04 24
DATE	2022 07 12

KGS GROUP

ENGINEER'S SEAL

CONSULTANT DRAWING NUMBER: 21-0107-015_A5.133

THE CITY OF WINNIPEG
 WATER AND WASTE DEPARTMENT
 ENGINEERING DIVISION

Winnipeg

NORTH END SEWAGE TREATMENT PLANT (NEWPC)
 INTERIM PHOSPHOROUS REMOVAL
 AUTOMATION - POWER DISTRIBUTION SCHEMATIC

BUILDING 101
 RIO-F8000-1 POWER DISTRIBUTION SCHEMATIC

CITY DRAWING NUMBER: 1-0101-ACBD-F213-001

SHEET 4 OF 14