


LAST SAVE: 2022/07/14 - 11:00am
 PATH: \\192.168.0.226\p-data\Projects\2021\21-0107-015\Dwg\Elec\ADDENDUM\1-0101-AILD-F228-001.DWG
 B SIZE - 279mm x 432mm

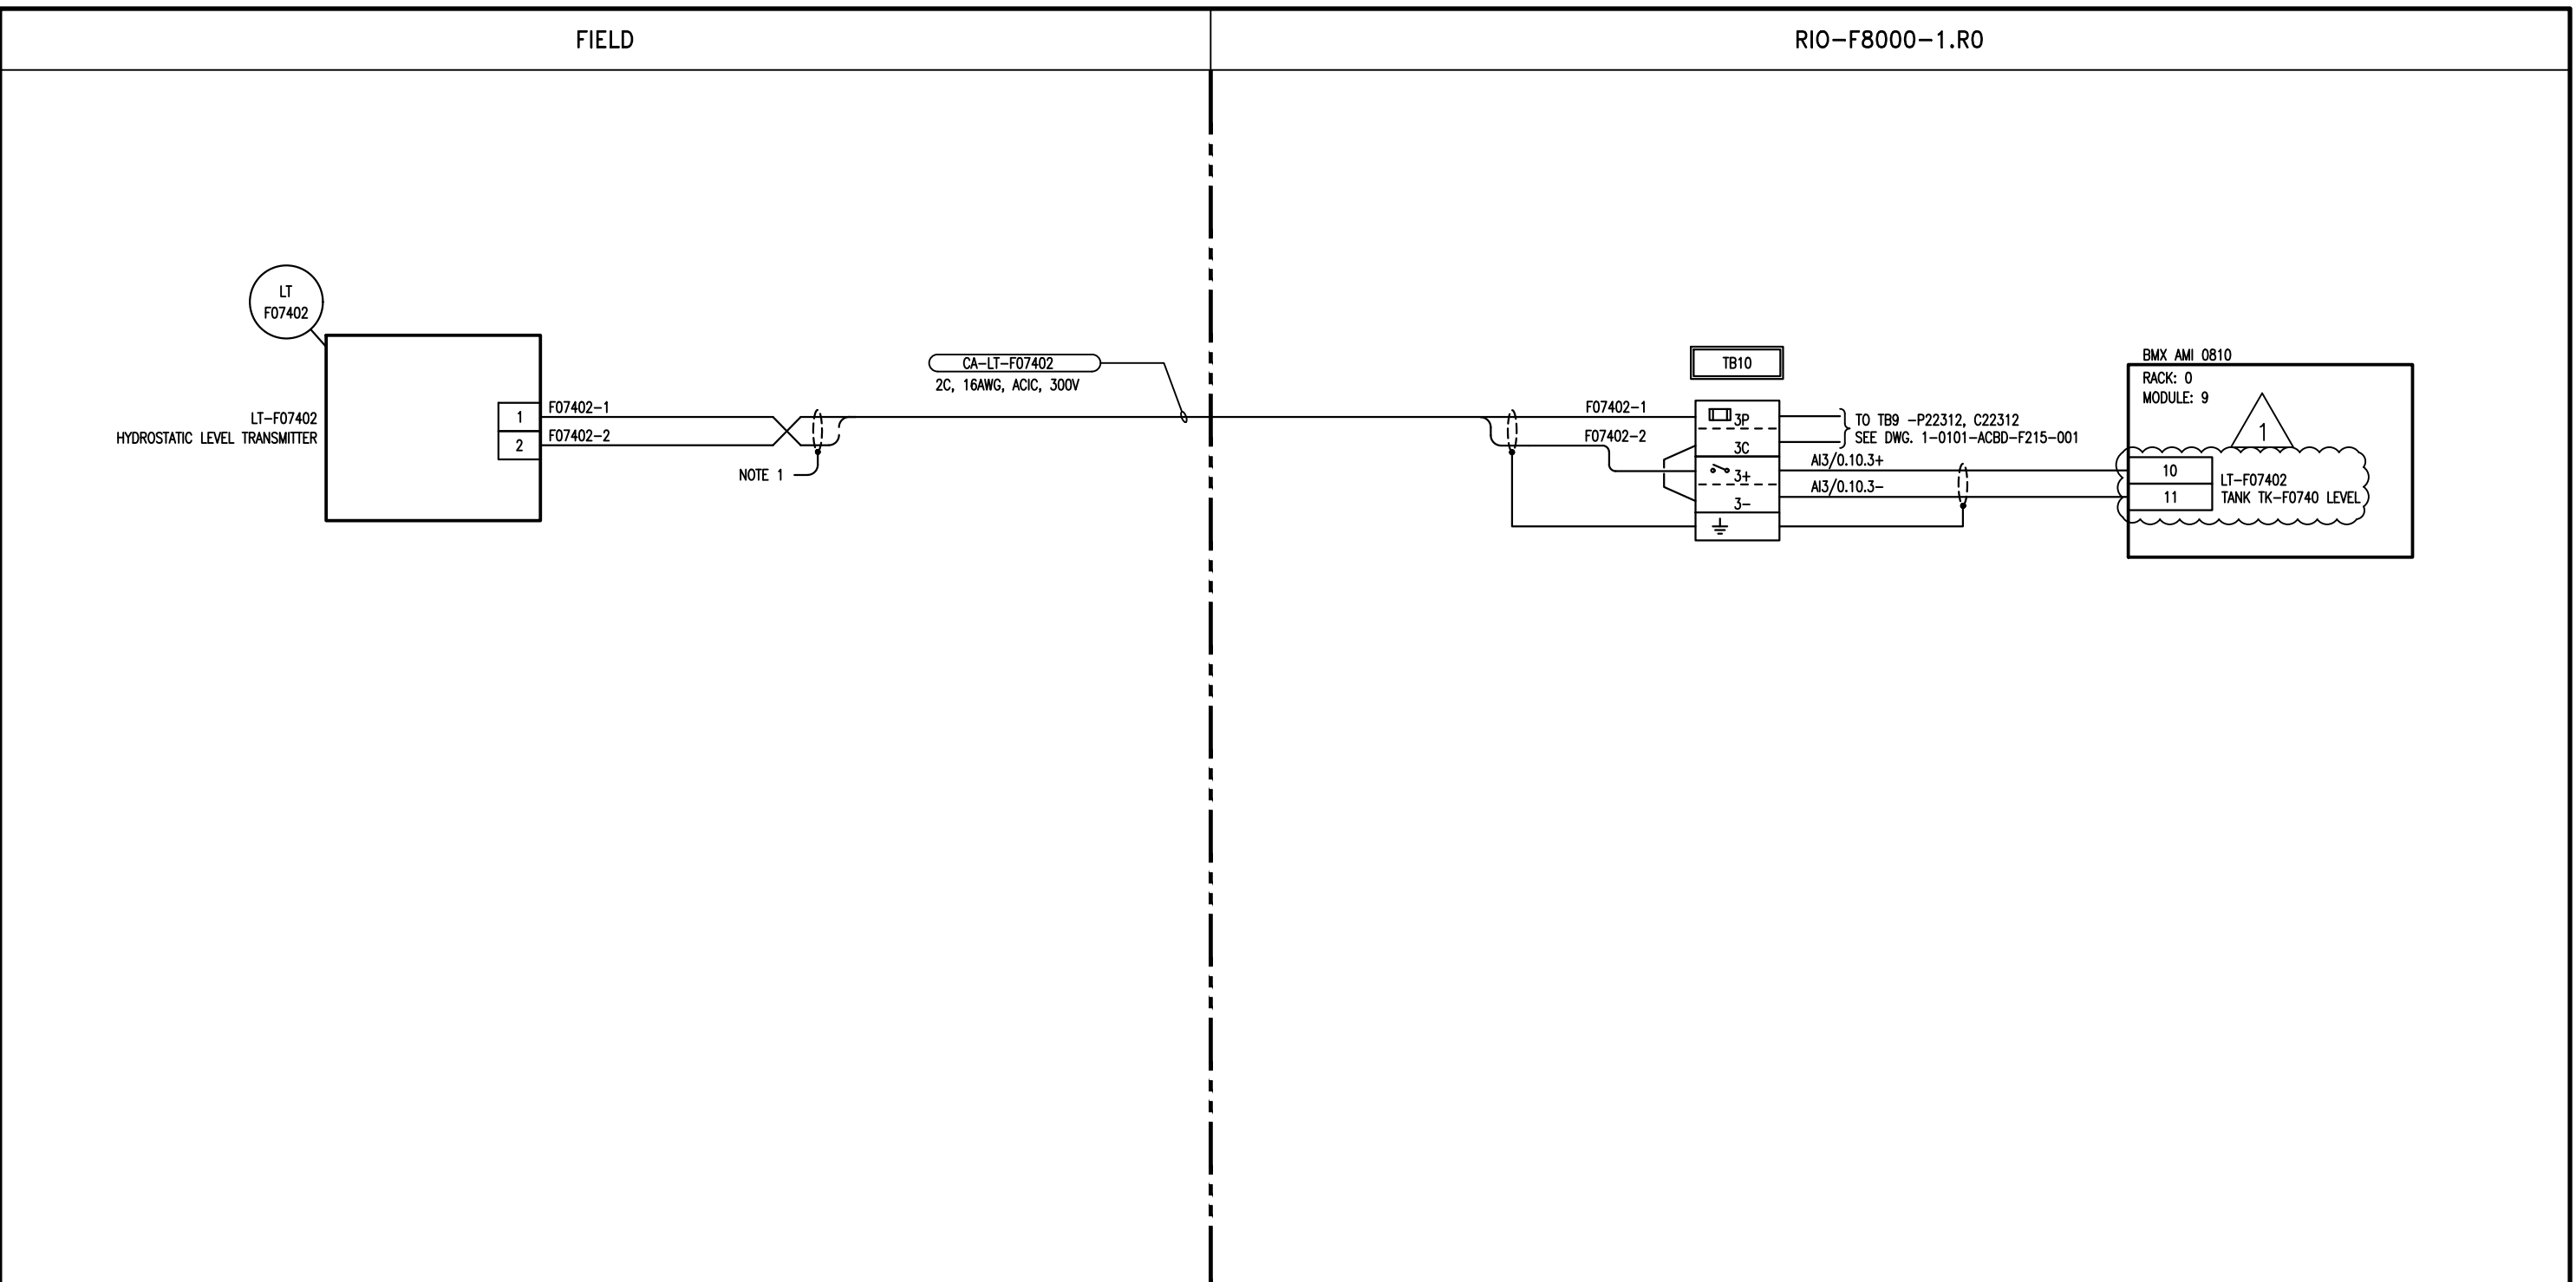

NOTES
 1. ISOLATE AND TAPE BACK SHIELD AT THIS END ONLY.

**ENGINEERS
 GEOSCIENTISTS
 MANITOBA**

Certificate of Authorization

KGS Group

No. 245

NO.	REVISIONS	DATE	DESIGN	CHECK
1	RE-ISSUED FOR CONSTRUCTION	2022 07 05	DRS	<i>JAB</i>
0	ISSUED FOR CONSTRUCTION	2022 05 18	DG	JAB

DESIGNED BY: DG	CHECKED BY: JAB
DRAWN BY: RG	APPROVED BY: JAB
SCALE: NTS	DATE:
ISSUED FOR CONSTRUCTION	
BY:	DATE:
CONSULTANT NO.: 21-0107-015_A6.134	

ENGINEER'S SEAL

THE CITY OF WINNIPEG
 WATER AND WASTE DEPARTMENT
 ENGINEERING DIVISION

NORTH END SEWAGE TREATMENT PLANT (NEWPC)
 INTERIM PHOSPHOROUS REMOVAL
 BUILDING 101
 AUTOMATION - LOOP DRAWING
 LT-F07402 HYDROSTATIC LEVEL TRANSMITTER

CITY DRAWING NUMBER	SHEET	REV.	SIZE
1-0101-AILD-F228-001	001	1	B