


LAST SAVE: 2022/07/14 - 10:59am
 PATH: \\192.168.0.226\p-data\Projects\2021\21-0107-015\Dwg\Elec\ADDENDUM\1-0101-AILD-F250-001.DWG
 B SIZE - 279mm x 432mm

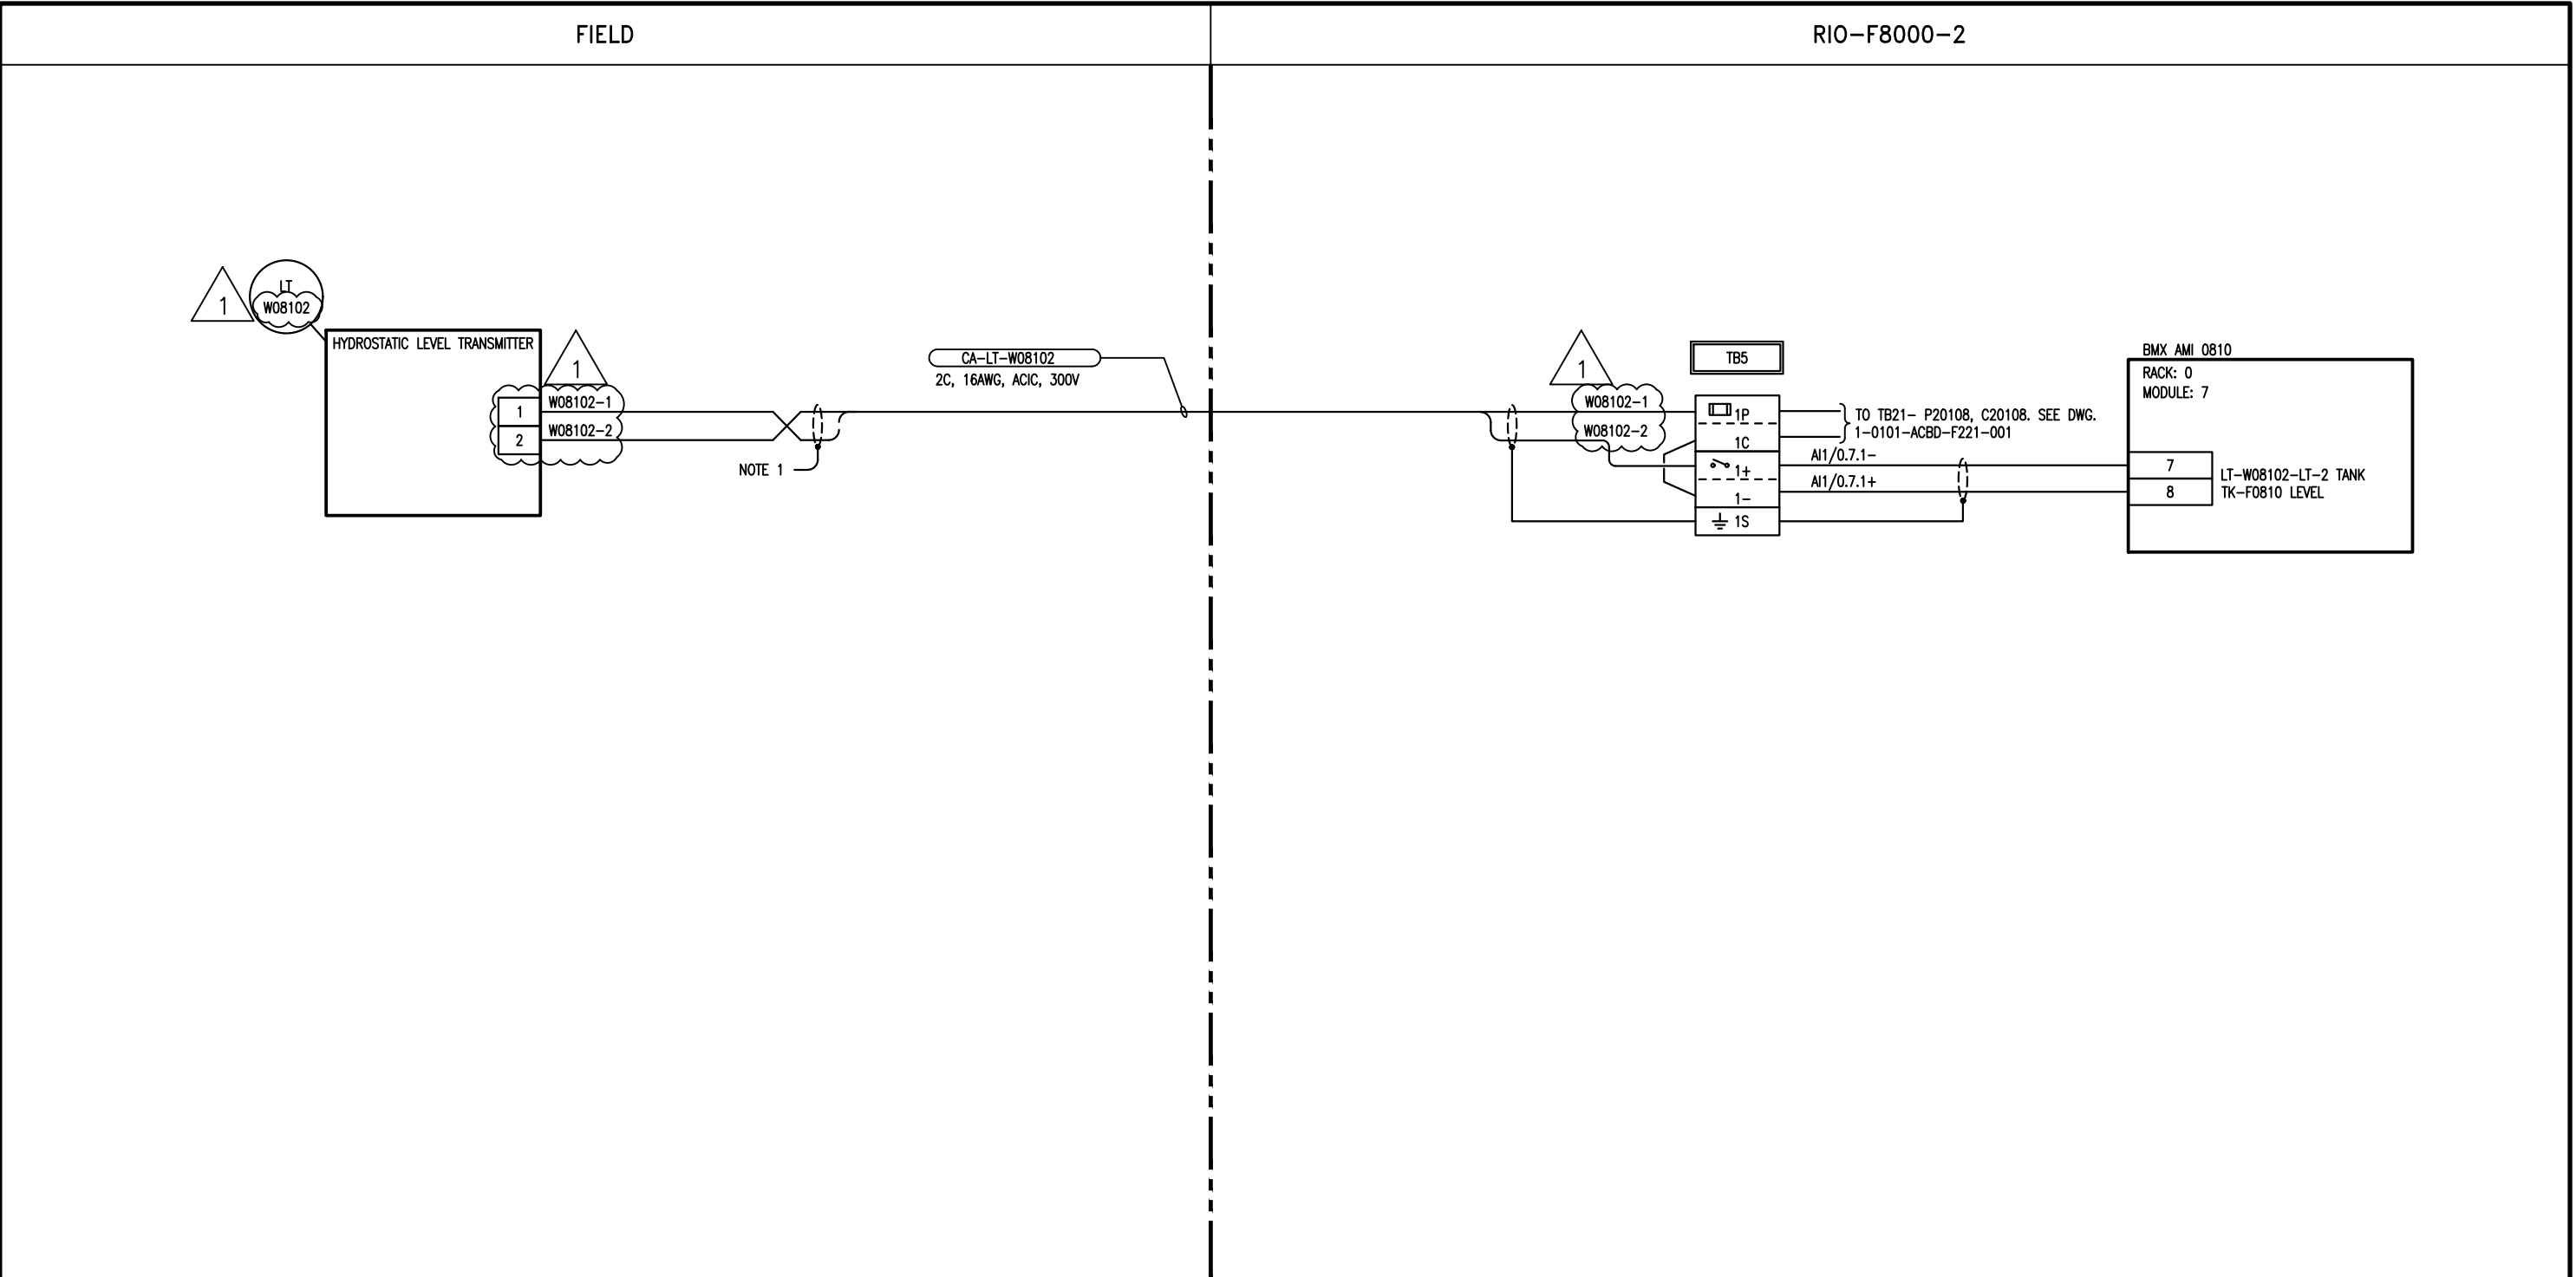

NOTES

1. ISOLATE AND TAPE BACK SHIELD AT THIS END ONLY.

**ENGINEERS
GEOSCIENTISTS
MANITOBA**

Certificate of Authorization

KGS Group

No. 245

NO.	REVISIONS	DATE	DESIGN	CHECK
0	ISSUED FOR CONSTRUCTION	2022 05 18		<i>JAC</i>

KGS GROUP

DESIGNED BY: DG	CHECKED BY:
DRAWN BY: RG	APPROVED BY:
SCALE: NTS	DATE: 2022 05 18
ISSUED FOR CONSTRUCTION	
BY: E. CAMPBELL	DATE: 2022 05 18
CONSULTANT NO.: 21-0107-015_A6.218	

ENGINEER'S SEAL

THE CITY OF WINNIPEG
WATER AND WASTE DEPARTMENT
ENGINEERING DIVISION

NORTH END SEWAGE TREATMENT PLANT (NEWPCC)
INTERIM PHOSPHOROUS REMOVAL
BUILDING 102
AUTOMATION - LOOP DRAWING
LT-W08102 HYDROSTATIC LEVEL TRANSMITTER

CITY DRAWING NUMBER	SHEET	REV.	SIZE
1-0101-AILD-F250-001	001	1	B