


GENERAL NOTES:

1. -

BUILDING/ROOM LEGEND:

- 101A - RAILCAR SHELTER 1 (EXISTING)
- 101B - RAILCAR SHELTER 2 (NEW)
- 101C - FERRIC CHLORIDE CHEMICAL STORAGE ROOM (NEW)
- 101D - NEW ELECTRICAL ROOM

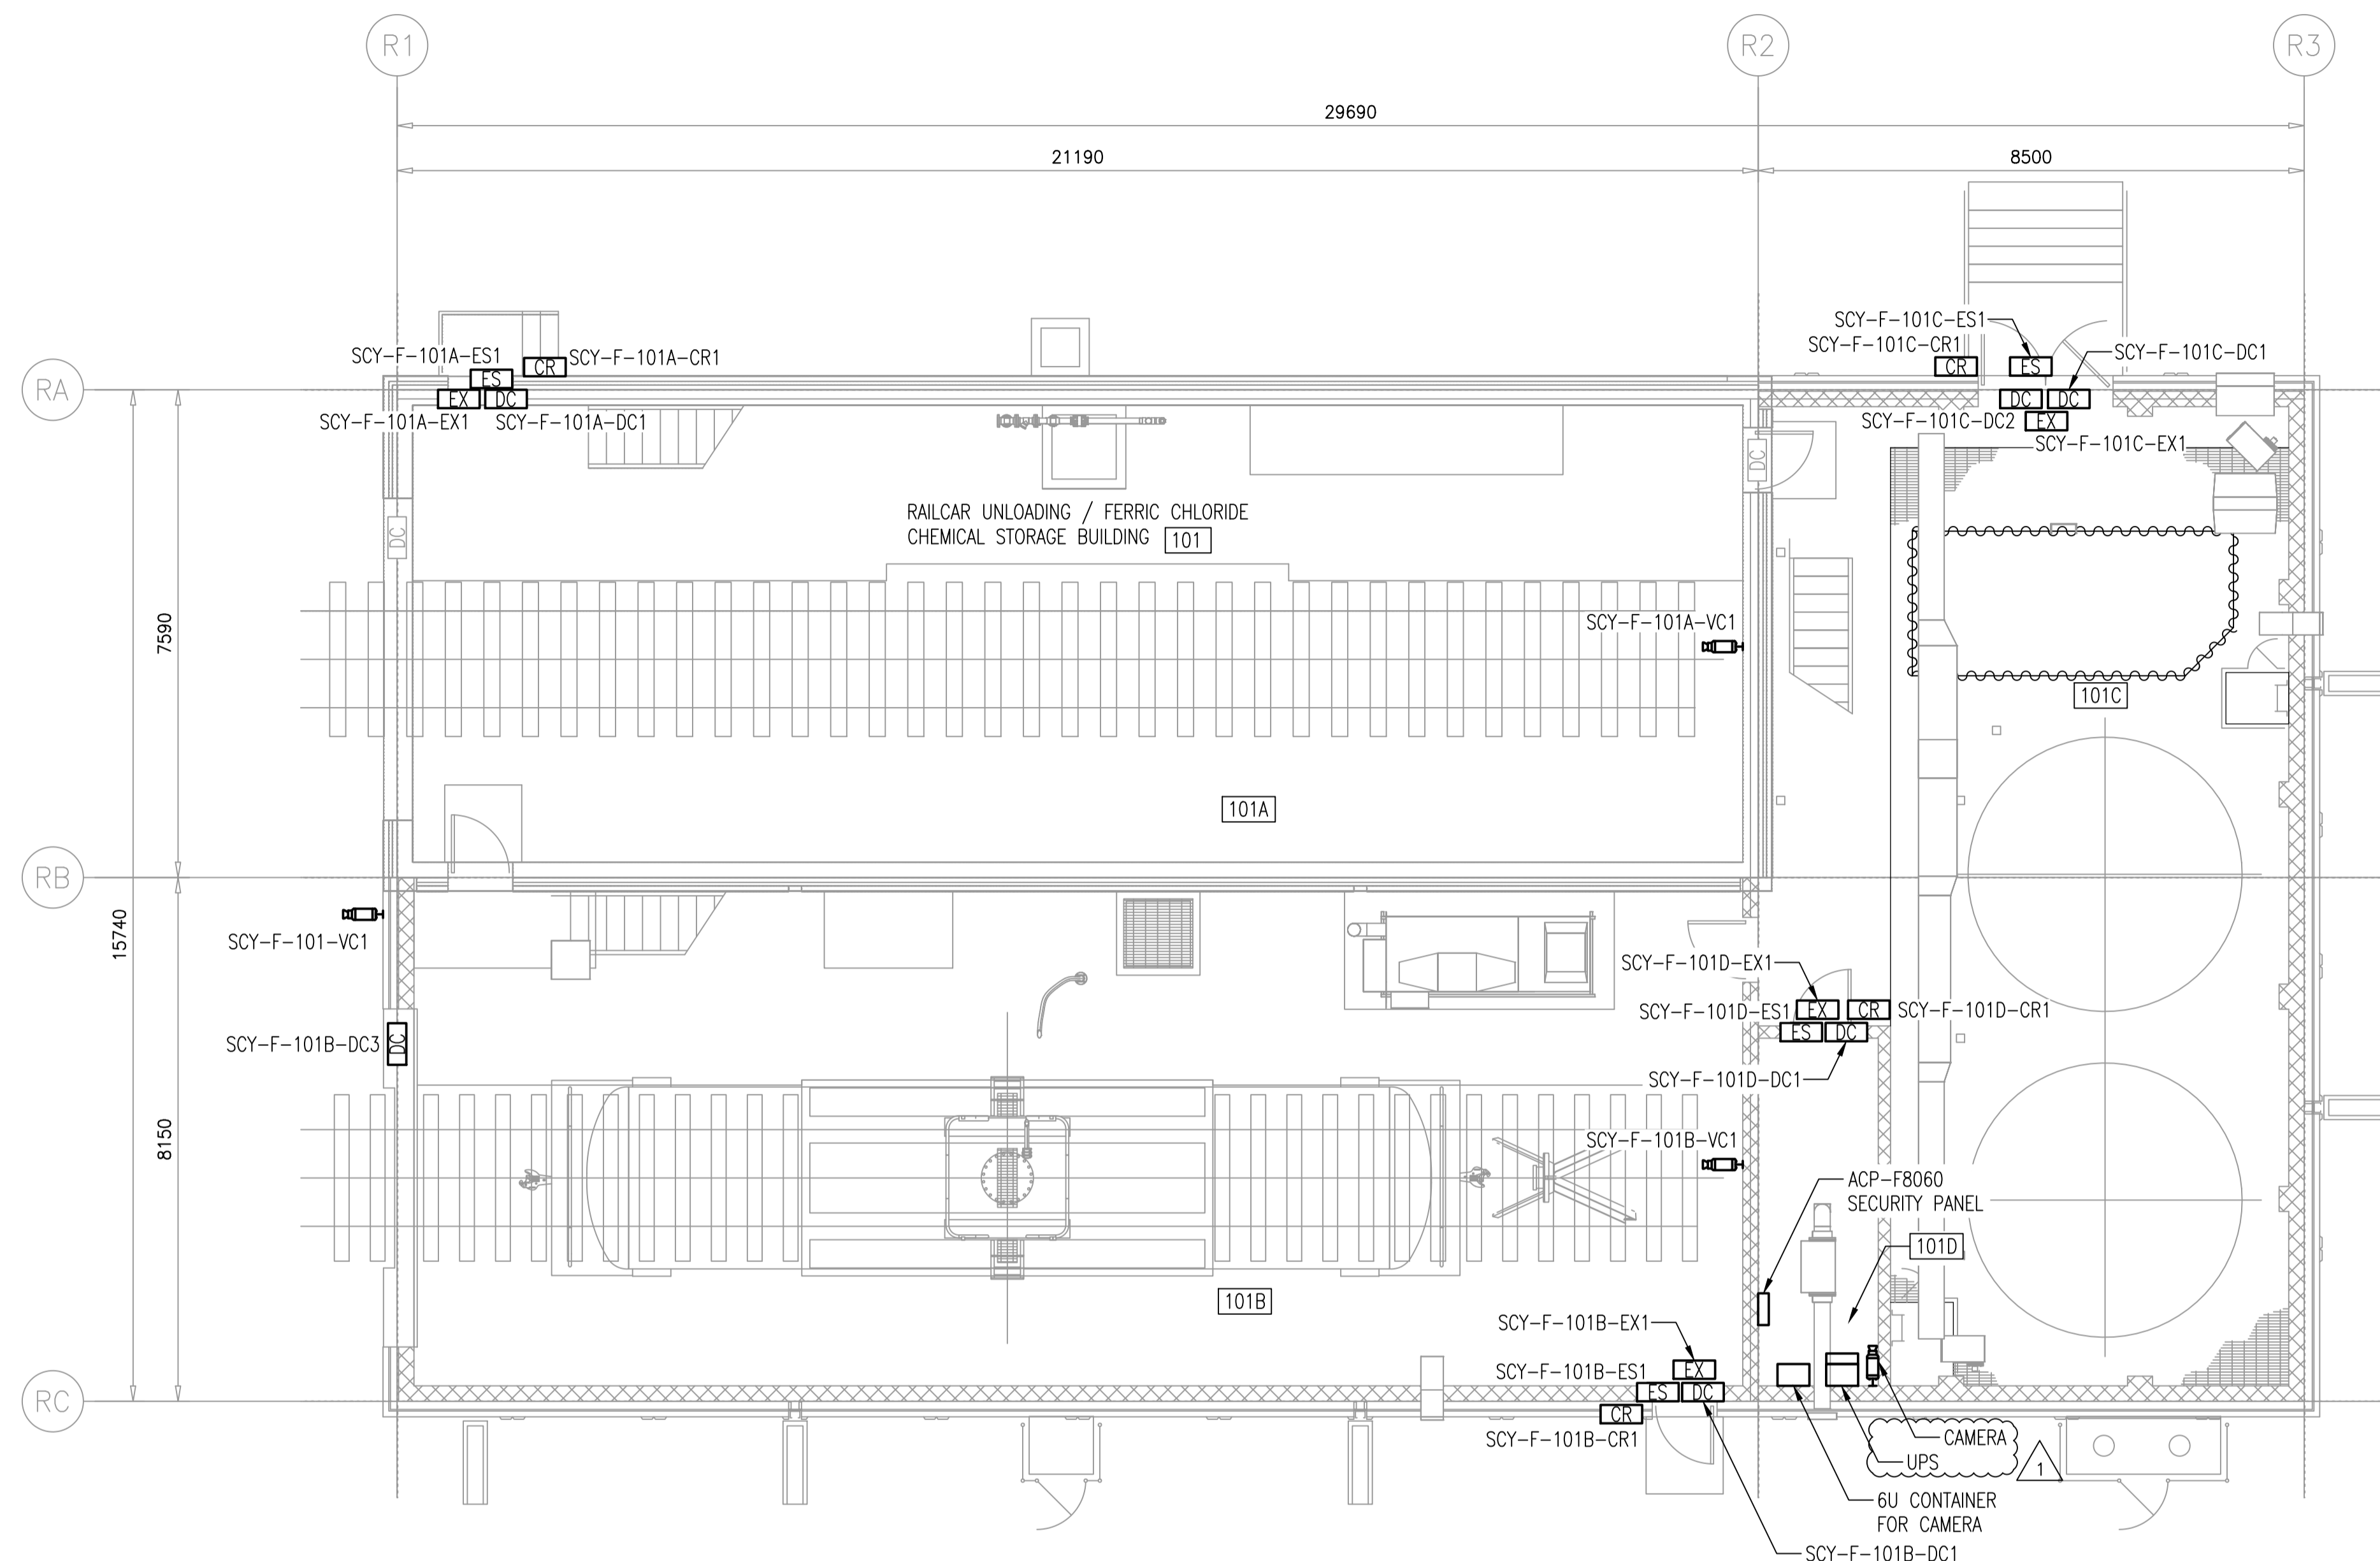

**A**  
REF.1  
**PLAN - MAIN FLOOR**  
SCALE: 1:75mm (24"x36")

10	-	-
9	-	-
8	-	-
7	-	-
6	-	-
5	-	-
4	-	-
3	-	-
2	-	-
1	-	-
NO.	DRAWING NUMBER	REFERENCE DRAWING TITLE
REFERENCE DRAWINGS		

B.M. ELEV.			
CONSTRUCTION COMPLETION DATE: YYYY MM DD			
NO.	REVISIONS	DATE	BY
1	RE-ISSUED FOR CONSTRUCTION	2022 07 05	JAB
0	ISSUED FOR CONSTRUCTION	2022 05 18	JAB

<b>KGS GROUP</b>			
DESIGNED BY	DG	CHECKED BY	JAB
DRAWN BY	RG	APPROVED BY	JAB
SCALE:	AS SHOWN		
DATE	DATE		

ENGINEER'S SEAL
CONSULTANT DRAWING NUMBER
21-0107-015_E2.141

	<b>THE CITY OF WINNIPEG</b> WATER AND WASTE DEPARTMENT ENGINEERING DIVISION	
	NORTH END SEWAGE TREATMENT PLANT (NEWPCC) INTERIM PHOSPHOROUS REMOVAL ELECTRICAL <b>BUILDING 101</b> <b>SECURITY CAMERA LAYOUT</b>	
CITY DRAWING NUMBER	1-0101-ESCY-F201-001	SHEET 1 OF 1