




**NORTH MECHANICAL ROOM PLAN**  
SCALE 1:50

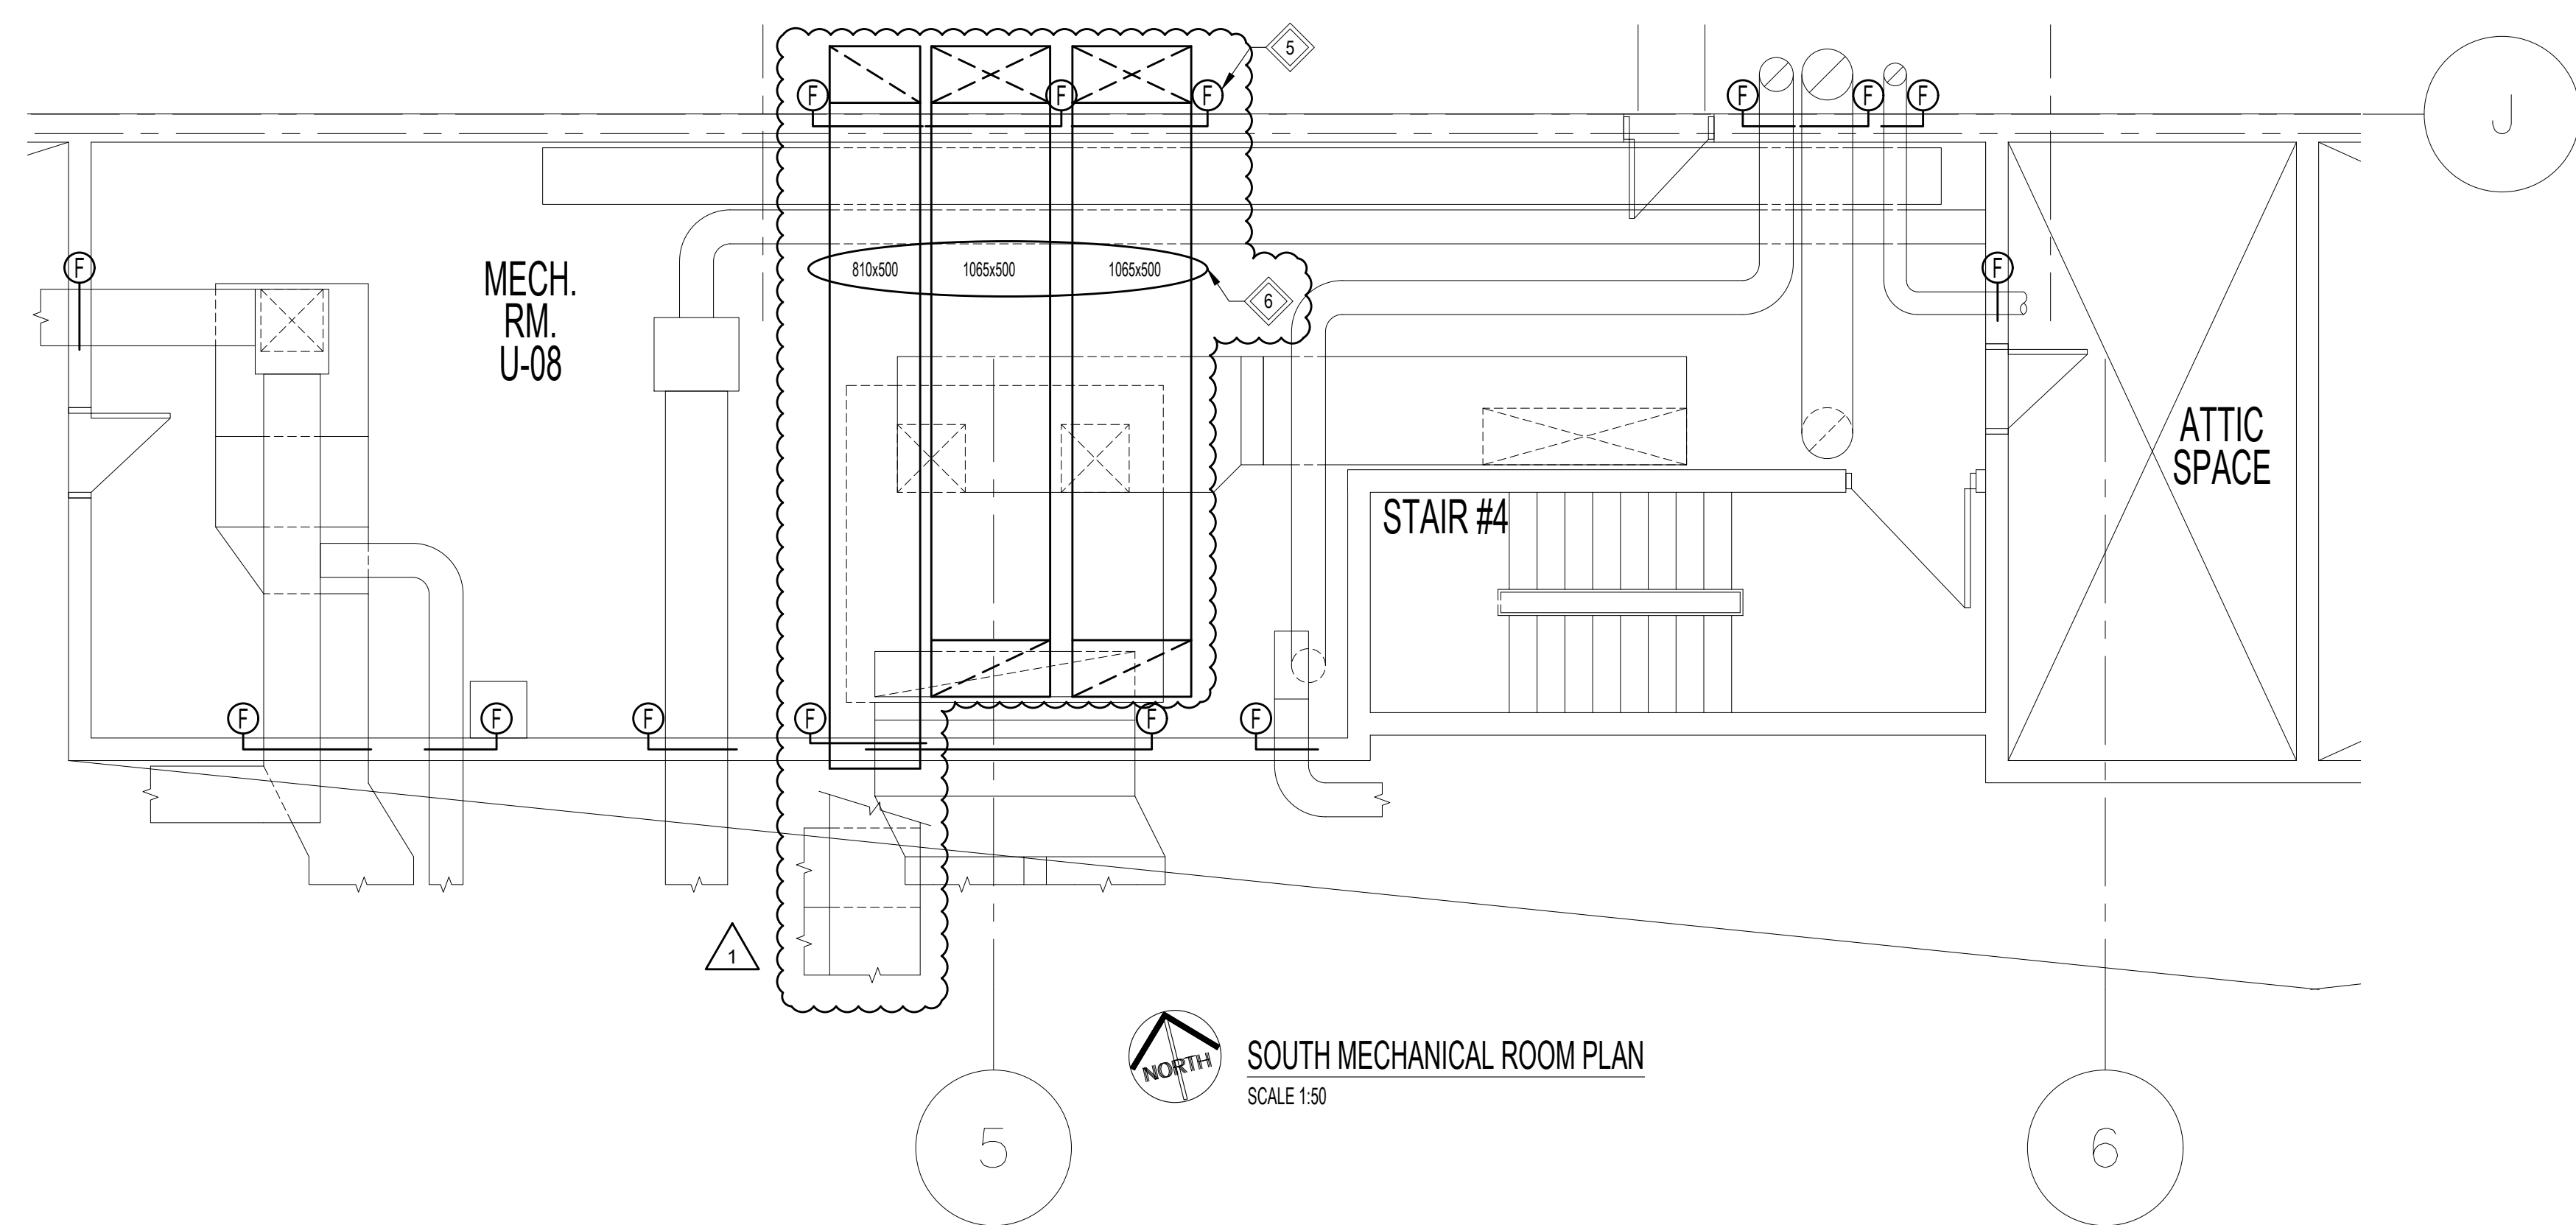


**SOUTH MECHANICAL ROOM PLAN**  
SCALE 1:50

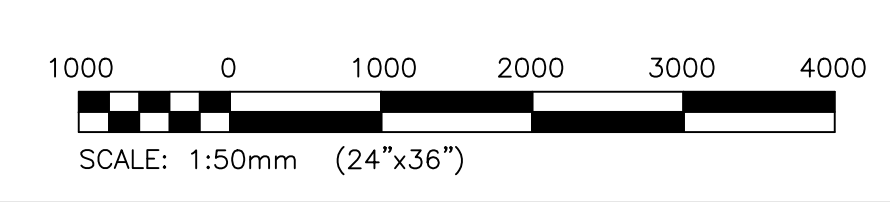

SCALE VERIFIED BY: \_\_\_\_\_

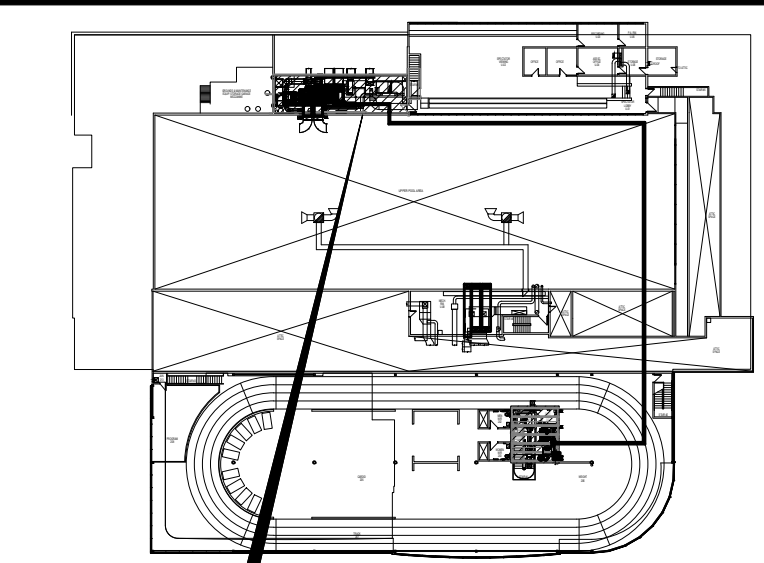

**THIS DRAWING**

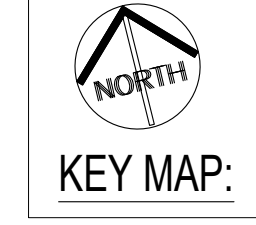

**KEY MAP:**

**KEYNOTES:**

- 1 REMOVE/INSTALL EXISTING DUCT AS REQUIRED TO FACILITATE CONSTRUCTION. PROVIDE NEW DUCT SUPPORTS AS REQUIRED. MODIFY DUCT WHERE REQUIRED TO SUIT.
- 2 CONNECT NEW DUCTWORK EXISTING OUTDOOR AIR DUCTWORK. PROVIDE DUCT INSULATION.
- 3 PROVIDE NEW RETURN AIR DUCTWORK AS SHOWN. CONNECT TO EXISTING RETURN AIR DUCTWORK. PROVIDE NEW FIRE DAMPERS.
- 4 PROVIDE NEW SUPPLY AIR DUCTWORK AS SHOWN. CONNECT TO EXISTING SUPPLY AIR DUCT.
- 5 REPLACE EXISTING FIRE DAMPERS. PROVIDE DUCT MODIFICATIONS AS REQUIRED TO FACILITATE WORK (FILL AND REPAIR EXISTING CONCRETE BLOCK AROUND THE FIRE DAMPERS AS REQUIRED. (TYP.))
- 6 EXISTING DUCTWORK WILL BE REMOVED BY OTHERS FOR ASBESTOS ABATEMENT. NEW DUCTWORK TO BE PROVIDED BY THIS CONTRACT TO RESTORE THE REMOVED PORTIONS C/W NEW FIRE DAMPERS AND DAMPER ACCESS DOORS. (TYP.)

**NOTES:**

THESE DRAWINGS SHALL NOT BE SCALED.

THE CONTRACTOR SHALL VISIT THE SITE AND SATISFY ONESELF ALL DIMENSIONS, DATUM, AND DETAILED INFORMATION SHOWN ARE CORRECT.

THE CONTRACTOR IS TO REVIEW AND COORDINATE ALL ARCHITECTURAL, MECHANICAL, ELECTRICAL AND STRUCTURAL DRAWINGS FOR ADDITIONAL OPENINGS THROUGH FLOORS, WALLS, AND CEILINGS FOR DUCT, PIPE & ELECTRICAL RISERS AND ALL OPENINGS NOT SHOWN ON DRAWINGS.

ALL OPENINGS THROUGH THE FIRE SEPARATIONS AS A RESULT OF THE WORK OF THIS CONTRACT ARE TO BE FIRE STOPPED AND SEALED WITH ULC APPROVED FIRE STOPPING TO MAINTAIN THE INTEGRITY OF THE FIRE SEPARATION, AND PROVIDE AND SMOKE-TIGHT BARRIER.

ALL PRODUCTS AND MATERIALS TO BE USED AND INSTALLED SHALL CONFORM WITH MANUFACTURER'S SPECIFICATIONS & APPLICABLE CODES.

THE CONTRACTOR SHALL BE RESPONSIBLE TO PATCH AND MAKE GOOD ALL EXISTING CONSTRUCTION AFFECTED BY THE REMOVAL OF ALL ITEMS FORMING THE PART OF THE RENOVATION WORK.

WHERE NEW FLOORING AND BASE IS TO BE INSTALLED IN EXISTING AREAS (REFER TO FLOOR PLAN AND ROOM SCHEDULE) THE EXISTING FLOORING SURFACE AND BASE MUST BE REMOVED, UNLESS OTHERWISE NOTED. ALL FLOOR SURFACES SHALL BE PREPARED IN ACCORDANCE TO MANUFACTURER'S RECOMMENDATIONS FOR INSTALLATION OF NEW FLOOR.

WHERE PAINTING OF EXISTING WALLS IS INDICATED ON THE ROOM SCHEDULE, THESE WALLS MUST BE CLEANED OF ANY EXISTING WALL COVERING, PATCHED & PREPARED TO ACCEPT NEW MATERIAL, UNLESS OTHERWISE NOTED.

**GENERAL NOTES:**

- 1. SEE DRAWING M00 FOR GENERAL NOTES.

No.	REVISION/DESCRIPTION	BY	DATE
1	RE-ISSUED FOR CONSTRUCTION		22.04.12
0	ISSUED FOR CONSTRUCTION	PSS	22.03.18

DRAWN	ML	PS	BP	PSS
CHECKED				
DATE 20.08.18	USER APPROVAL			

**Winnipeg** THE CITY OF WINNIPEG  
PLANNING, PROPERTY AND  
DEVELOPMENT DEPARTMENT  
MUNICIPAL ACCOMMODATIONS DIVISION  
3-65 GARRY STREET, R3C 4K4

**PROJECT**  
REPLACEMENT OF AIR HANDLING UNIT AH-1  
CINDY KLASSEN RECREATION  
COMPLEX POOL  
999 SARGENT AVENUE

**SHEET TITLE**  
MECHANICAL  
NORTH MECHANICAL ROOM  
NEW VENTILATION

**SCALE** AS SHOWN **PROJECT No:** 20-0107-009 **SHEET No:** M03

