

CONSTRUCTION BELOW/BEHIND BENCH

19 mm MARINE GRADE PLYWOOD
FOIL VAPOUR BARRIER

16 mm GYPSUM BOARD
50 mm SEMI-RIGID INSULATION
WOOD STUD FRAMING TO SUIT

400 mm O.C.
EXISTING CONCRETE BENCH/
EXISTING CMU WALL

SECTION AT DRY SAUNA

NOTE: REFER TO CONTRACT DELETE NO.1

SCALE

© 400 mm O.C.
50 mm SEMI—RIGID INSULATION
125 mm CIP CONCRETE UPSTAND
(REFER TO STRUCTURAL)
MOSAIC TILE FINISH

PROVIDE CONTINUOUS STRIP OF FOIL VAPOUR BARRIER SEALED TO FLOOR UNDER SOLID WOOD BLOCKING. CARRY UP ONTO GYPSUM BOARD MIN. 200 mm (TYPICAL FULL PERIMETER OF SPACE)

MAIN FLOOR _ _ _

SPACE)

- CARRY WALL FOIL VAPOUR BARRIER OVER STRIP & PROVIDE CONTINUOUS SEAL W/ COMPATIBLE MASTIC (TYPICAL FULL PERIMETER OF SPACE)

DETAIL @ WALL

MOSAIC TILE FINISH 125 mm CIP CONCRETE UPSTAND

(REFER TO STRUCTURAL)
MOSAIC TILE FINISH

MAIN FLOOR


ELEV 100 000

BEYOND

PORCELAIN TILE BASE

SECTION AT MPR

NOTE: REFER TO CONTRACT DELETE NO.1

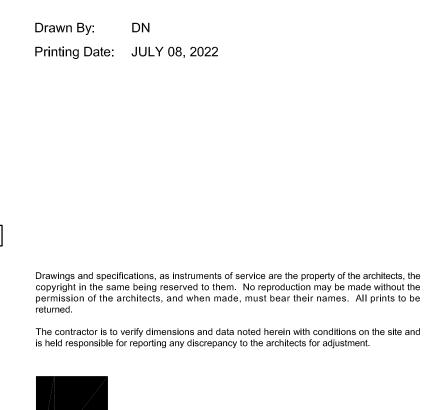

ADDENDUM #01

ISSUED FOR CONSTRUCTION

Issue / Revision

02 08/07/2022

01 21/06/2022

Date



INFILL DETAIL

SCALE

@ EXISTING LOUVRE

CITY OF WINNIPEG BONIVITAL POOL RENEWAL

1215 Archibald St, Winnipeg, MB.

WALL SECTIONS