


CONTINUED FROM DWG E-0003-001

CONTINUED FROM DWG E-0003-001

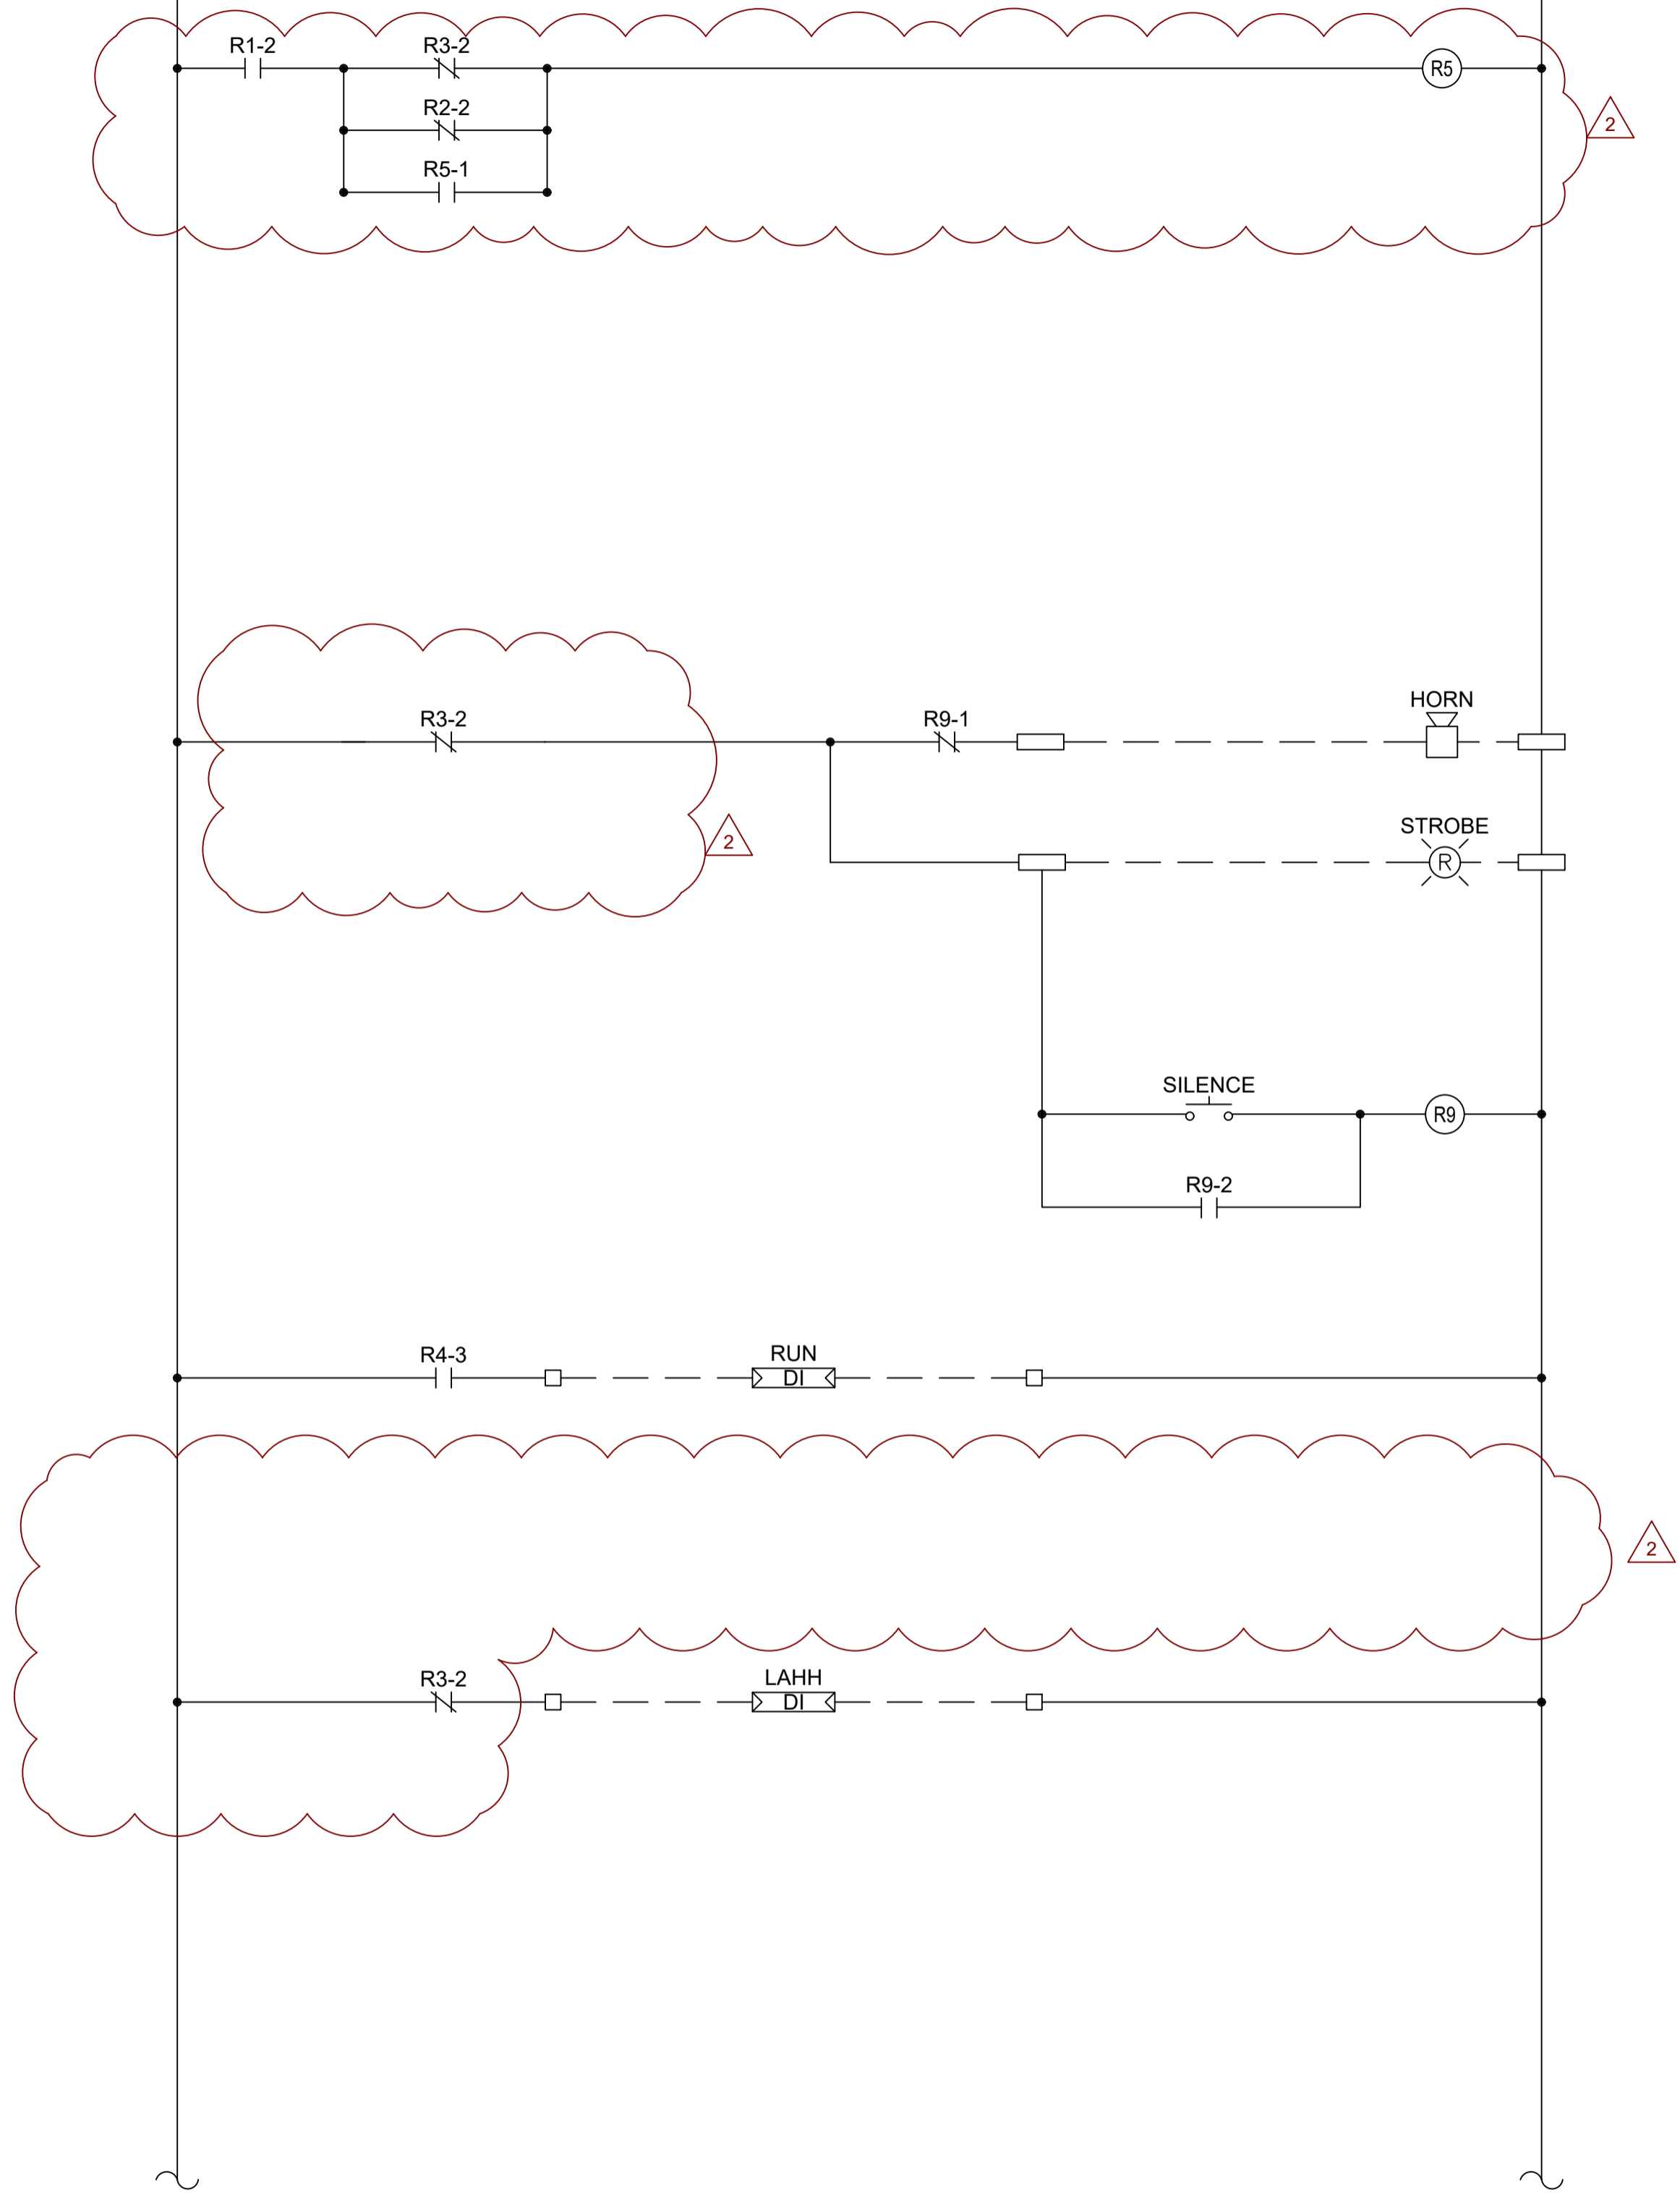

1 SUMP PUMP SCHEMATIC DIAGRAM (TYP) CONTINUED

Scale N.T.S.

ES ENGINEERS GEOSCIENTISTS MANITOBA
 Certificate of Authorization
 AECOM Canada Ltd.
 No. 4671 Date: 2022/09/06

TENDER NO. 640-2022

| NO. | REVISIONS | DATE | DESIGN | CHECK |
|-----|-------------------------|------------|--------|-------|
| 02 | ISSUED FOR ADDENDUM 1 | 2022/09/06 | CR | KG |
| 01 | ISSUED FOR CONSTRUCTION | 2022/08/17 | CR | SS |
| 00 | ISSUED FOR 90% REVIEW | 2022/07/20 | CR | SS |

| | |
|--------------------------|---|
| AECOM | |
| DESIGNED BY: CR | CHECKED BY: SS |
| DRAWN BY: TW | APPROVED BY: MM |
| SCALE: NTS | RELEASED FOR CONSTRUCTION BY: JESSICA McCOMBE |
| DATE: 2022-08-17 | DATE: 2022-08-18 |
| CONSULTANT NO.: E-0003.2 | |



THE CITY OF WINNIPEG
 WATER AND WASTE DEPARTMENT
 ENGINEERING SERVICES DIVISION

WINNIPEG WATER TREATMENT PLANT
 DEACON BOOSTER STATION
 ELECTRICAL
 SUCTION HEADER SPLIT
 SUMP PUMP CONTROL PANEL SCHEMATIC

CITY DRAWING NUMBER: 1-0601D-E0003-002 | SHEET: 012 | REV: 02 | SIZE: A1