




AUTOMATION PLAN - MAIN FLOOR
SCALE: 1:50

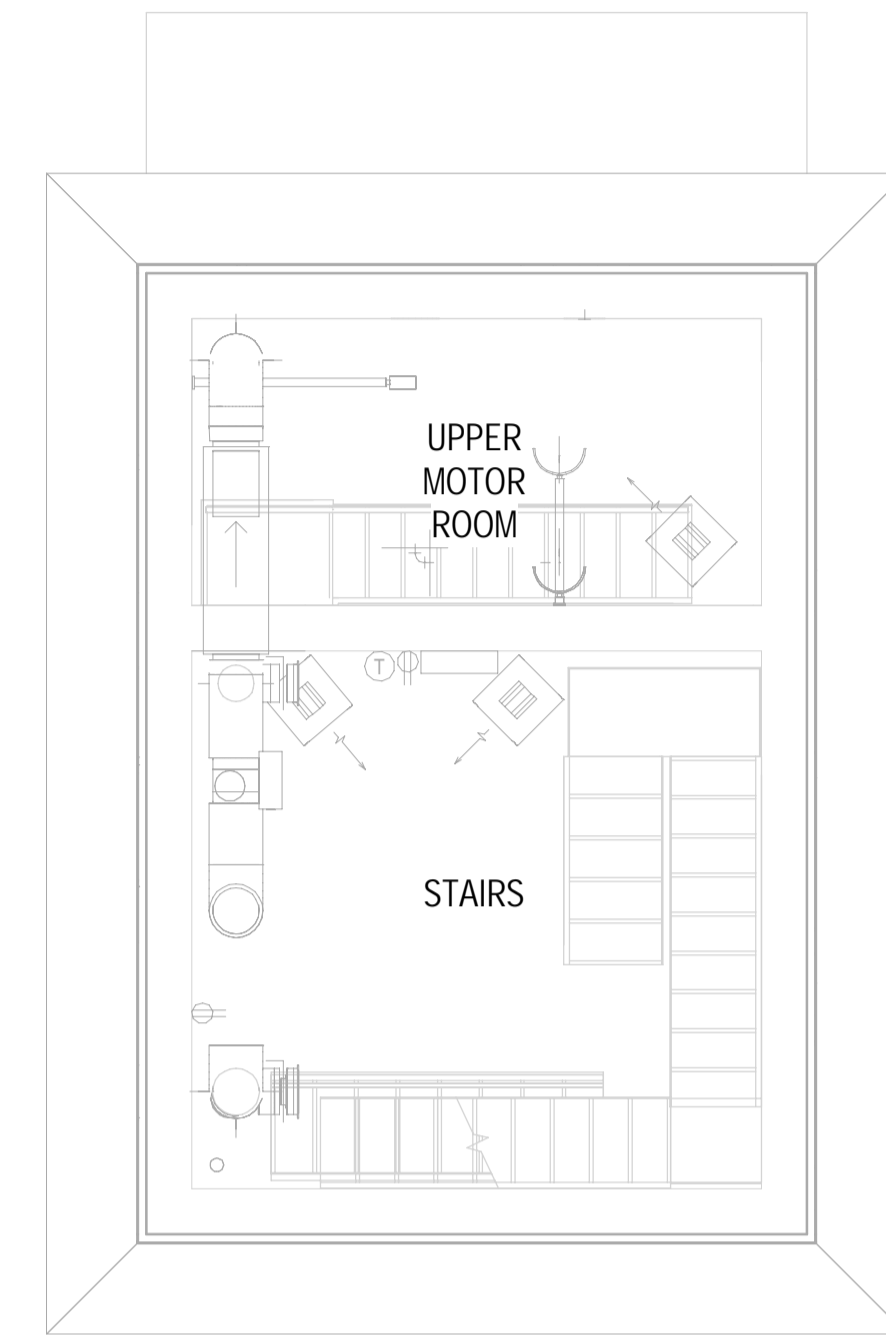

AUTOMATION PLAN - LEVEL 01
SCALE: 1:50

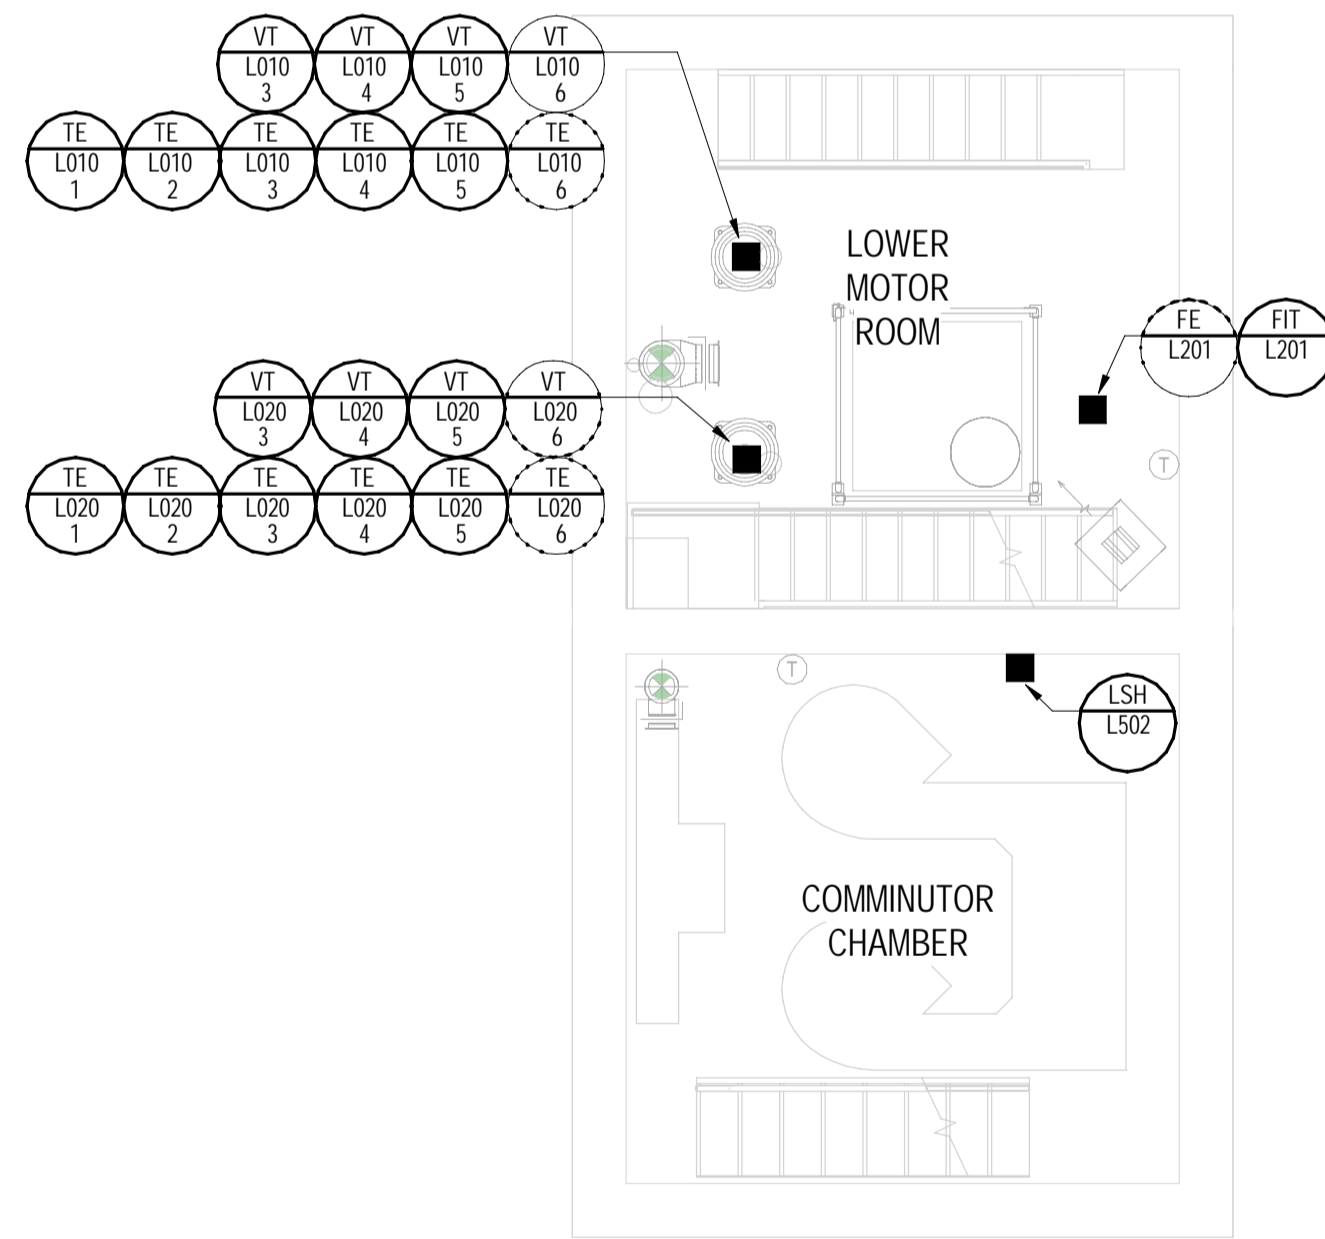

AUTOMATION PLAN - MOTOR ROOM
SCALE: 1:50

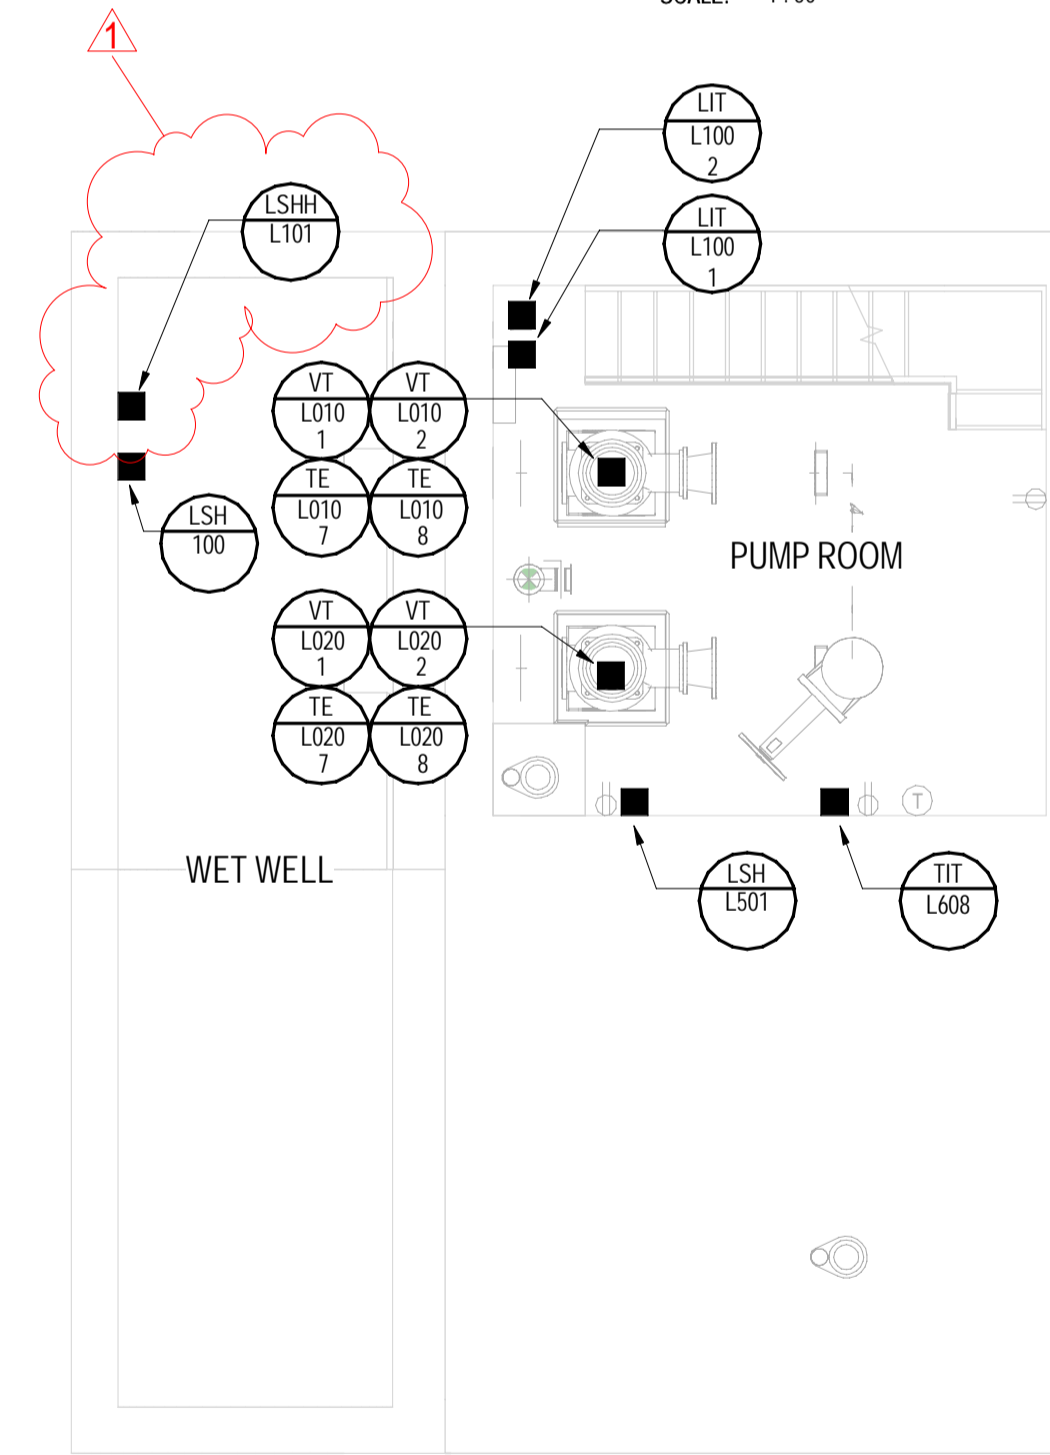


AUTOMATION PLAN - PUMP ROOM
SCALE: 1:50

DRAWING NUMBER	REFERENCE DRAWINGS
----------------	--------------------

NOT FOR CONSTRUCTION

ISSUED FOR TENDER

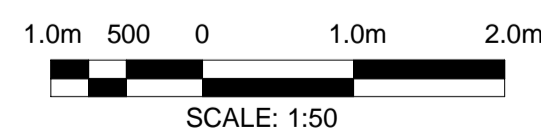

**ENGINEERS
GEOSCIENTISTS
MANITOBA**

Certificate of Authorization
Dillon Consulting Limited (MB)
 No. 1789 Date: _____

NO.	REVISIONS	DATE	DESIGN	CHECK
1	ISSUED FOR ADDENDUM 5	2023/08/10	CAL	-
0	ISSUED FOR TENDER	2023/07/20	CAL	BLM

DILLON CONSULTING	
DESIGNED BY: CAL	CHECKED BY: BLM
DRAWN BY: SK	APPROVED BY: BLM
SCALE: 1:50	RELEASED FOR CONSTRUCTION
DATE: MARCH 2023	BY: _____
CONSULTANT NO: 22-3229	

ENGINEER'S SEAL

ORIGINAL DRAWING
 SEALED BY C. LANGE
 ON JULY 20, 2023

THE CITY OF WINNIPEG
WATER AND WASTE DEPARTMENT

RIVERBEND LIFT PUMPING STATION
 2023 UPGRADES
 AUTOMATION PLAN LAYOUT

CITY DRAWING NUMBER	SHEET	REV.	SIZE
1-0178L-A0001	001	01	A1