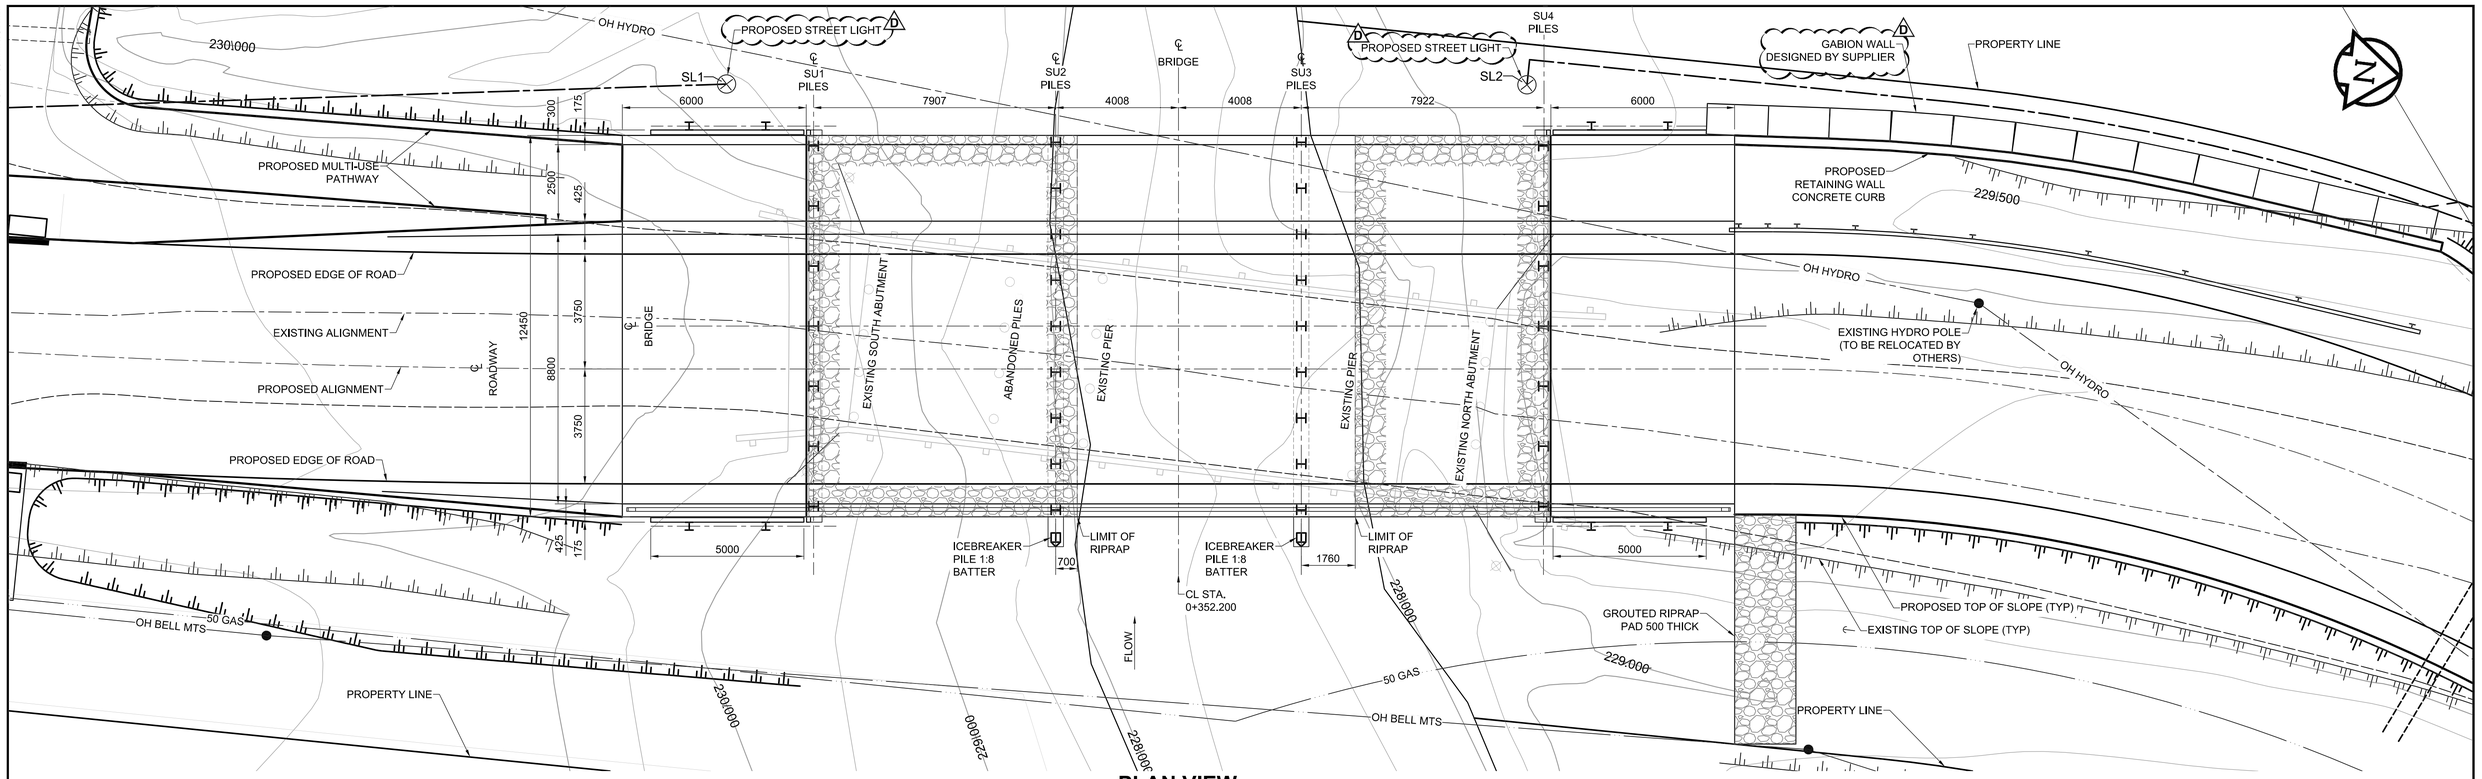

PLAN VIEW

SCALE: 1:100

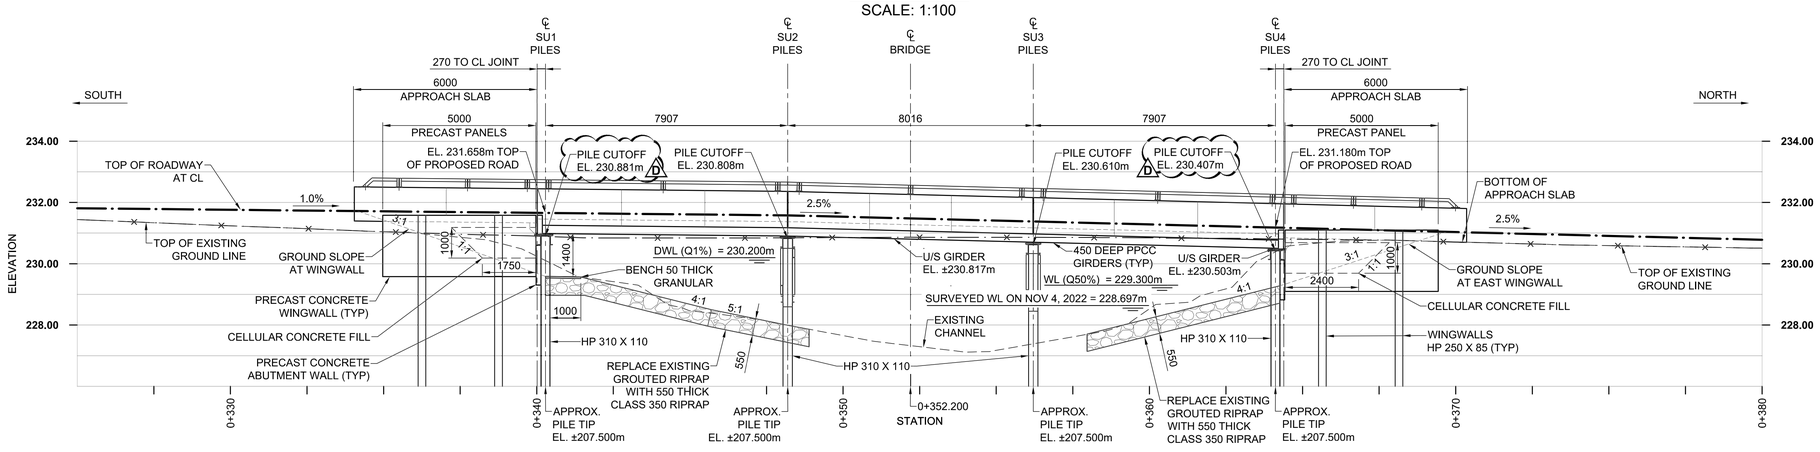

EAST ELEVATION

SCALE: 1:100

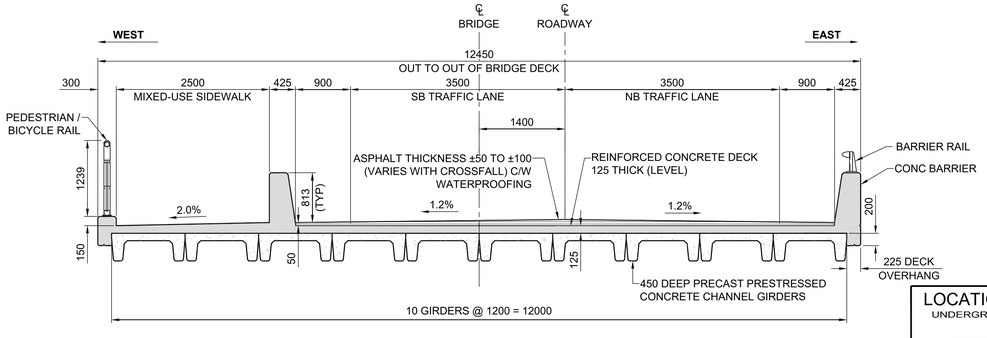

DECK CROSS SECTION

SCALE: 1:50

NOTES:
1. GRADING AROUND NEW STREET LIGHT POLES IN ACCORDANCE WITH CD 30-55

PROPOSED STREET LIGHT LAYOUT

POINT	ALIGNMENT OFFSET (m)	STATION (m)
SL1	9.300	0+337.455
SL2	9.275	0+363.589

ENGINEERS GEOSCIENTISTS MANITOBA
Certificate of Authorization
MORRISON HERSHFIELD
No. 1736

TENDER No. 335-2023

METRIC
WHOLE NUMBERS INDICATE MILLIMETRES
DECIMALIZED NUMBERS INDICATE METRES

LOCATION APPROVED
UNDERGROUND STRUCTURES

SUPR. U/G STRUCTURES COMMITTEE — DATE

NOTE:
LOCATION OF UNDERGROUND STRUCTURES AS SHOWN ARE BASED ON THE BEST INFORMATION AVAILABLE BUT NO GUARANTEE IS GIVEN THAT ALL EXISTING UTILITIES ARE SHOWN OR THAT THE GIVEN LOCATIONS ARE EXACT. CONFIRMATION OF EXISTENCE AND EXACT LOCATION OF ALL SERVICES MUST BE OBTAINED FROM THE INDIVIDUAL UTILITIES BEFORE PROCEEDING WITH CONSTRUCTION.

BM 78-009 ELEV 232.749 m — N.W. Cor. Paddington Rd. & Dakota St., 19 mm dia. x 6.1 m I.B. in Valve Box, 5.5 m S. of N.L. Paddington Rd. & on W.L. of Dakota St., in traffic island.

No.	REVISIONS	YY/MM/DD	BY
D	ISSUED FOR ADDENDUM 1	23/08/23	BAP
C	**ISSUED FOR TENDER**	**23/08/02**	**BAP**
B	ISSUED FOR 95% REVIEW	23/06/27	BAP
A	ISSUED FOR 50% REVIEW	23/04/14	BAP

MORRISON HERSHFIELD

DESIGNED BY	AGG	CHECKED BY	BAP
DRAWN BY	AS	APPROVED BY	BAP
HOR SCALE	AS SHOWN	RELEASED FOR CONSTRUCTION	
VERT SCALE	AS SHOWN		
DATE	JUNE 27, 2023	DATE	

PROFESSIONAL'S SEAL
PROVINCE OF MANITOBA — A.D.G. GILARSKI — Member 32144 — 2023-08-23 — REGISTERED PROFESSIONAL ENGINEER

CONSULTANT FILE NAME
2203665-CBR DD-GA.dwg

Winnipeg

THE CITY OF WINNIPEG
PUBLIC WORKS DEPARTMENT
ENGINEERING DIVISION

CREEK BEND ROAD BRIDGE REPLACEMENT AND RELATED WORKS

GENERAL ARRANGEMENT

CITY DRAWING NUMBER: B149-23-07
SHEET 07 OF 52
DRAWING NUMBER: 07

ISO A1 - 594mm x 841mm
Plotted: 8/22/2023 4:13 PM by Alex Heppner
Last Saved: 8/22/2023 4:09 PM by AHeppner
X:\Proj\2022\20366500-Cof\W 293-2022 Creek Bend Road Bri\09. CAD\07 Sheets\Structural\Detailed Design\2203665-CBR DD-GA.dwg