


A SECTION
SCALE: 1:25

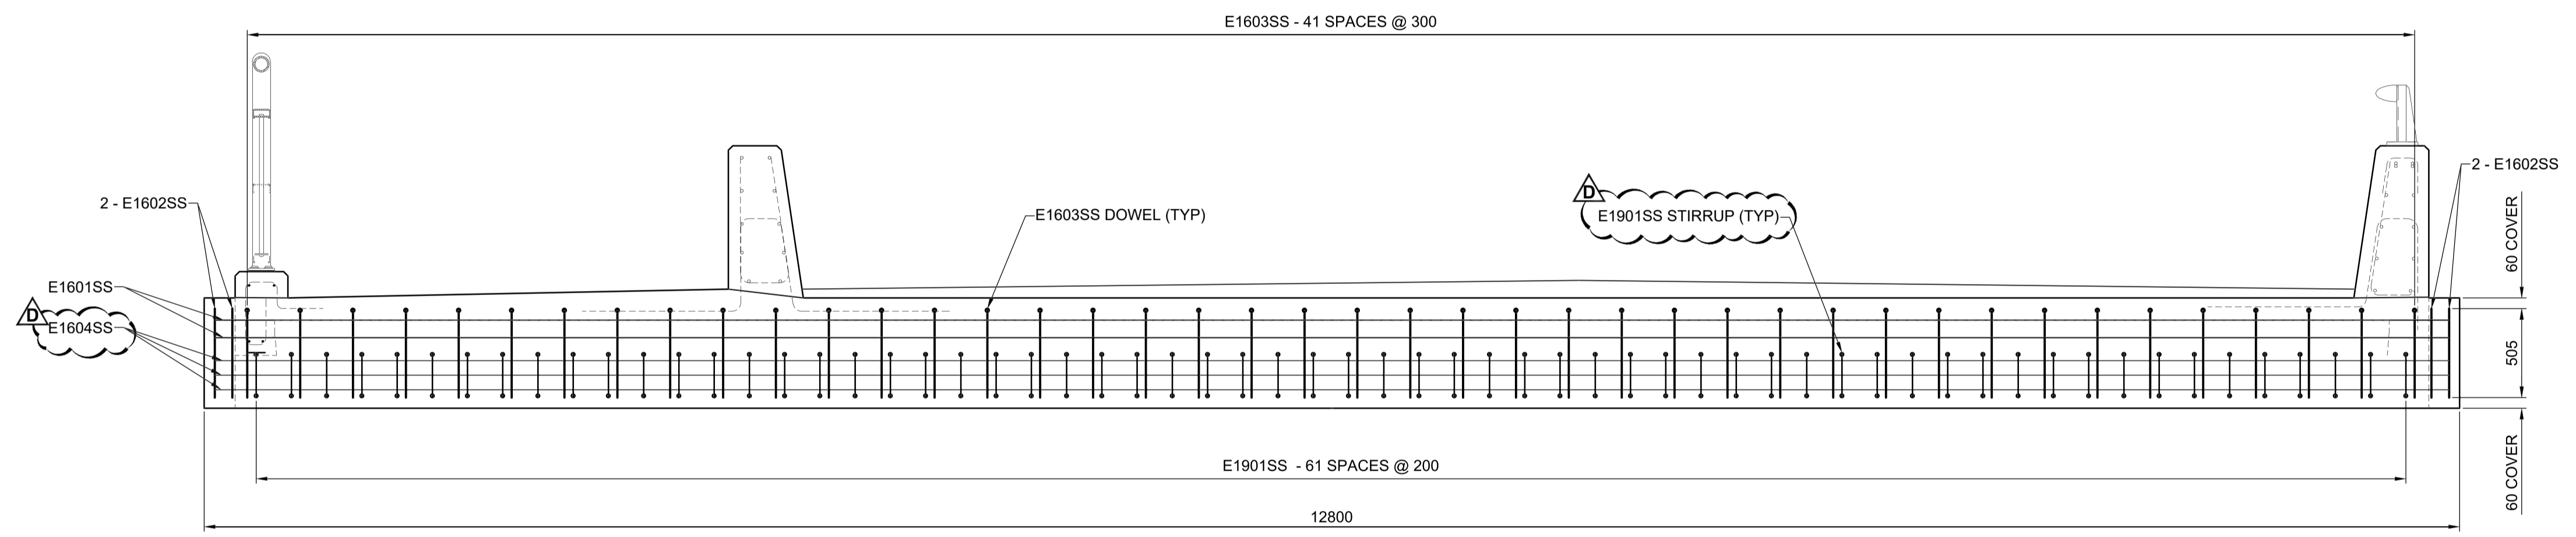

B SECTION
SCALE: 1:25

X:\Proj\2022\22036650-CoW\2022-Creek Bend Road Bridge CAD\07 Sheets\Structural\Detailed Design\2203665-CBR-DD-DECK03.dwg Last Saved: 8/17/2023 4:33 PM by: A.Heggenr Ploct: 8/22/2023 4:00 PM by: Alex Heggenr



TENDER No. 335-2023

LOCATION APPROVED UNDERGROUND STRUCTURES

SUPR. U/G STRUCTURES DATE COMMITTEE

NOTE: LOCATION OF UNDERGROUND STRUCTURES AS SHOWN ARE BASED ON THE BEST INFORMATION AVAILABLE BUT NO GUARANTEE IS GIVEN THAT ALL EXISTING UTILITIES ARE SHOWN OR THAT THE GIVEN LOCATIONS ARE EXACT. CONFIRMATION OF EXISTENCE AND EXACT LOCATION OF ALL SERVICES MUST BE OBTAINED FROM THE INDIVIDUAL UTILITIES BEFORE PROCEEDING WITH CONSTRUCTION.

BM 78-009 ELEV 232.749 m	N.W. Cor. Paddington Rd. & Dakota St., 19 mm dia. x 6.1 m 1.B. in Valve Box, 5.5 m S. of N.L. Paddington Rd. & on W.L. of Dakota St. in traffic island		
D	ISSUED FOR ADDENDUM 1	23/08/23	BAP
C	ISSUED FOR TENDER	23/08/02	BAP
B	ISSUED FOR 95% REVIEW	23/06/27	BAP
A	ISSUED FOR 50% REVIEW	23/04/14	BAP
No.	REVISIONS	YYMM/DD	BY



DESIGNED BY	AGG	CHECKED BY	SAL
DRAWN BY	AS	APPROVED BY	BAP
HOR SCALE	1:25	RELEASED FOR CONSTRUCTION	
VERT SCALE	1:25		
DATE	JUNE 27, 2023	DATE	

PROFESSIONAL'S SEAL

CONSULTANT FILE NAME
2203665-CBR-DD-DECK03.dwg

THE CITY OF WINNIPEG
PUBLIC WORKS DEPARTMENT
ENGINEERING DIVISION

CREEK BEND ROAD BRIDGE REPLACEMENT AND RELATED WORKS

DECK REINFORCING DETAILS

CITY DRAWING NUMBER: B149-23-25
SHEET 25 OF 52
DRAWING NUMBER: 25

METRIC
WHOLE NUMBERS INDICATE MILLIMETRES
DECIMALIZED NUMBERS INDICATE METRES