



**2** **TIMBER FENCE POST SECTION**  
Scale: 1:25

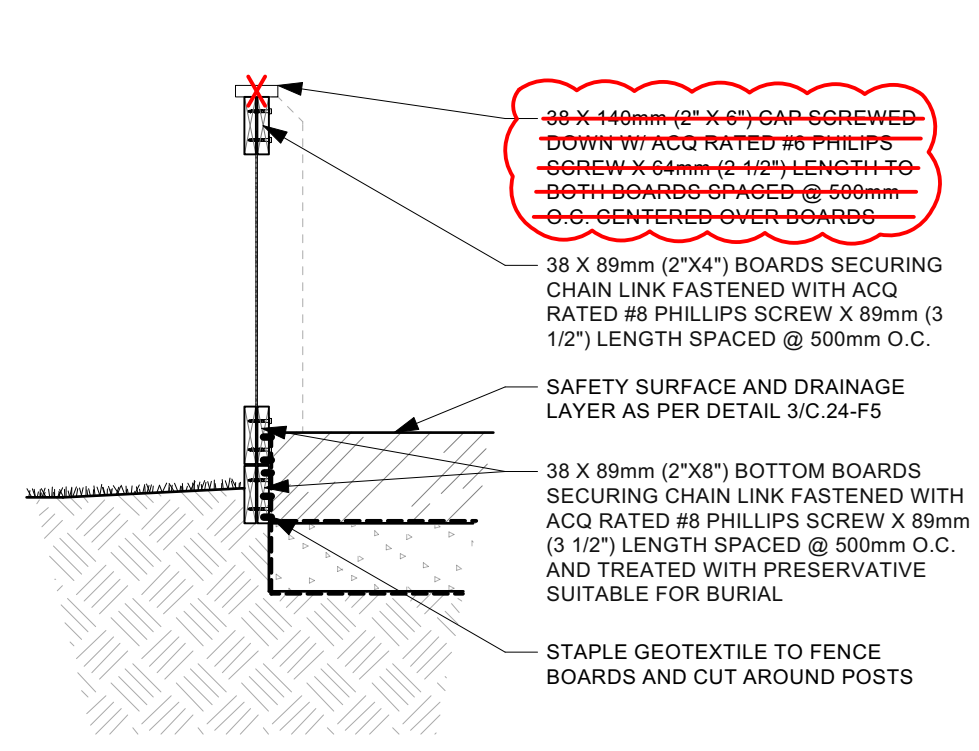

**3** **TIMBER FENCE SECTION**  
Scale: 1:25

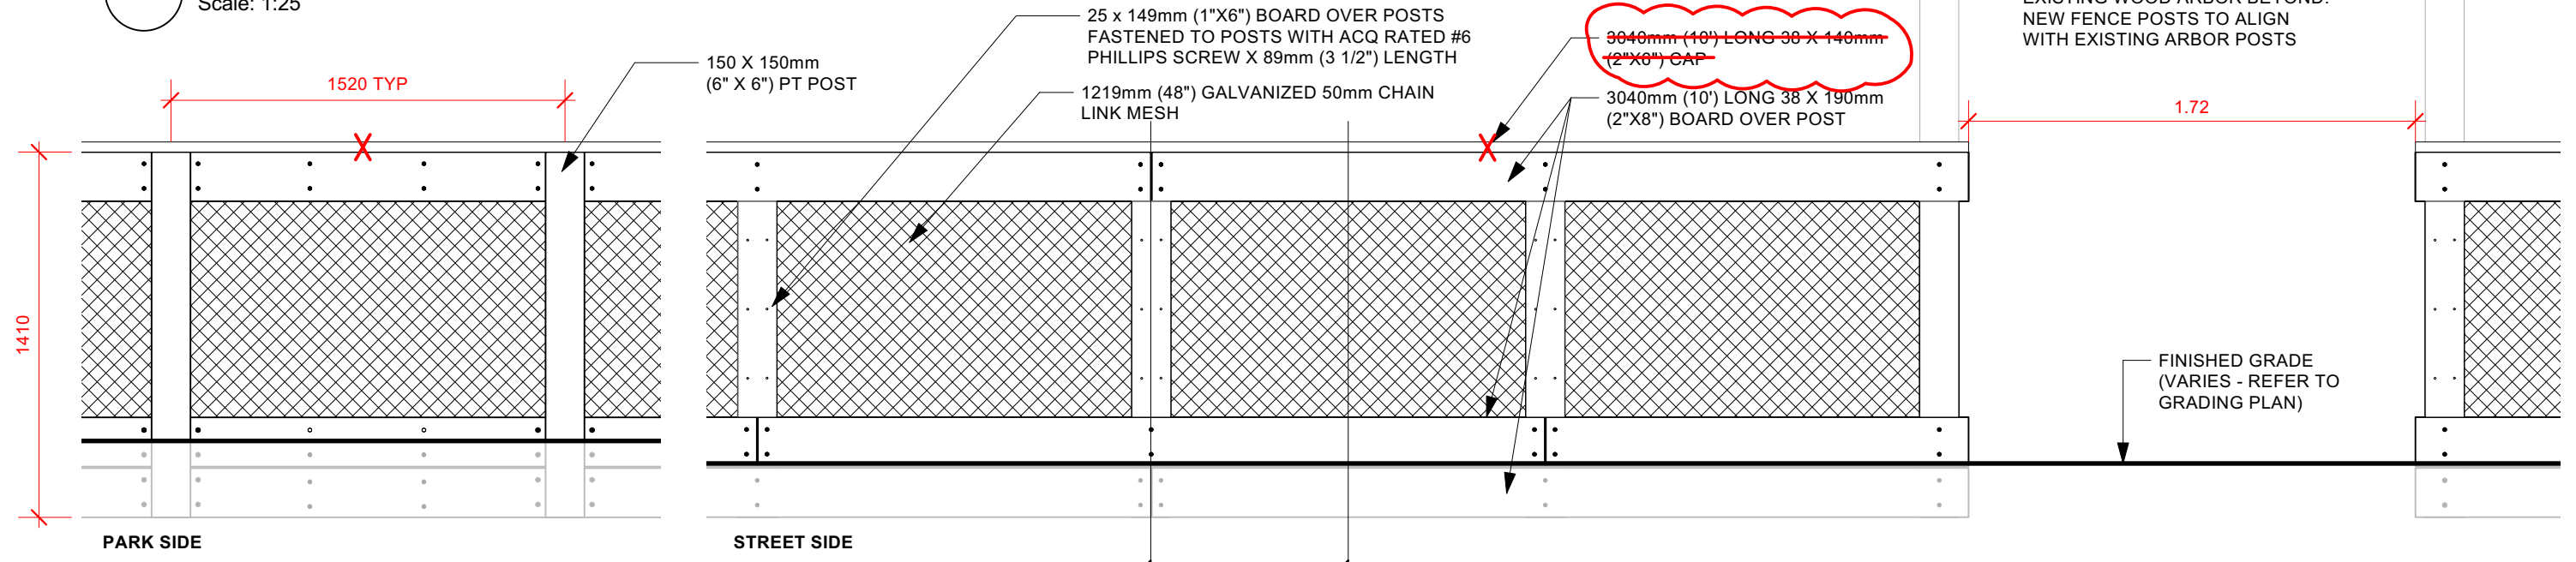

**1** **TIMBER FENCE ELEVATION**  
Scale: 1:25

- NOTES**
1. ALL DIMENSIONS ARE IN MILLIMETERS UNLESS OTHERWISE NOTED
  2. ALL WOOD TO BE PRESSURE TREATED. ENDS AND CUTS TO BE TREATED WITH PRESERVATIVE (USE PRESERVATIVE SUITABLE FOR BURIAL WHERE REQUIRED)
  3. ALL HARDWARE TO BE ACQ APPROVED
  4. ALTERNATE ALIGNMENT OF BOARD ENDS ROW OVER ROW
  5. ALL CHAIN LINK COMPONENTS TO BE GALVANIZED

CONTRACTOR TO CONFIRM ALL DIMENSIONS AND REPORT ANY DISCREPANCIES TO CONTRACT ADMINISTRATOR PRIOR TO CONSTRUCTION. LOCATION OF UNDERGROUND STRUCTURES AS SHOWN ARE BASED ON THE BEST INFORMATION AVAILABLE BUT NO GUARANTEE IS GIVEN THAT ALL EXISTING UTILITIES ARE SHOWN OR THAT THE GIVEN LOCATIONS ARE EXACT. CONFIRMATION OF EXISTENCE AND EXACT LOCATION OF ALL SERVICES MUST BE OBTAINED FROM THE INDIVIDUAL UTILITIES BEFORE PROCEEDING WITH CONSTRUCTION.

<p>THE CITY OF WINNIPEG Planning, Property and Development Department Planning and Land Use Division Unit 15 - 30 Fort Street, Winnipeg, MB, (R3C 4X5)</p>	DESIGNED BY	DL	CHECKED BY		DRAWING TITLE <b>Carter Park Playground Redevelopment Timber Wall Details</b>	DRAWING NO. <b>C.24-F6-R1</b>
	DRAWN BY	MG	APPROVED BY			
	HORIZ. SCALE	As Shown			MANAGER, PARK AND OPEN SPACES	DATE
	DATE	July 2023			MANAGER, PLANNING AND LAND USE DIVISION	DATE
					SITE ADDRESS	806 Carter Ave.
					BID OPPORTUNITY NO. <b>514-2023</b>	