


File name: U:\FW\23-0107-009\23-0107-009_Feedermain Tree Clearing Contract_CALL - TabC101 Rev. B Plotted By: Gheinrichs 24/02/20 [Tue 10:40am]
 At (City/Region) / (Scale)

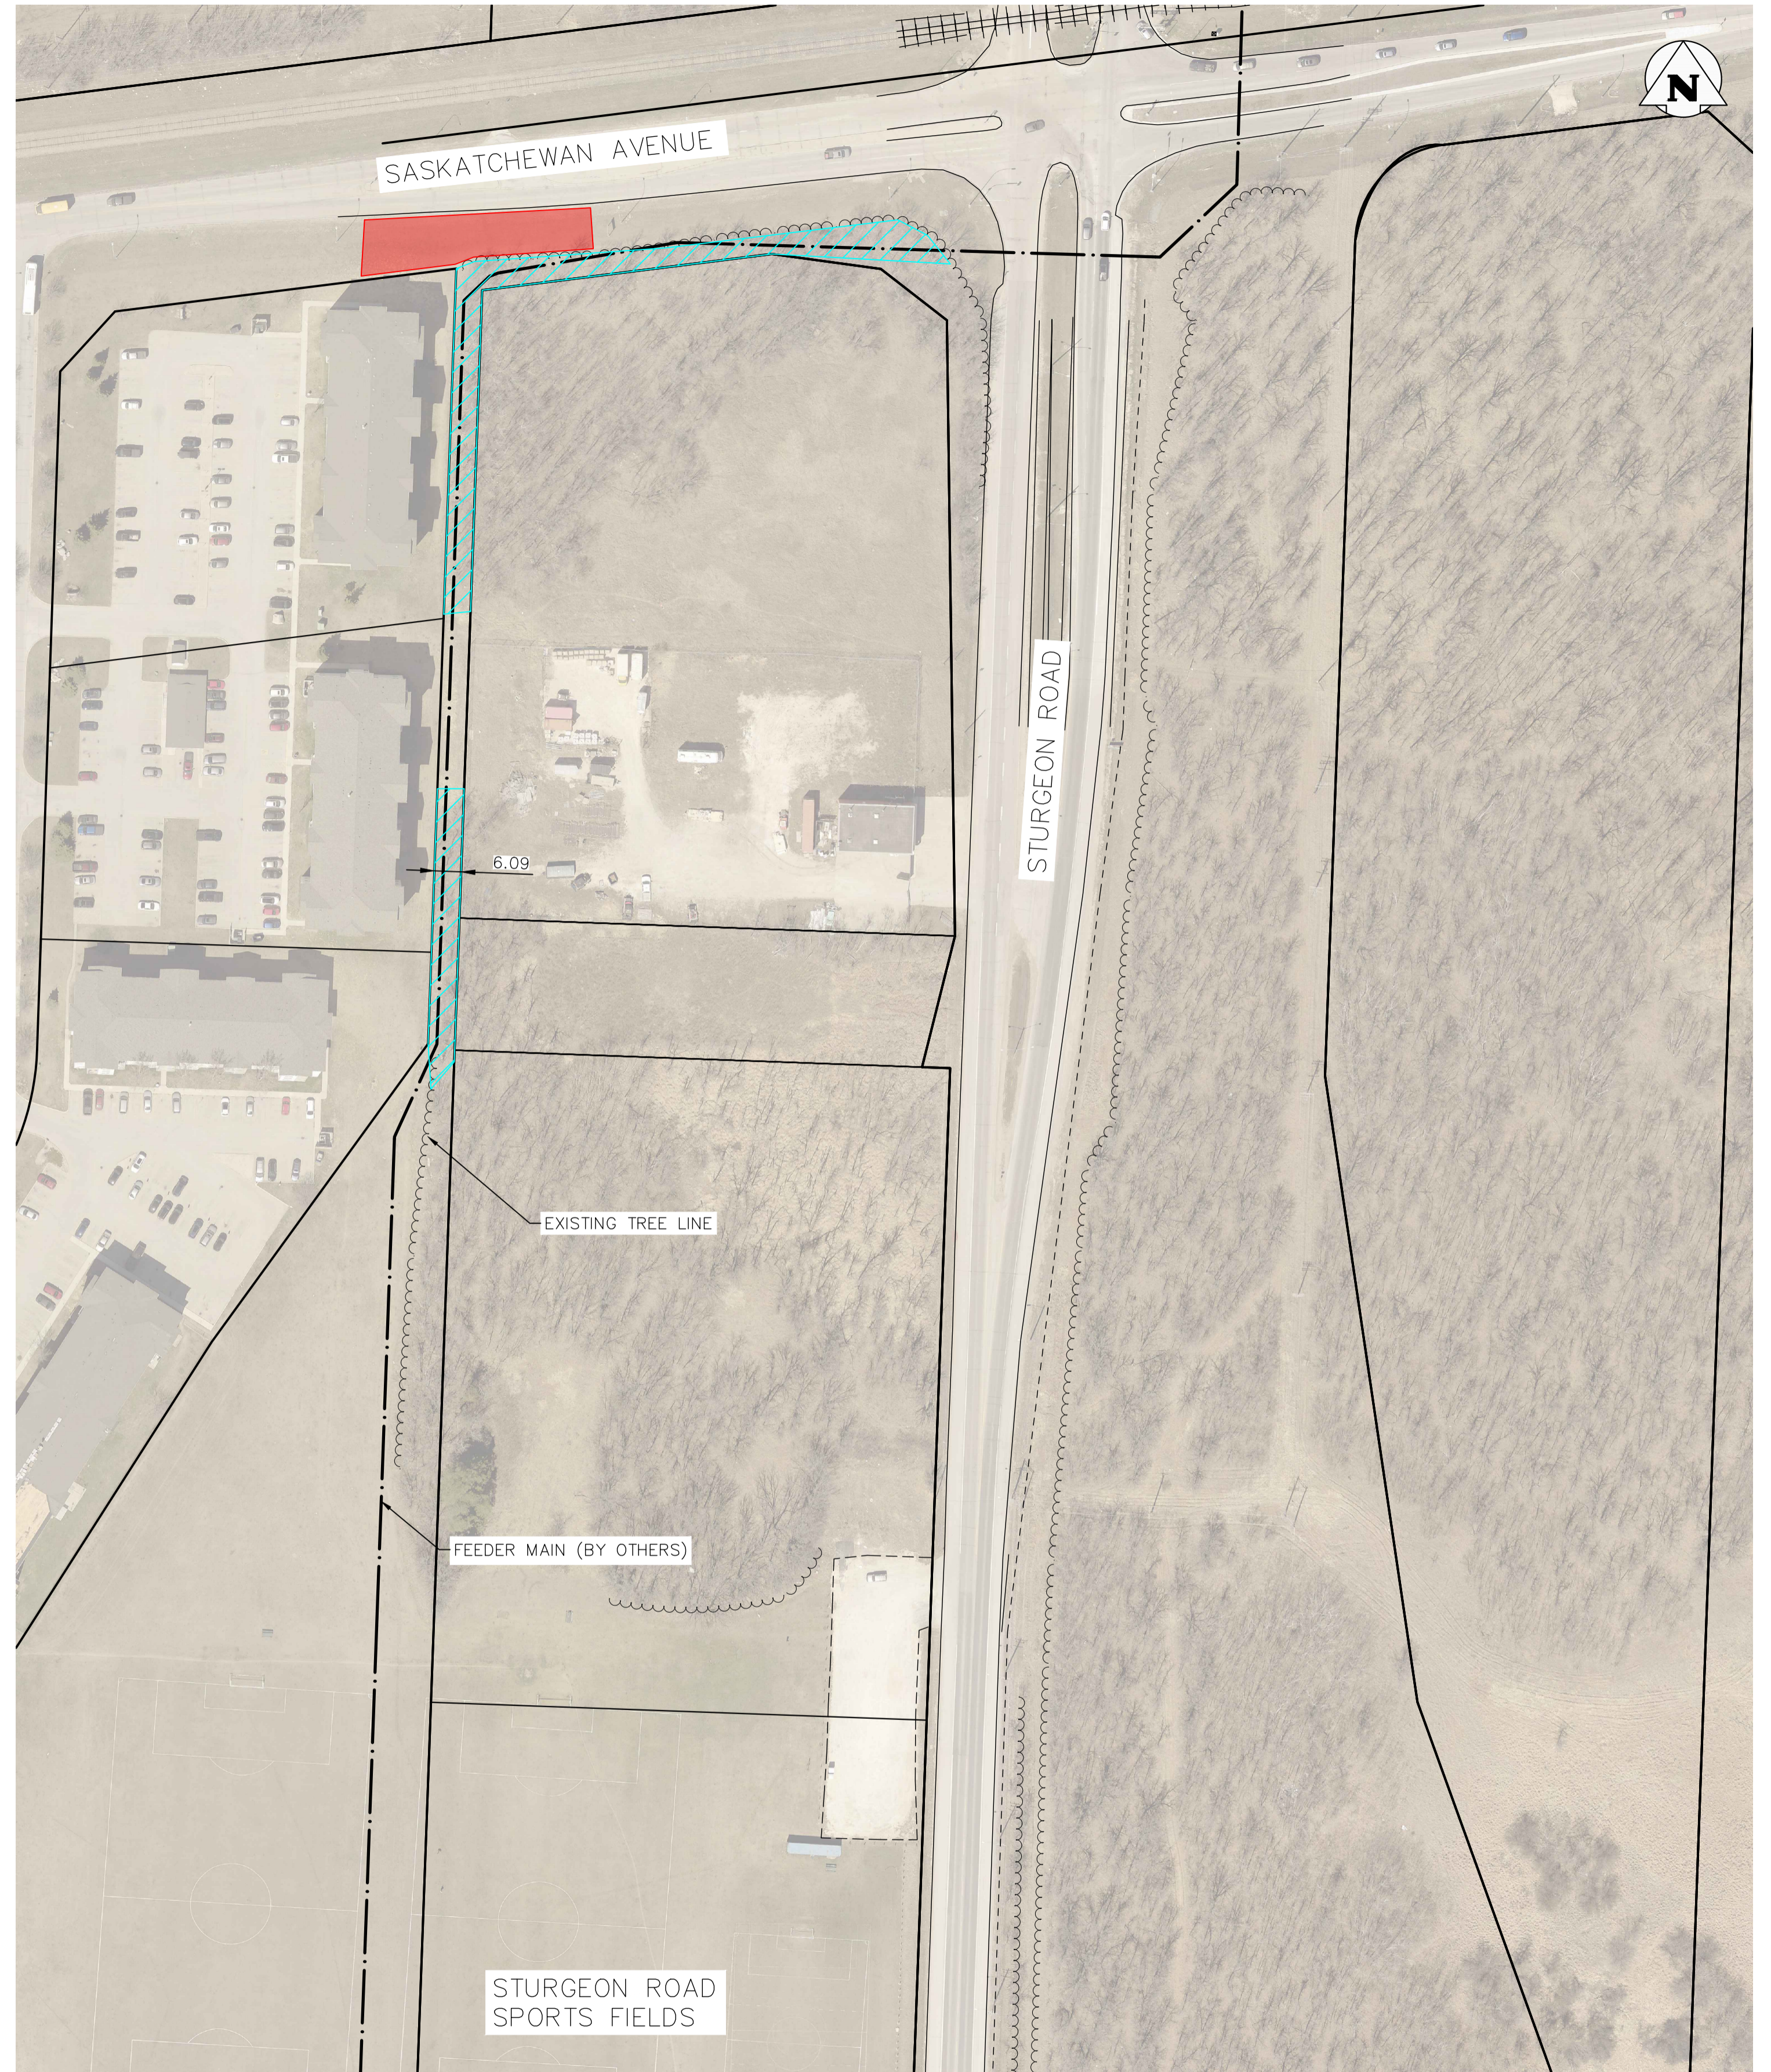

- APPROXIMATE TREE CLEARING AREA: 1,480m²
- DESIGNATED LAYDOWN AREA AND SITE ACCESS POINT

ENGINEERS
 GEOSCIENTISTS
 MANITOBA
 Certificate of Authorization
 KGS Group
 No. 245

FOR TENDER ONLY
NOT TO BE USED FOR CONSTRUCTION

METRIC
WHOLE NUMBERS INDICATE MILLIMETRES
DECIMALIZED NUMBERS INDICATE METRES

WARNING

NOTIFY THE GAS COMPANY OF THE PROPOSED LOCATION OF EXCAVATION.
 TAKE PRECAUTION TO AVOID DAMAGE TO GAS COMPANY INSTALLATIONS.
 SEE PROVINCIAL REGULATION 210/72 FOR DETAILS.

LOCATIONS OF UNDERGROUND STRUCTURES AS SHOWN ARE BASED ON THE BEST INFORMATION AVAILABLE, BUT NO GUARANTEE IS GIVEN THAT ALL EXISTING UTILITIES ARE SHOWN OR THAT THE GIVEN LOCATIONS ARE EXACT. CONFIRMATION OF THE EXISTENCE AND EXACT LOCATION OF ALL SERVICES MUST BE OBTAINED FROM INDIVIDUAL UTILITIES BEFORE PROCEEDING WITH CONSTRUCTION.

PROPERTY LIMITS DELINEATION
 DELINEATION OF PROPERTY LIMITS AS SHOWN ON THIS DWG DOES NOT REPRESENT A "LEGAL SURVEY". KGS GROUP MAKES NO REPRESENTATION OR WARRANTY AS TO THE ACCURACY OF PROPERTY LIMITS DELINEATED ON THIS DWG, NOR ON THE DIMENSIONAL ACCURACY OF DWG FEATURES RELATIVE TO THOSE PROPERTY LIMITS.

LOCATION APPROVED UNDERGROUND STRUCTURES

SUPV. U/G STRUCTURES COMMITTEE	DATE

NOTE:
 LOCATION OF UNDERGROUND STRUCTURES AS SHOWN ARE BASED ON THE BEST INFORMATION AVAILABLE BUT NO GUARANTEE IS GIVEN THAT ALL EXISTING UTILITIES ARE SHOWN OR THAT THE GIVEN LOCATIONS ARE EXACT. CONFIRMATION OF EXISTENCE AND EXACT LOCATION OF ALL SERVICES MUST BE OBTAINED FROM THE INDIVIDUAL UTILITIES BEFORE PROCEEDING WITH CONSTRUCTION.

B.M. ELEV.	COORDINATE SYSTEM: UTM WITH NAD 83 DATUM, ZONE 14, METER.

NO.	REVISIONS	DATE	BY
1	REVISED TREE CLEARING SITE	24/02/20	GH
0	ISSUED FOR TENDER	24/02/02	GH

KGS GROUP

DESIGNED BY: GH	CHECKED BY: RO
DRAWN BY: GH	APPROVED BY: RO

HOR. SCALE: 1:1000
 VERTICAL:

DATE: 2024 02 02	RELEASED FOR CONSTRUCTION: DATE
------------------	---------------------------------

ENGINEER'S SEAL

G.T. HEINRICHS
 Member 38162
 REGISTERED PROFESSIONAL ENGINEER

CONSULTANT DRAWING NO. C101

THE CITY OF WINNIPEG
 WATER AND WASTE DEPARTMENT
 ENGINEERING DIVISION

PROJECT TITLE: TREE REMOVAL SERVICES - CENTREPORT SOUTH REGIONAL WATER AND WASTEWATER SERVICING
 SHEET 1 OF 1
 COMPUTER FILE NAME: 23-0107-009_FEEDERMAIN TREE CLEARING CONTRACT_CALL.DWG
 CITY DRAWING NUMBER: C101

STURGEON ROAD SOUTH
TREE CLEARING LIMITS