WORKING DRAWING REVIEW

REVIEW IS FOR GENERAL COMPLIANCE WITH CONTRACT DOCUMENTS
NO RESPONSIBILITY IS ASSUMED FOR CORRECTNESS OF DIMENSIONS OR DETAILS.

✓	NO EXCEPTIONS TAKEN
	PROCEED PER COMMENTS & RESUBMIT
	AMEND PER COMMENTS & RESUBMIT
	REJECTED

SEE DWG. #2

MacLAREN ENGINEERS
PLANNERS & SCIENTISTS INC.

Date NOV. 16/81 By C. Albiani

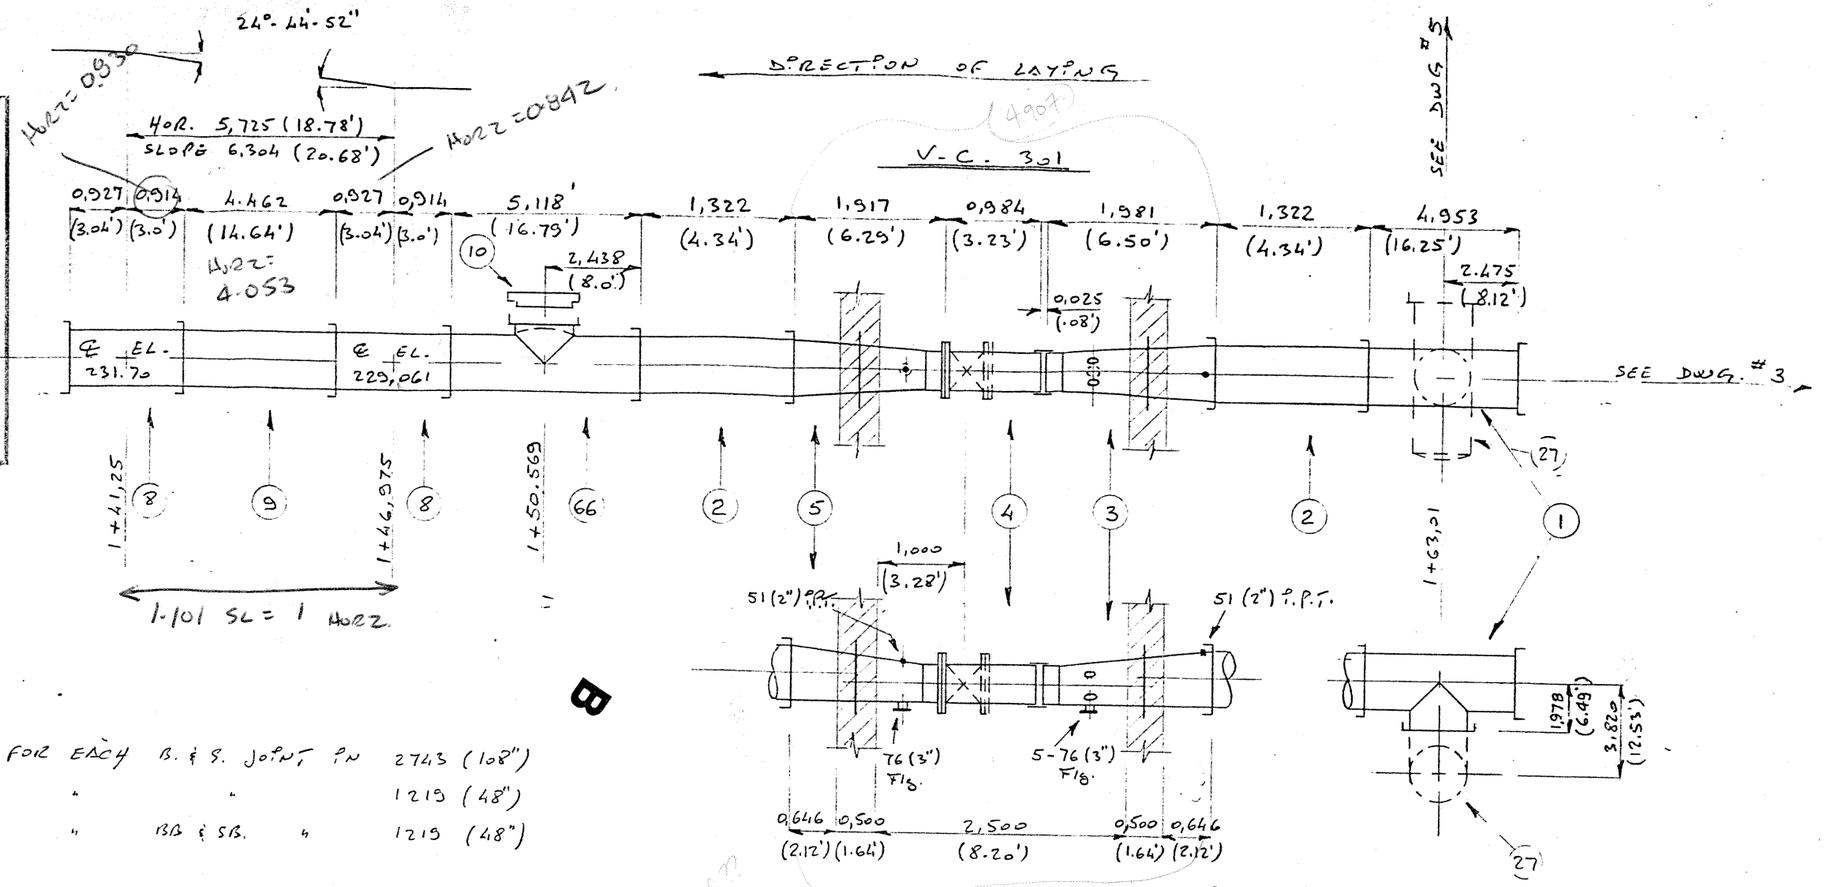

NOTES :

1) A SPACE OF 0,012 (.04') HAS BEEN LEFT FOR EACH B. & S. JOINT EX 2743 (108")
" 0,009 (.03') " " " 1219 (48")
" 0,012 (.04') " " BB & SB. " 1219 (48")
2) (BB) = BELL BOLTED TIED JOINT
3) ALL ELEVATIONS, CHAINAGES & LENGTHS IN METERS
4) ALL DIAMETERS IN MILLIMETERS
5) ALL DIMENSIONS IN BRACKETS IN IMPERIAL UNIT.
6) TYPE V CEMENT INSIDE & OUTSIDE
7) NUTS & BOLTS OF VIKING JOHNSON COUPLING TO BE CADMIUM PLATED

B

A FILL

QTY	MK no.	DIAMETER		DESCRIPTION	LENGTH		ENDS	REFERENCE
1		2134	84"	VIKING JOHNSON COUPLING (PIPE OD. 88.19" & 7" MIDDLE RING)				
1	10	2743	108"	BULKHEAD SPIGOT TEMPORARY			S.	46-5-8005-45
1	9	"	"	SHORT PIPE CL. 15	4,450	14'-7 3/16"	B. & S.	
2	8	"	"	ELBOW 24°-44'-52"	0.914 x 0.914	3'-0" x 3'-0"	B. & S.	46-5-8005-15
1	66	2743	108"	TEE WITH 2743 (108") BELL & DIAPHRAGM	5,105	16'-9"	B. & S.	46-5-8005-44
1	5	2743x2134	108"x84"	ECCENTRIC REDUCER WITH 51(2") PPT & 76(3") Flg & W. FL.	1,905	6'-3"	B. & Flg.	46-5-8005-13
1	4	2134	84"	ADAPTOR	0,984	3'-2 3/4"	Flg. & PS.	46-5-8005-12
1	3	2743x2134	108"x84"	ECC. REDUCER WITH 51(2") PPT. & 5-76(3") Flg. & WALL FL.	1,981	6'-6"	S. & PS	46-5-8005-11
2	2	2743	108"	SHORT PIPE CL. 15	1,310	4'-3 5/8"	B. & S.	46-5-8005-53
1	1	2743	108"	TEE WITH 2743 (108") SPIGOT	4,929	16'-2"	B. & B.	46-5-8005-10

DATE	NO	REVISION	BY
MARCH 29,79	B	REVISED TENDER NUMBER	G.L.
APRIL 11,79	C	REVISED CLASS OF PIPE	G.L.

This drawing and all technical information appearing hereon are the property of CANRON INC. and must be kept in confidence by the recipient. The same may not be used or reproduced either in whole or in part without the express consent of CANRON INC., which reserves all rights of copyright.

CANRON INC. PIPE DIVISION

MICROFILMED NOV - - 1981

10819-2D-1C

THE CITY OF WINNIPEG
2743 ϕ SUCTION FROM RESERVOIR
DEACON BOOSTER PUMPING STATION

SCALE: —— DATE: JANUARY 30, 1979

DRAWN	CHECKED	APPROVED	PROJECT	DWG.	REV.
G.L.	C.V.		46-5-8005	1	C

F-1575 1 OF 62