SHEET: TB_OCK-COW-A1 (10/2004)

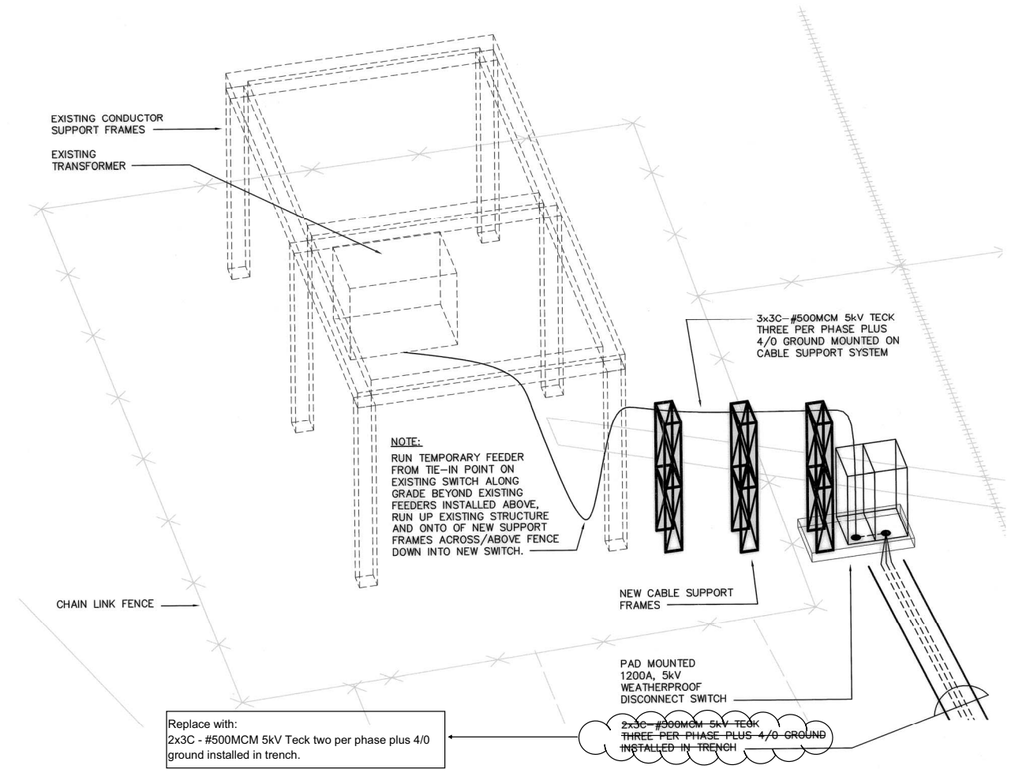

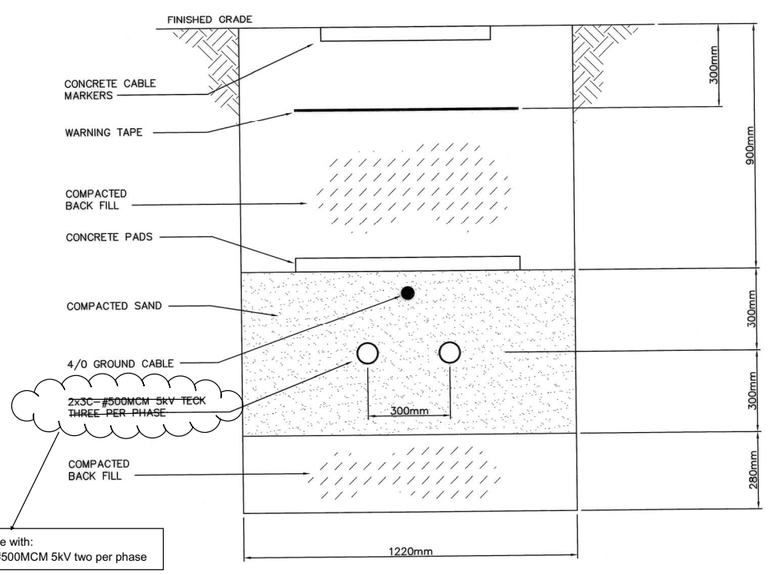

A
E003
SECTION
SCALE 1:10

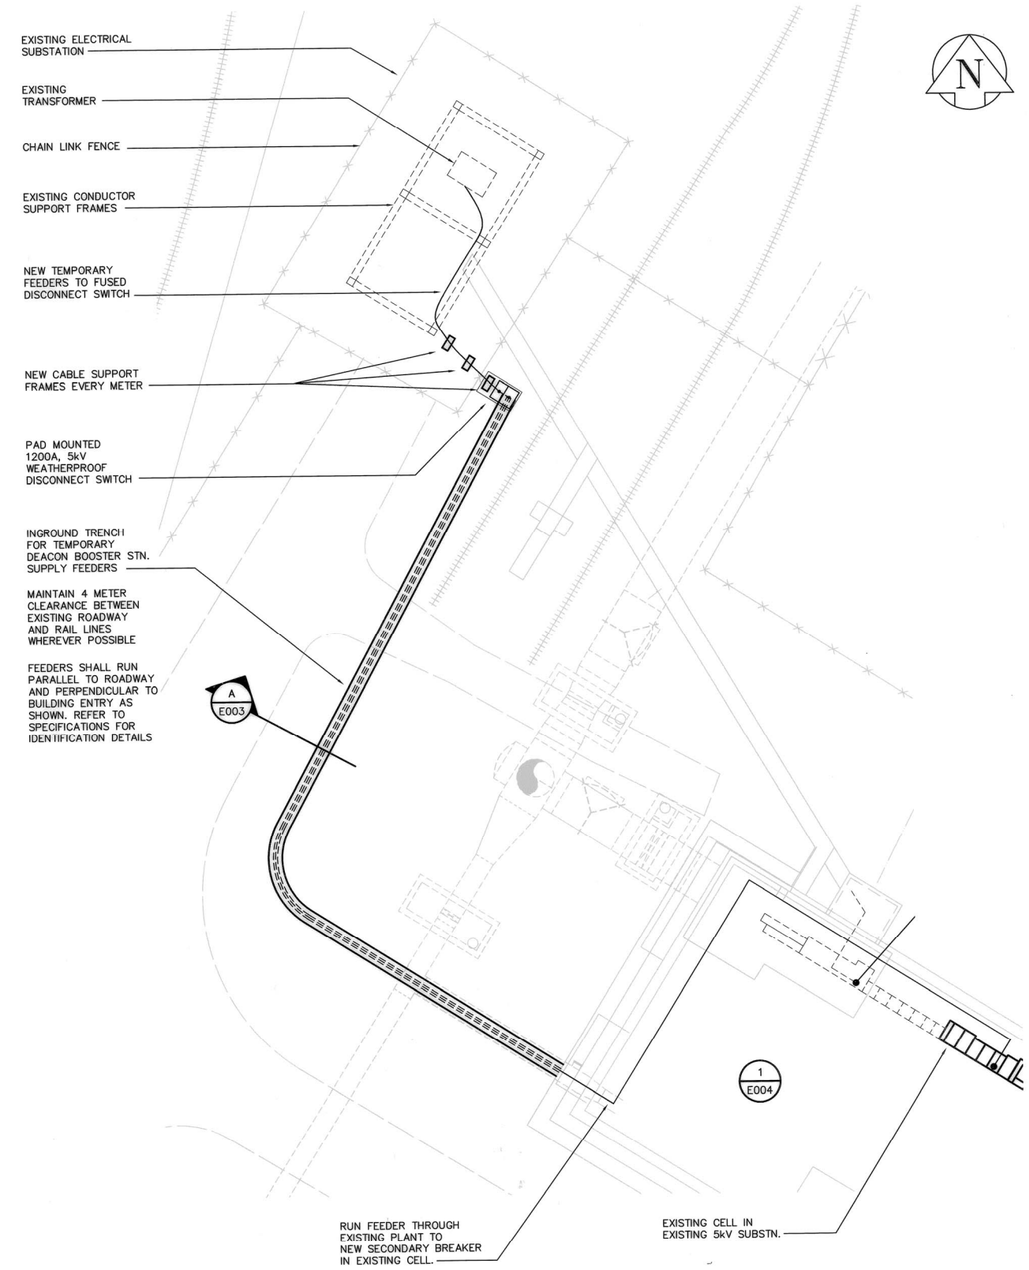

DRAWING NO. WM-E003-SK-1-Rev1

03/01/05 02:57pm corey.thiessen L:\work\79000\79538\02a-CAD\ELE\CONTR\WM-E003.dwg Layout:Layout1