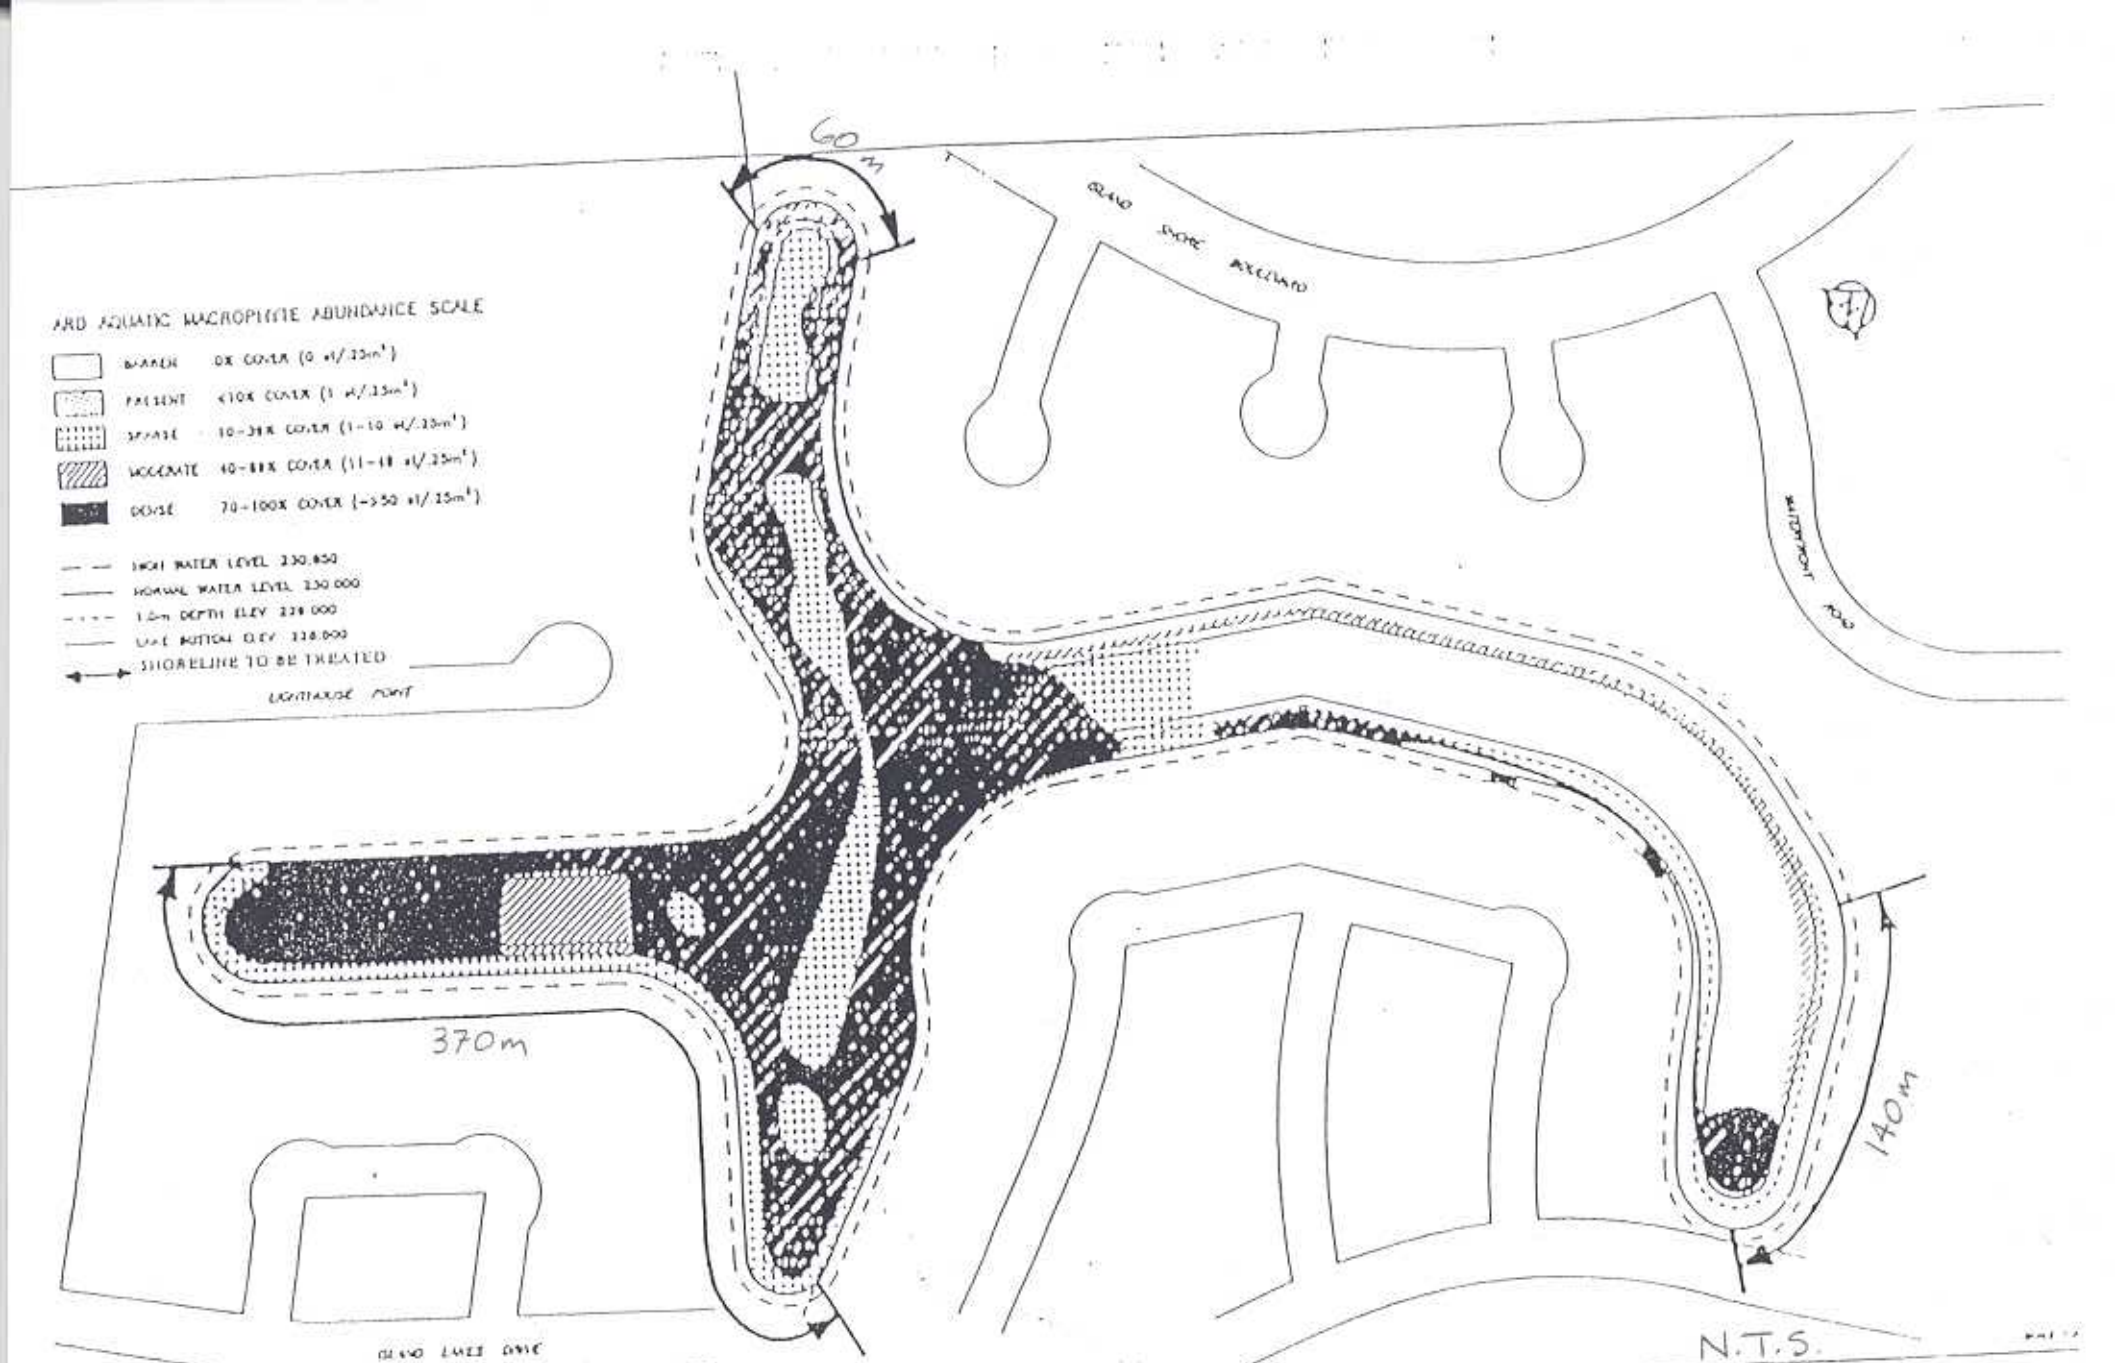

LAKE 5-15

TOTAL SHORELINE TO BE TREATED = 580

DWG. No. 15

STORM WATER RETENTION BASIN REVIEW STUDY
LAKE 5-15
SUBMERGED, ROOTED AQUATIC MACROPHYTE GROWTH
AUGUST 1991