




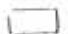


ARD AQUATIC MACROPHYTE ABUNDANCE SCALE

-  BLANK 0% COVER (0 #/25m<sup>2</sup>)
-  FRESH 1-10% COVER (1 #/25m<sup>2</sup>)
-  SPARSE 10-30% COVER (1-10 #/25m<sup>2</sup>)
-  MEDIUM 40-60% COVER (11-18 #/25m<sup>2</sup>)
-  DENSE 70-100% COVER (>20 #/25m<sup>2</sup>)

- 1981 WATER LEVEL 220.430
- 1984 WATER LEVEL 228.900
- - - 1.0m DEPTH ELEV. 227.900
- LAKE BOTTOM ELEV. 227.078

← SHORELINE TO BE TREATED

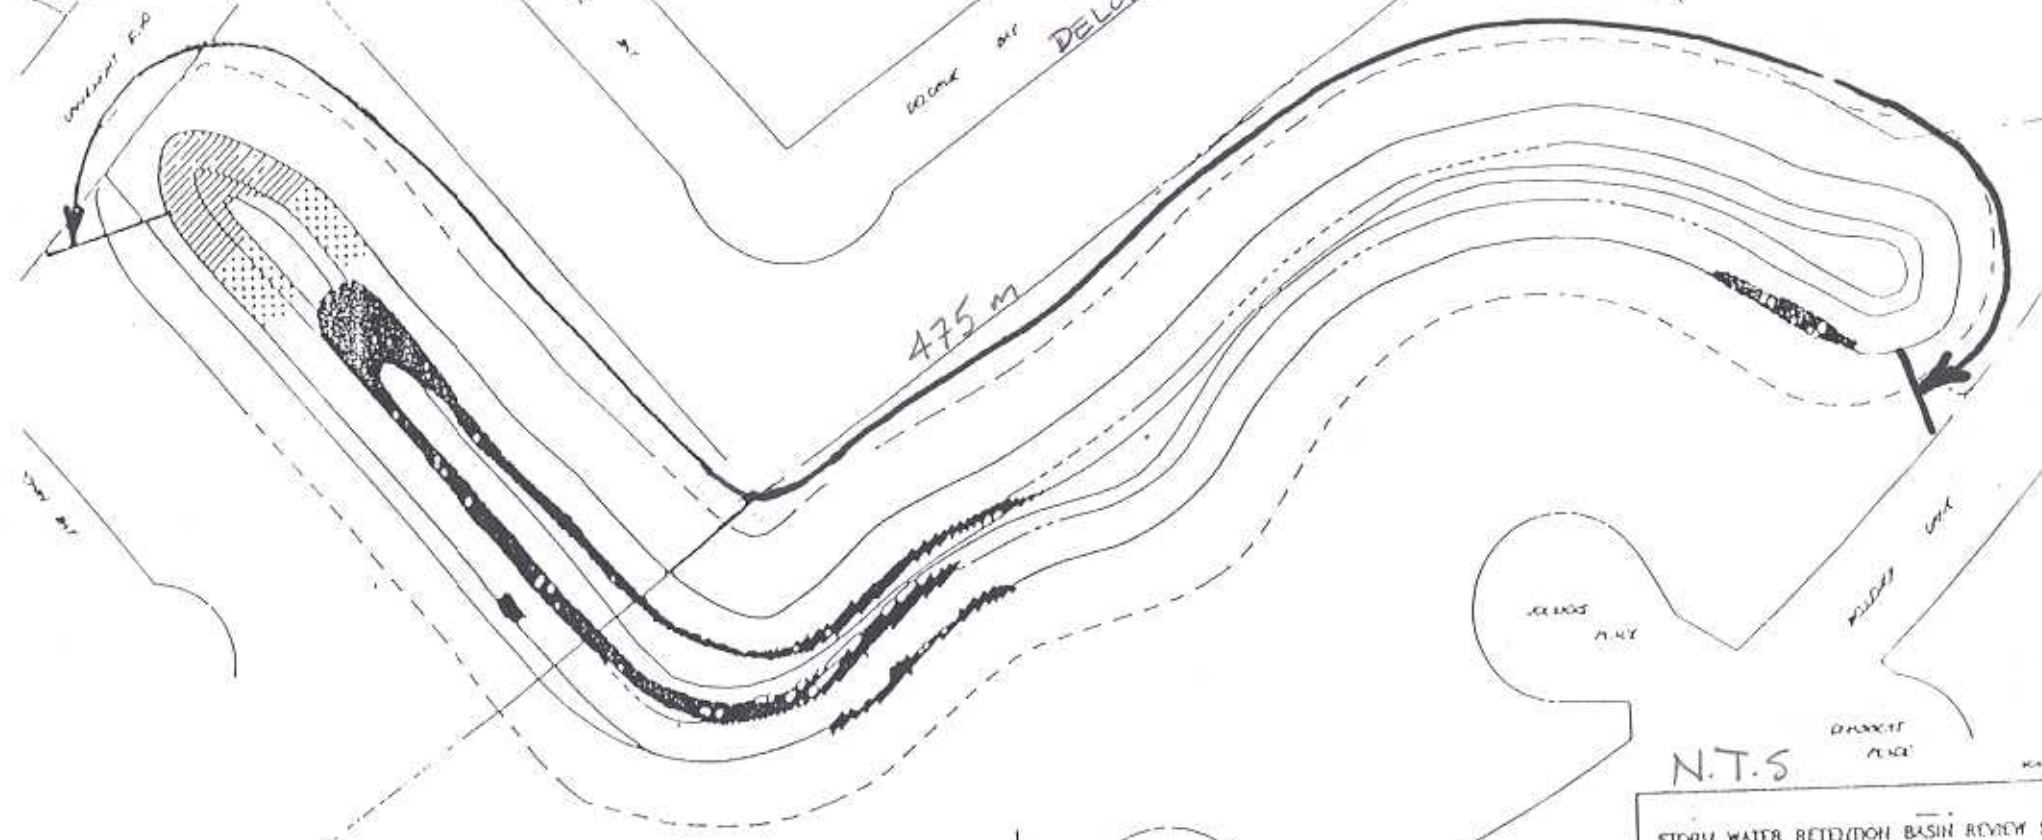

TOTAL SHORELINE TO BE TREATED = 475 m  
 LAKE 6-13  
 DWG. No. 27

N.T.S.  
 STORM WATER RETENTION BASIN REVIEW 5  
 LAKE 6-13  
 SUBMITTED, ARMED AQUATIC MACROPHYTE CRUISE  
 AUGUST 1988