


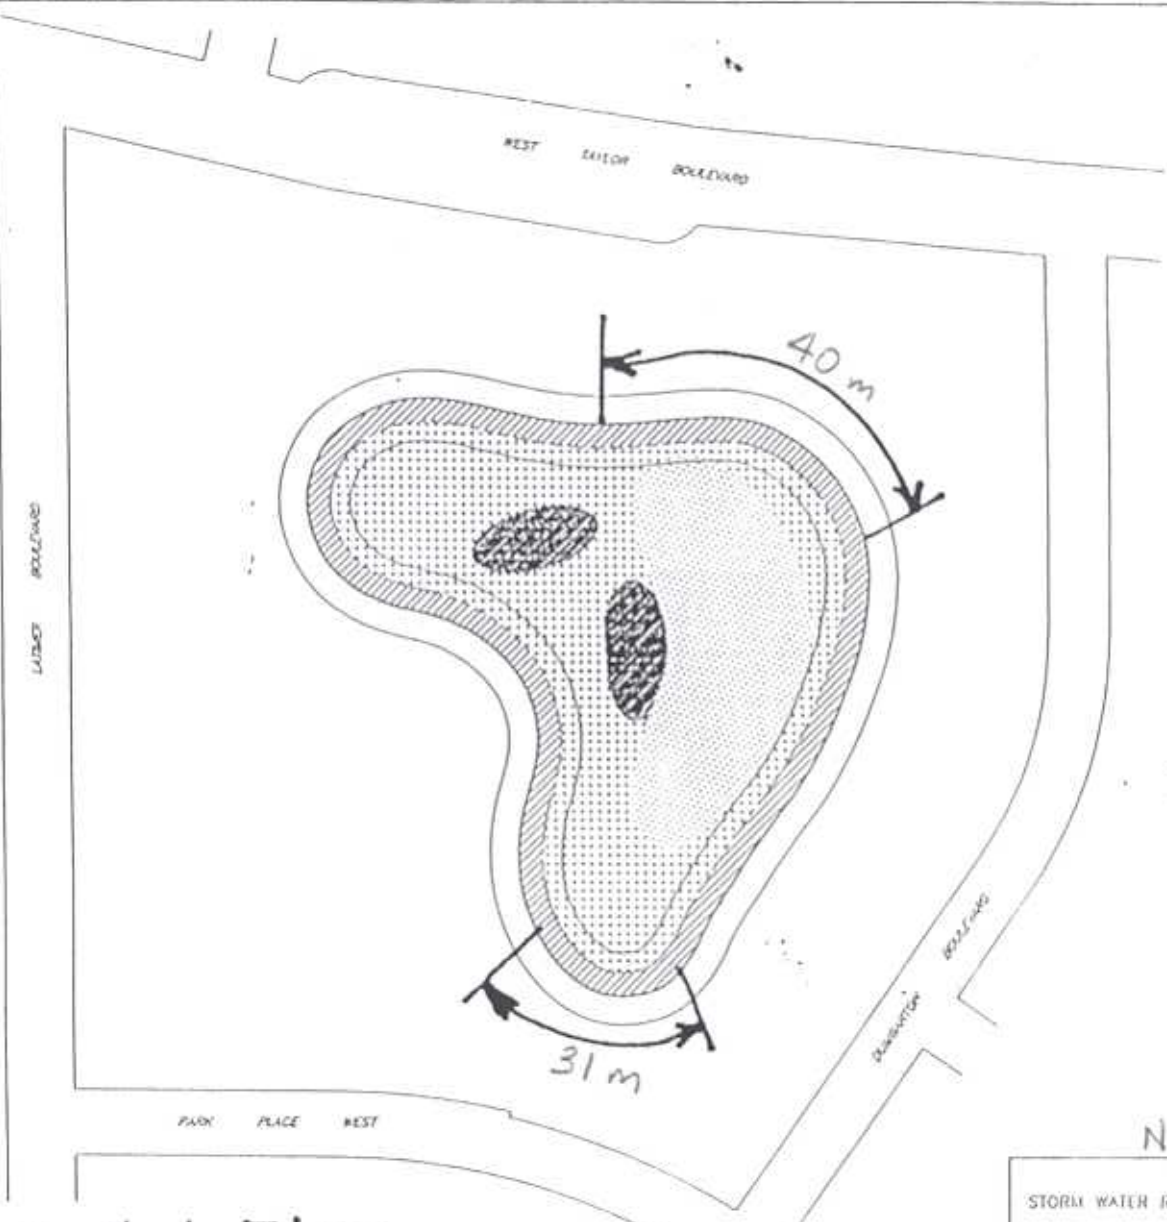

AND AQUATIC MACROPHYTE ABUNDANCE SCALE

- BARE 0% COVER (0  $\pm$ /25m<sup>2</sup>)
- PRESENT <10% COVER (1  $\pm$ /25m<sup>2</sup>)
- SPARSE 10-29% COVER (1-10  $\pm$ /25m<sup>2</sup>)
- MODERATE 40-89% COVER (11-49  $\pm$ /25m<sup>2</sup>)
- DENSE 70-100% COVER (>50  $\pm$ /25m<sup>2</sup>)

- HIGH WATER LEVEL 232.290
- NORMAL WATER LEVEL 231.070
- - - 1.0m DEPTH ELEV 230.070
- LAKE BOTTOM ELEV 229.240



LAKE 6-19

Total Shoreline To be treated 71 m

N.T.S. ONE FISH

STORM WATER RETENTION BASIN REVIEW STUDY  
 LAKE 6-19  
 SUBMERGED, ROOTED AQUATIC MACROPHYTE GROWTH  
 AUGUST 1991

DWG. No. 33