




 


ARD AQUATIC MACROPHYTE ABUNDANCE SCALE

	BARREN	0% COVER (0 #/25m ²)
	PRESENT	<10% COVER (1 #/25m ²)
	DENSE	70-100% COVER (>50 #/25m ²)


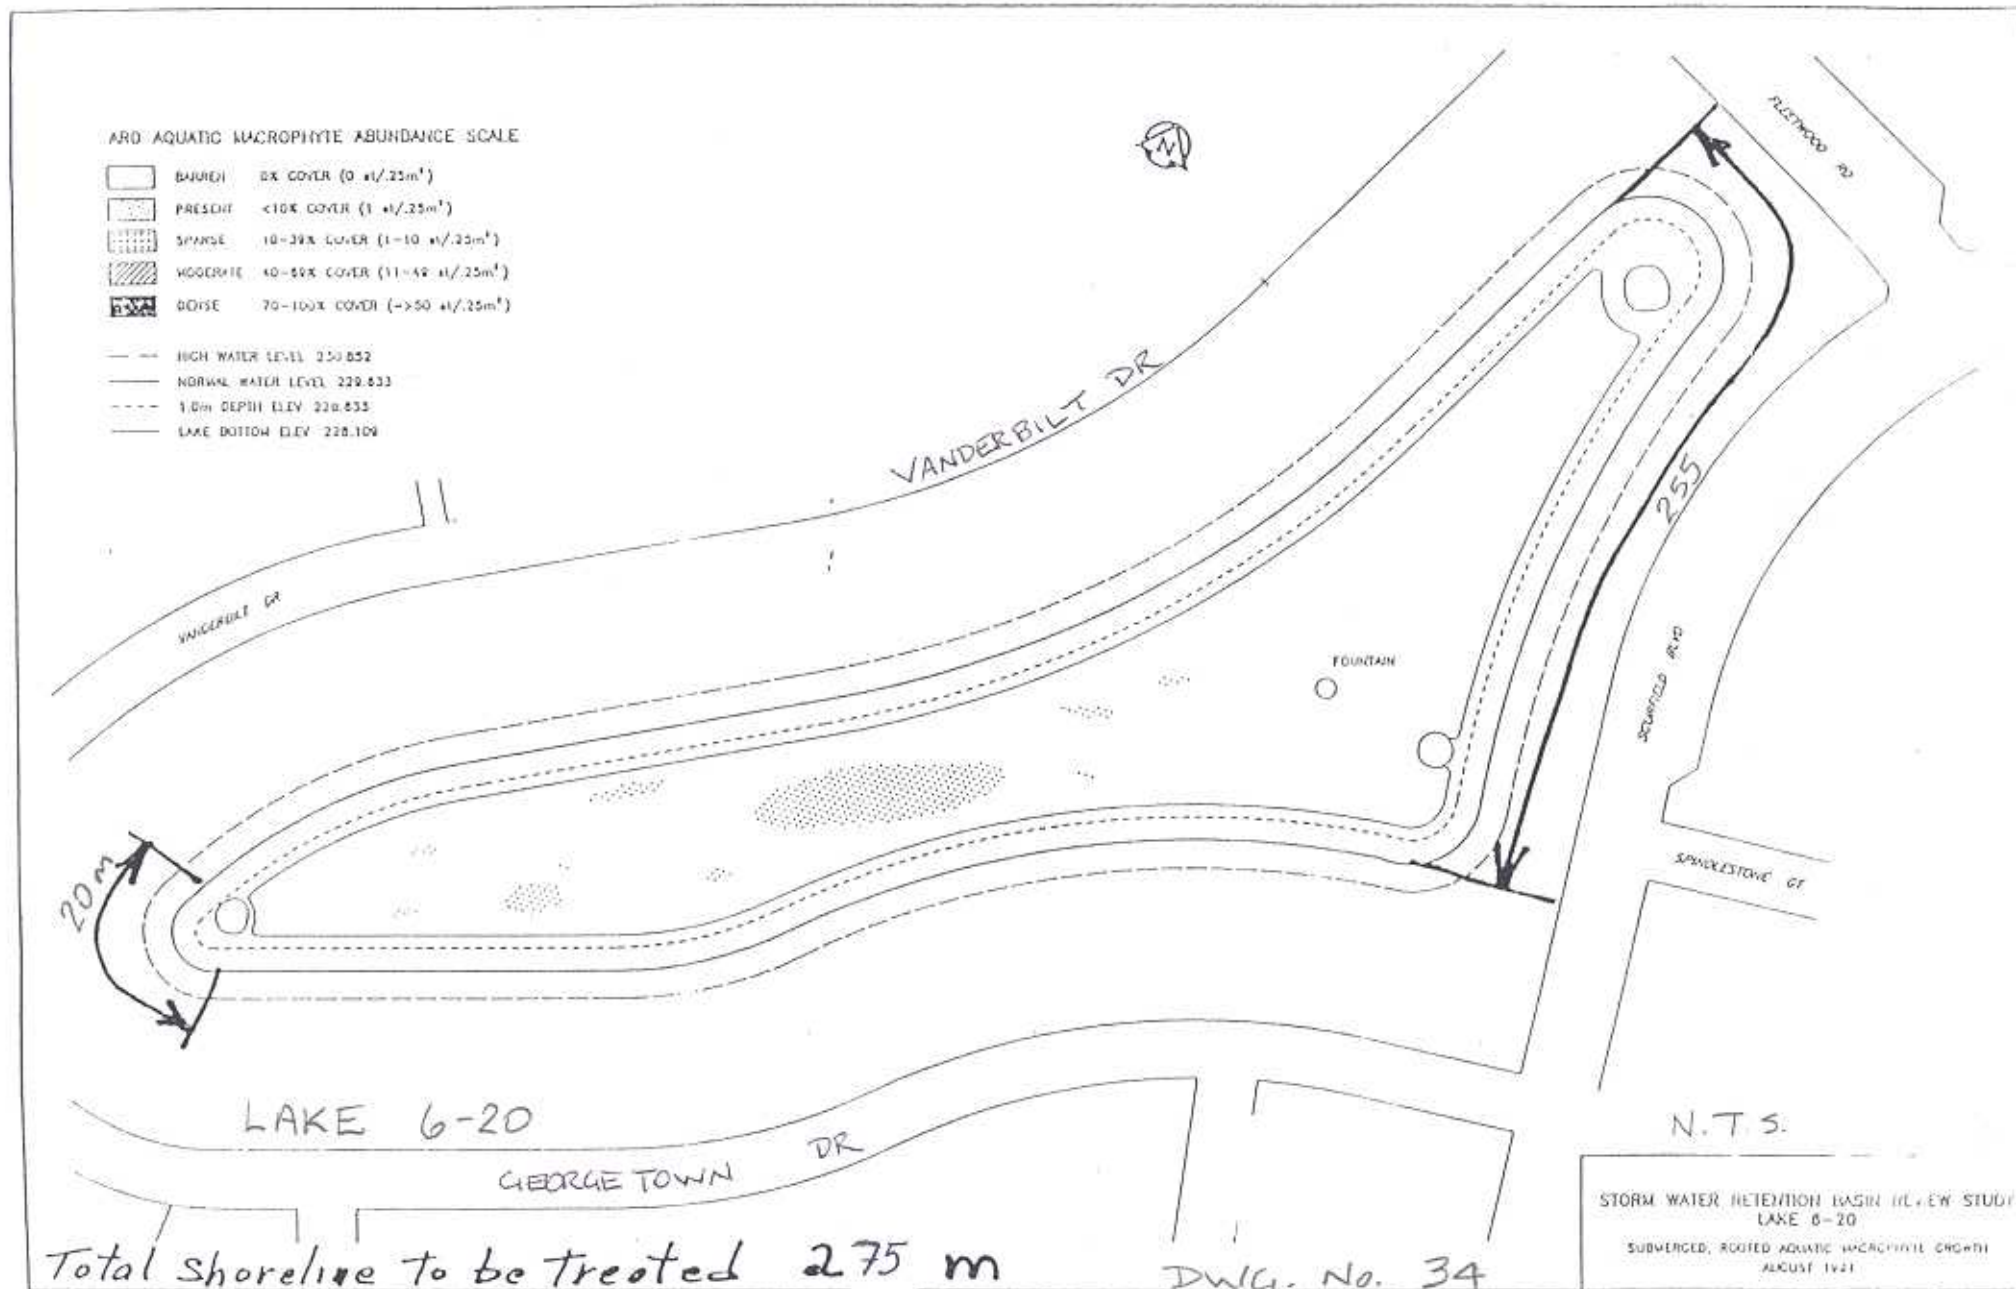

Total Shoreline to be treated 275 m

DWG. No. 34

N.T.S.
STORM WATER RETENTION BASIN REVIEW STUDY
LAKE 6-20
SUBMERGED, ROOTED AQUATIC MACROPHYTE GROWTH
AUGUST 1991