




TOTAL SHORELINE TO BE TREATED = 390 M
LAKE 4-6

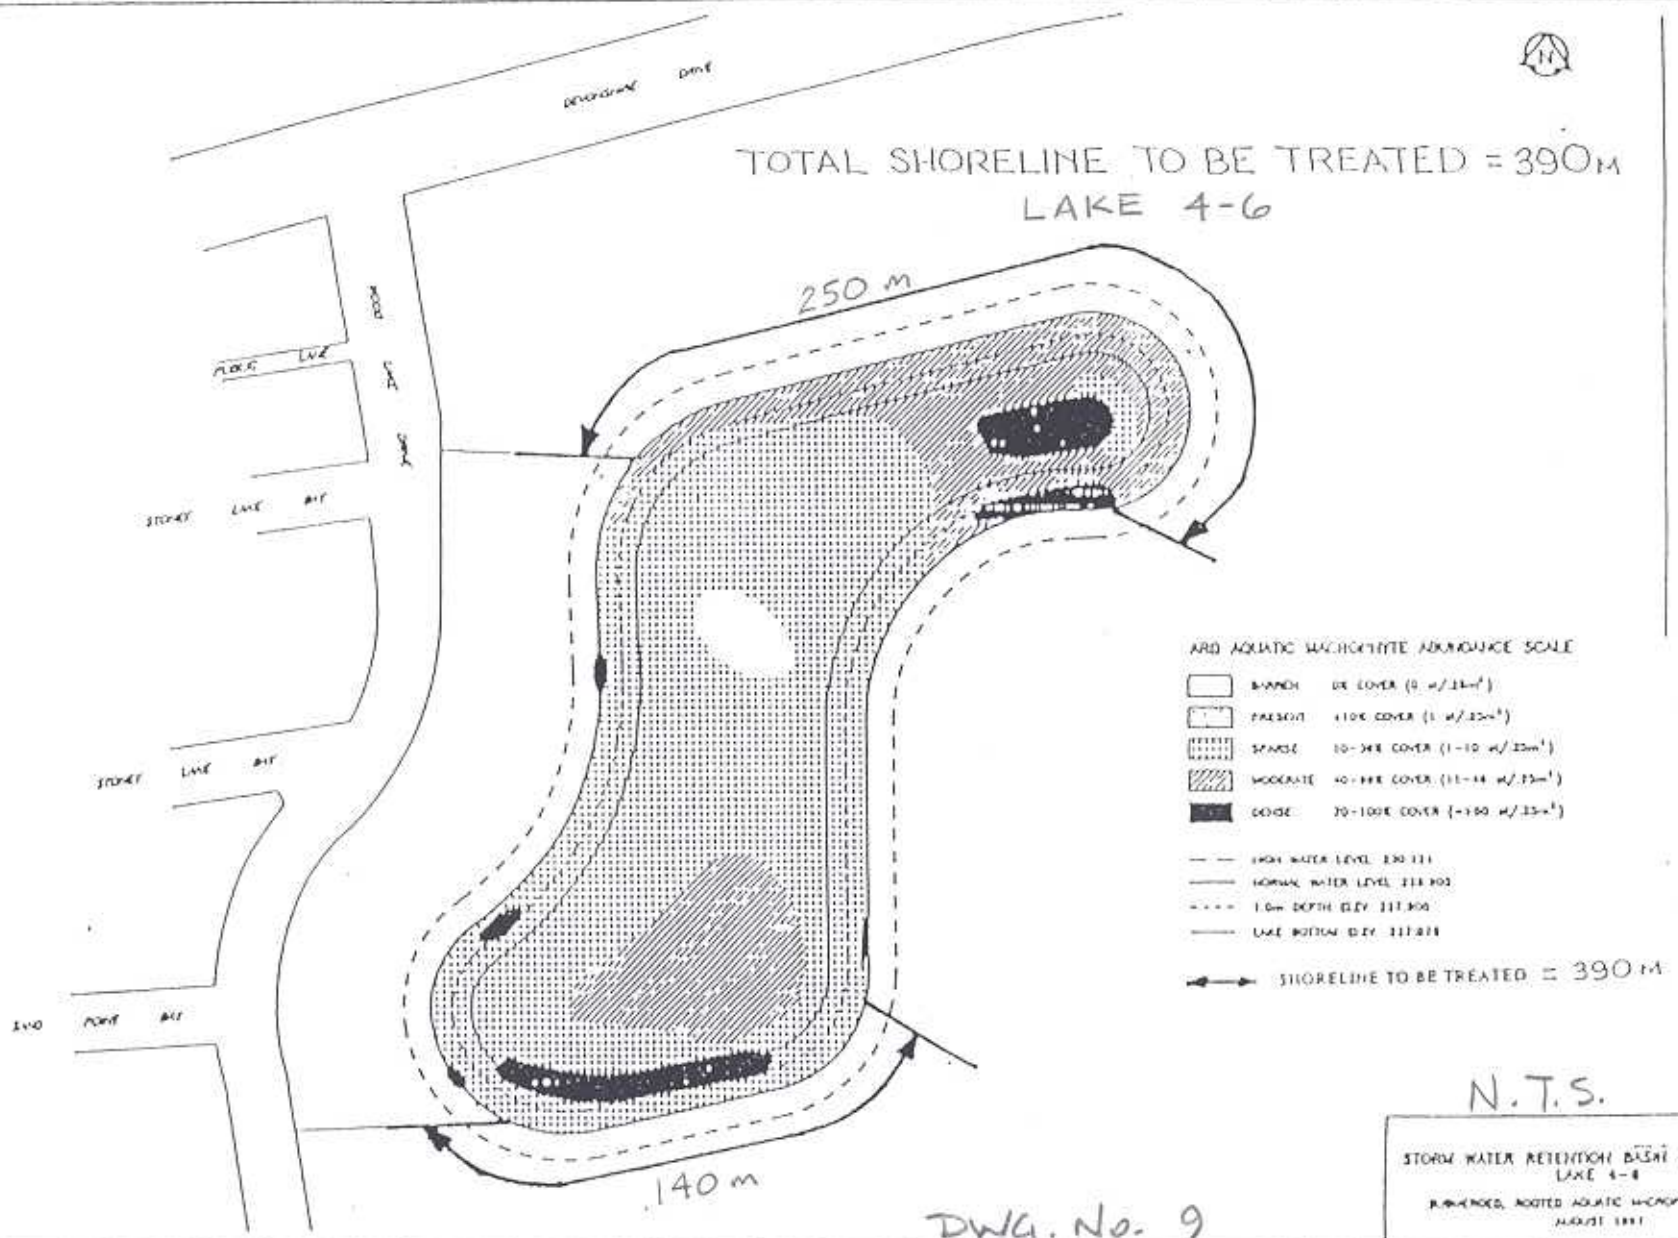

N.T.S.

STORM WATER RETENTION BASIN REVIEW ST
LAKE 4-6

DWG. No. 9