




J DETAIL
WT-S015 1:25

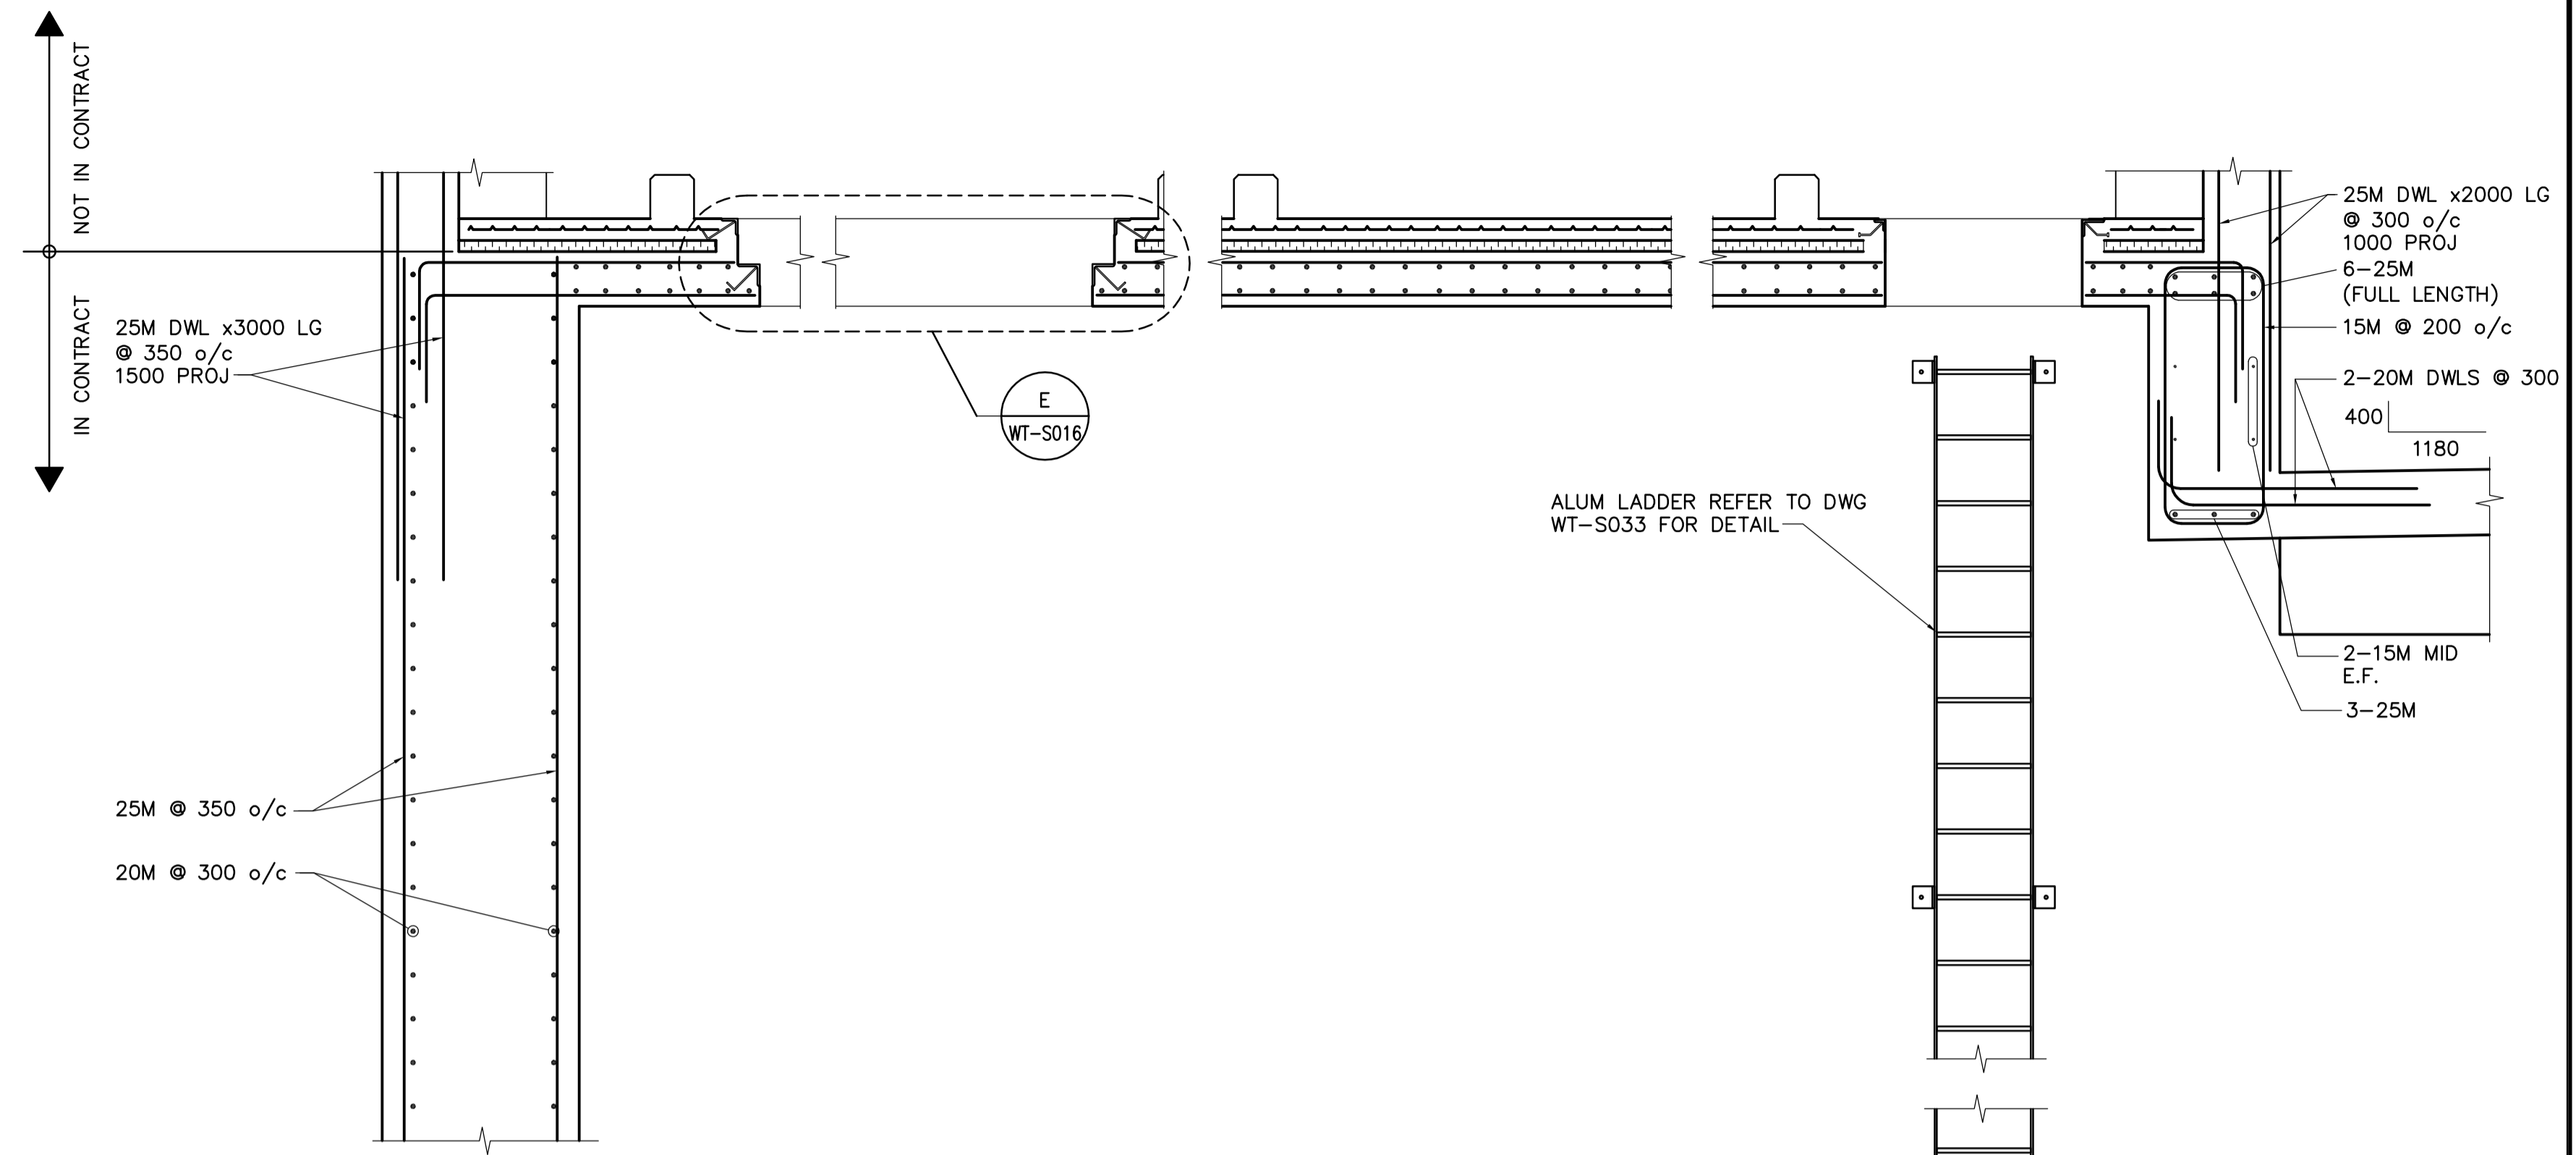

E DETAIL
WT-S016 1:25

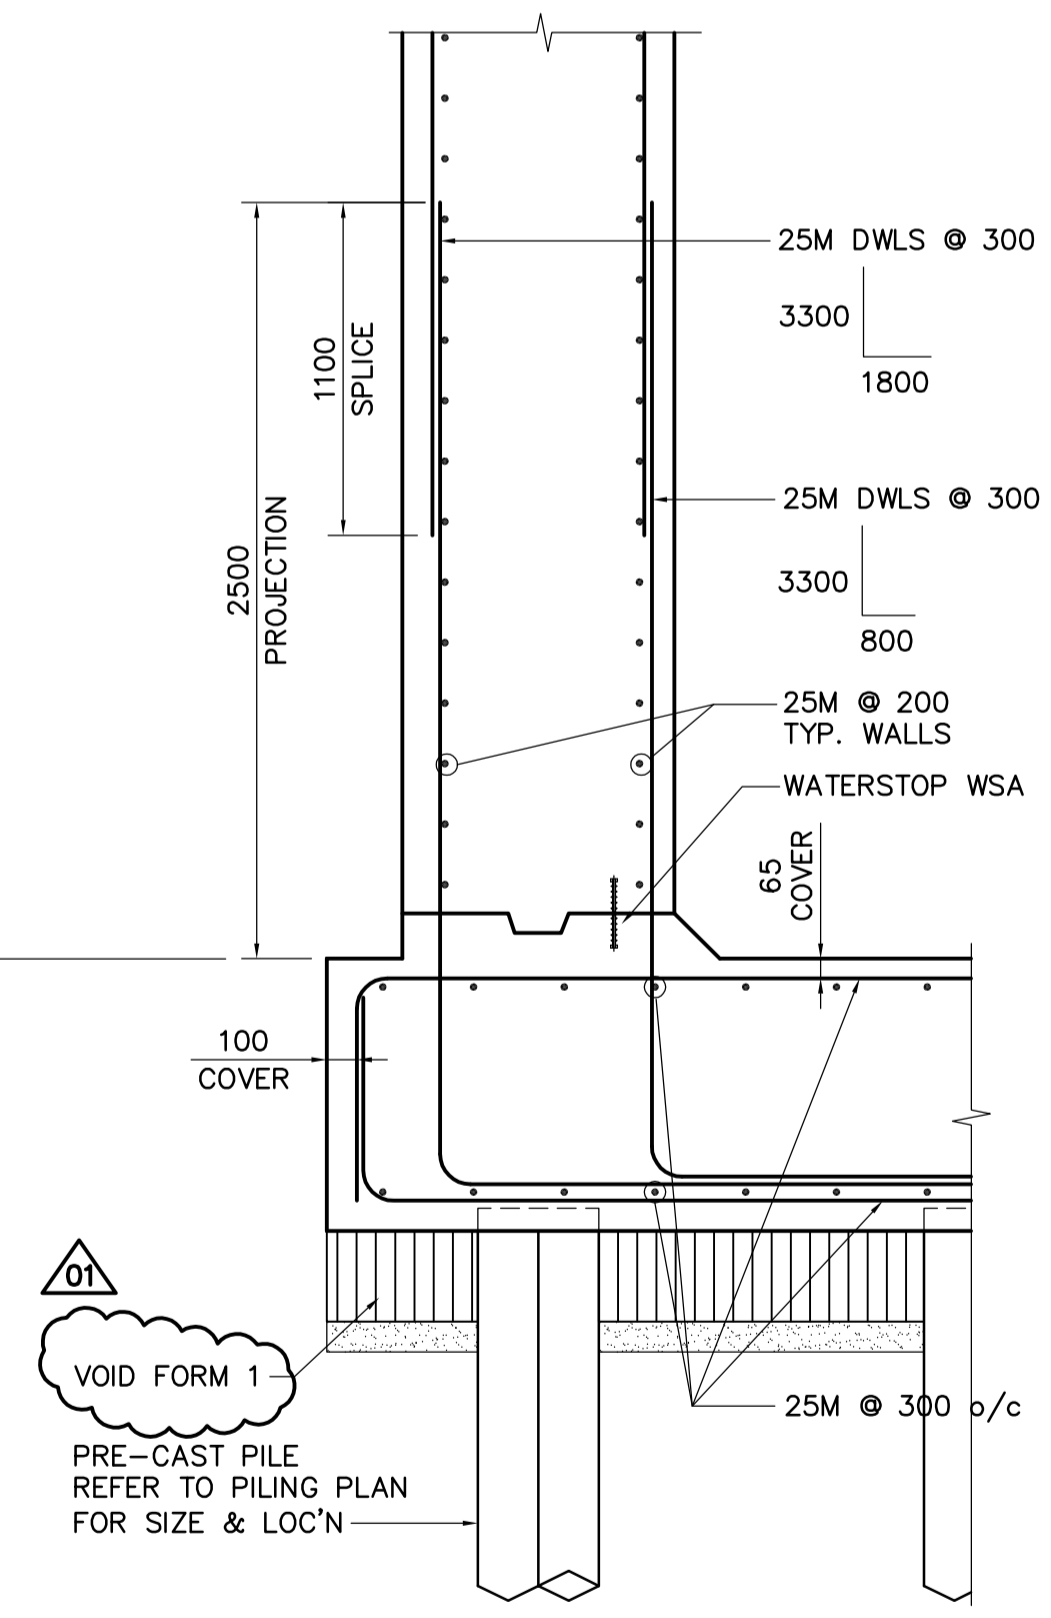

K DETAIL
WT-S015 1:25

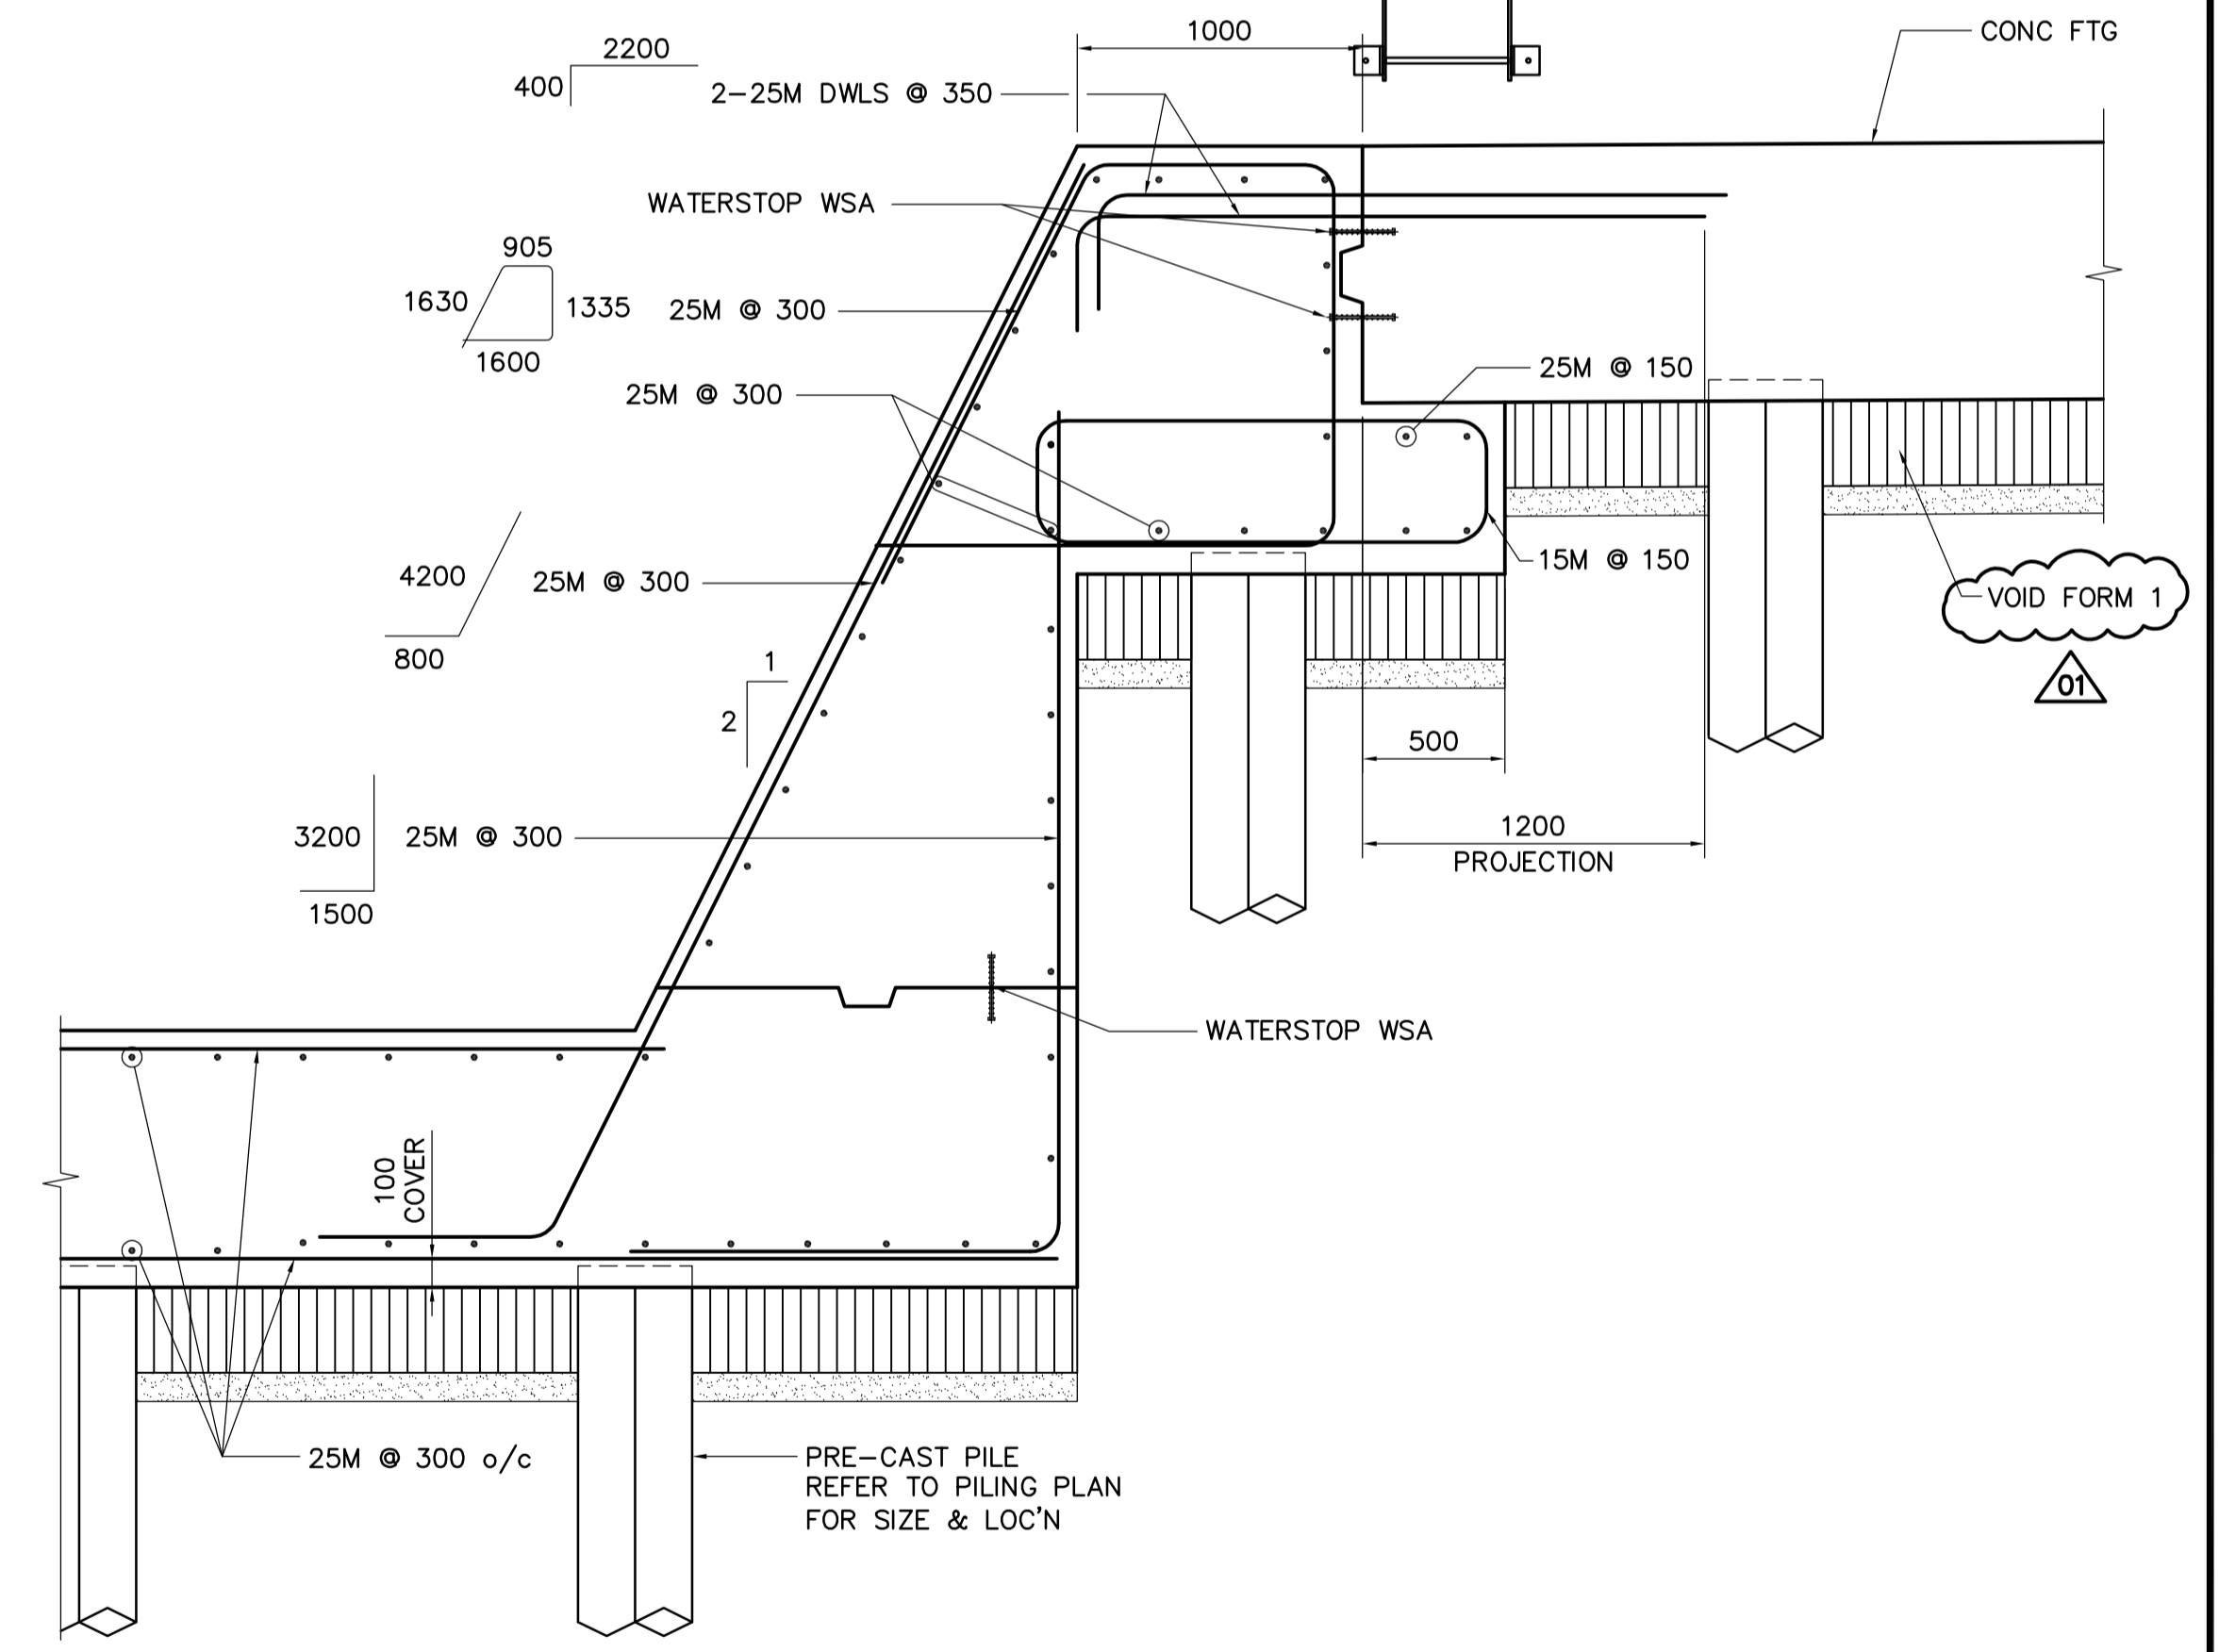

L DETAIL
WT-S015 1:25

DRAWING NOTES:
1. REFER TO DRAWING WT-S001 FOR GENERAL NOTES.



B.M. ELEV.			
DESIGNED BY	FK	CHECKED BY	MK
DRAWN BY	C.T. / WDB	APPROVED BY	AHL
01	166-2005 ADDENDUM 1	05/05/06	C.T.
00	ISSUED FOR TENDER	05/04/17	C.T.
NO.	REVISIONS	DATE	BY

CH2MHILL	EarthTech		
Frederickson Cooper ARCHITECTS	A Tech International Ltd. Company		
DESIGNED BY	FK	CHECKED BY	MK
DRAWN BY	C.T. / WDB	APPROVED BY	AHL
HOR. SCALE:	AS NOTED	RELEASED FOR CONSTRUCTION BY:	R. SOROKOWSKI
VERTICAL SCALE:		DATE	2005-04-17

ENGINEER'S SEAL
ORIGINAL SIGNED BY
F.A. KEMP & R.B. ERIC
2005/04/17
CONSULTANT DRAWING NO. WT-S018

THE CITY OF WINNIPEG
WATER AND WASTE DEPARTMENT
ENGINEERING DIVISION

WATER TREATMENT PLANT CLEARWELL CONSTRUCTION

STRUCTURAL SECTIONS AND DETAILS

CITY FILE NUMBER
SHEET OF
CITY DRAWING NUMBER
1-060TT-A-80018-001-01D