

PILING PLAN
1:200

LEGEND
○ - EXISTING TEST PRECAST PILES

APECM
Certificate of Authorization
Earth Tech Canada Inc.
No. 730 Expiry: April 30, 2006

B.M. ELEV.			
DESIGNED BY	FK	CHECKED BY	MK
DRAWN BY	C.T.	APPROVED BY	AHL
HOR. SCALE:	AS NOTED	RELEASED FOR CONSTRUCTION BY:	R. SOROKOWSKI
VERTICAL SCALE:		DATE	2005-04-17
NO. REVISIONS	DATE	BY	
01	166-2005 ADDENDUM 1	05/05/06	C.T.
00	ISSUED FOR TENDER	05/04/17	C.T.

CH2MHILL
Frederickson Cooper
ARCHITECTS

EarthTech
A Tyco International Ltd. Company

ENGINEER'S SEAL
ORIGINAL SIGNED BY
F.A. KEMP
2005/04/17


CONSULTANT DRAWING NO.
WT-S002

THE CITY OF WINNIPEG
WATER AND WASTE DEPARTMENT
ENGINEERING DIVISION

WATER TREATMENT PLANT CLEARWELL CONSTRUCTION

STRUCTURAL OVERALL PILING PLAN

CITY FILE NUMBER
SHEET OF
CITY DRAWING NUMBER
1-060T-B-S0002-001-01D

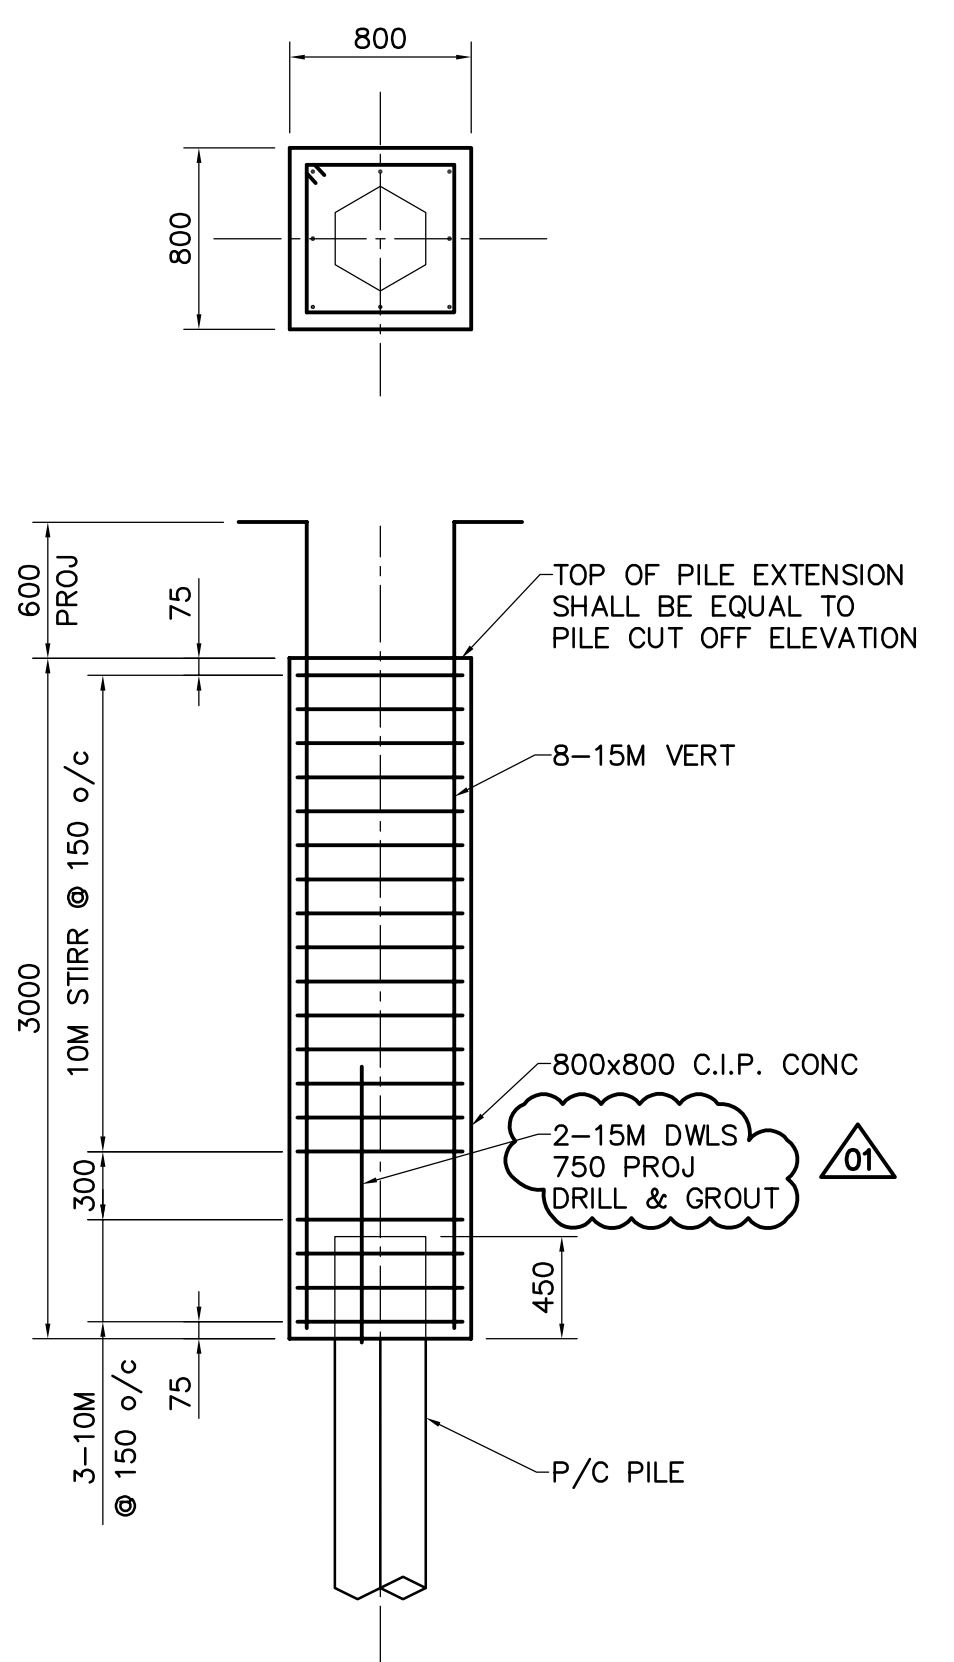

TYPICAL PILE EXTENSION DETAIL
N.T.S.

DRAWING NOTES:
1. ALL PILES ARE 400 DIAMETER PRECAST UNLESS NOTED OTHERWISE.