

FLOOR PLAN – POWER & SYSTEMS  
 SCALE: 1/8" = 1'-0"


5502E3.DWG – APRIL 20, 2005 – 9:53AM CST

GENERAL NOTES:

ALL EXISTING ELECTRICAL OUTLETS, FIXTURES, WIRING, CONDUIT, ETC. TO REMAIN ARE NOT NECESSARILY SHOWN ON DRAWINGS.

DRAWING NOTES:

- 1 CHIP EXISTING CONCRETE AS REQUIRED FOR INSTALLATION OF RECTANGULAR WOOD FLOOR BOX.
- 2 FOR VOICE/DATA OUTLET, PROVIDE 3/4" CONDUIT TO TERMINATE AT TELEPHONE SERVICE POINT IN MECHANICAL ROOM 107.
- 3 REMOVE EXISTING BREAKERS FOR CIRCUITS 13 AND 14 FROM PANEL '100'; REPLACE WITH 70A-2P BREAKER TO FEED SUBPANEL '200'; REWIRE CIRCUITS 13 AND 14 FROM PANEL '100' TO CIRCUITS 1 AND 2 IN NEW SUBPANEL '200'.
- 4 INSTALL NEW WIREMOLD SERIES 505 SERVICE FITTINGS, PEDESTAL MOUNTED.

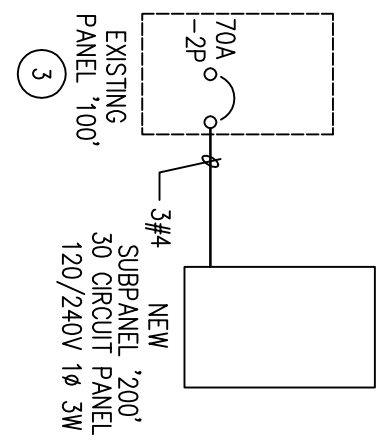

ORIGINAL  
 CONTRACT DRAWING  
 SIGNED AND SEALED BY  
 B.D. LESKO, P. ENG  
 MARCH 24, 2005



PROJECT TITLE  
 LIVING PRAIRIE MUSEUM  
 2795 NESS AVE

SHEET TITLE  
 FLOOR PLAN –  
 POWER & SYSTEMS



SMS Engineering Ltd. Consulting Engineers  
 770 Bradford Street Winnipeg MB Canada R3H 0N3  
 Telephone 204.775.0291 Fax 204.772.2153  
 sms@smseng.com

GERALD A. KORZENIOWSKI  
 ARCHITECT INC.  
 218 OVERDALE STREET  
 WINNIPEG, MB. R3J 2G3  
 PHONE: (204)832-8666  
 FAX: (204)889-1030

SCALE 1/8" = 1'0"	DATE MAY 2005	DRAWN CM	FILE NO. 2417	SHEET NO. E-3 R1
----------------------	------------------	-------------	------------------	---------------------