

- ISSUED FOR 50% REVIEW FEBRUARY 05, 2004
- ISSUED FOR 75% REVIEW MARCH 04, 2004
- ISSUED FOR 85% PRE-TENDER REVIEW APRIL 2004
- ISSUED FOR TENDER MAY 14, 2004
- ISSUED FOR ADDENDUM 1 JUNE 16, 2004

REVISIONS AS PER ADDENDUM 1  
 SUMMARY DOCUMENT

Drawings and specifications, as instruments of service and the property of the architect, the copyright in the same being reserved for him. No reproduction may be made without the permission of the architect and when made, must bear the name of the architect as recorded in the architect's register.  
 The contractor shall verify dimensions and data noted herein with conditions on the site and is held responsible for reporting any discrepancies to the architect for adjustment.  
 This drawing shall not be used for building purposes until counterchecked by:


THE CITY OF WINNIPEG

OFFICE ADDITION AND RENOVATION  
 1155 PACIFIC AVENUE  
 WINNIPEG, MANITOBA



MAIN FLOOR PLAN PART A

A2.5R1

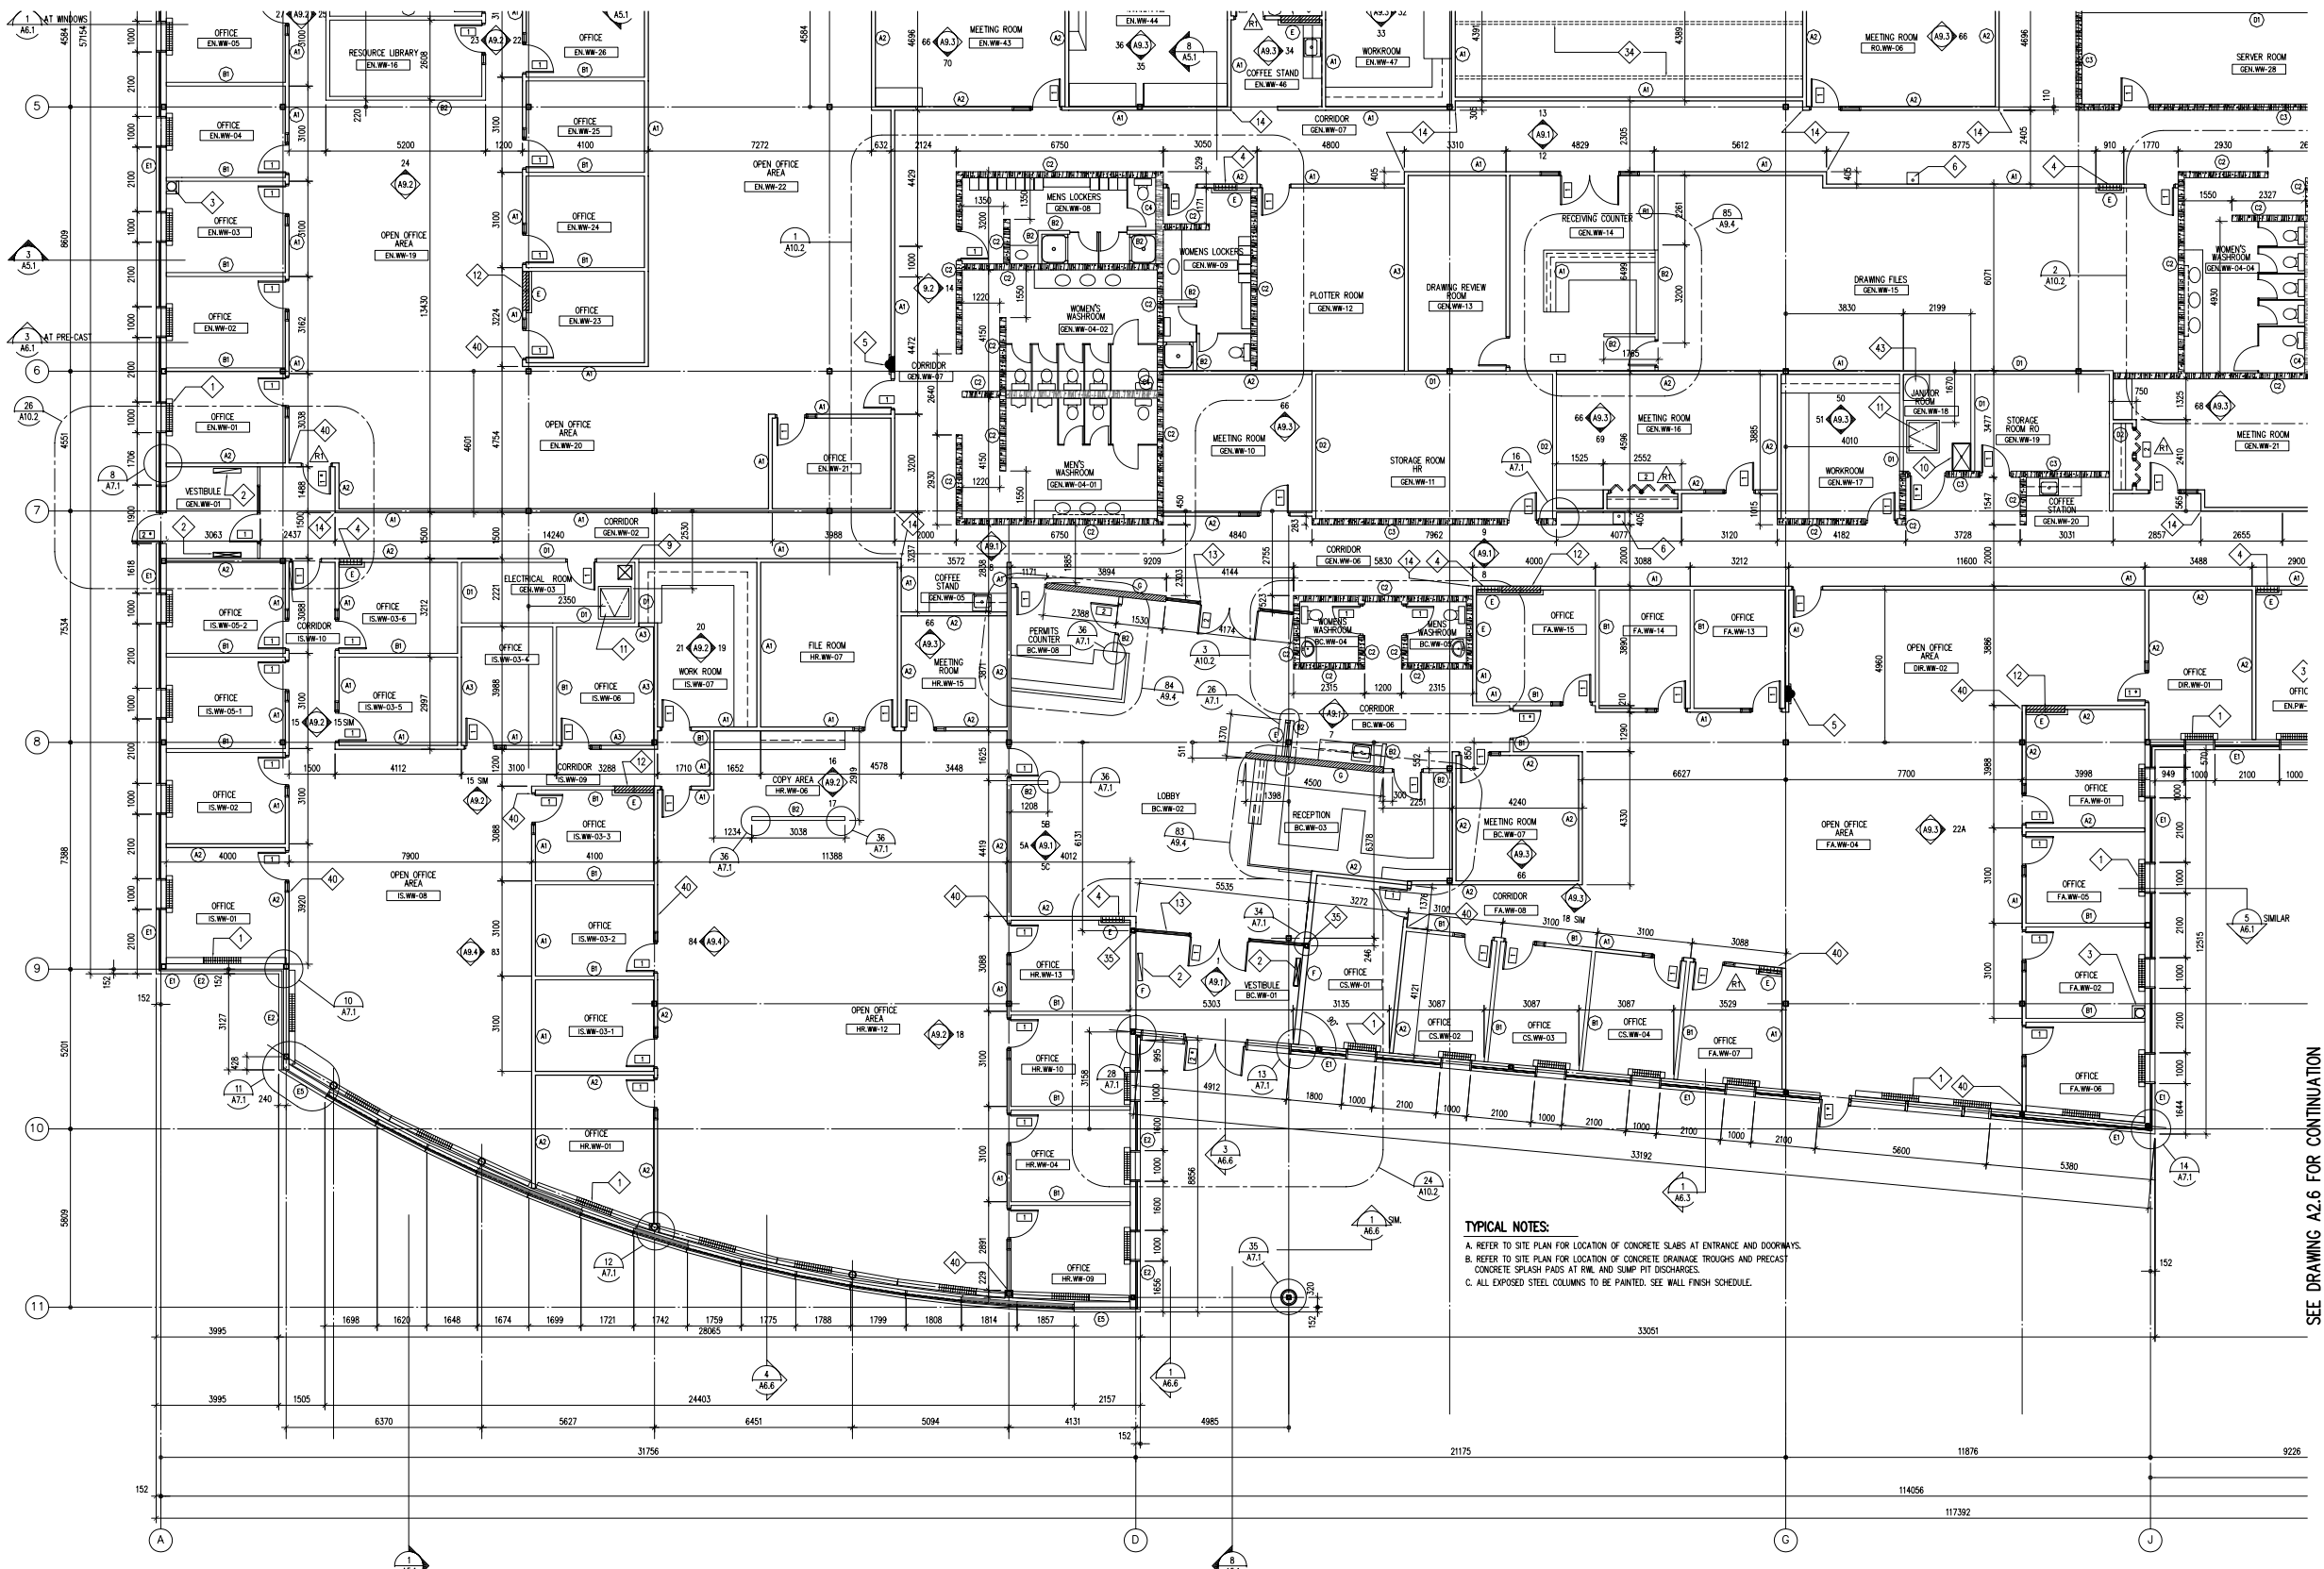

**TYPICAL NOTES:**  
 A. REFER TO SITE PLAN FOR LOCATION OF CONCRETE SLABS AT ENTRANCE AND DOORWAYS.  
 B. REFER TO SITE PLAN FOR LOCATION OF CONCRETE DRAINAGE TROUGHS AND PRECAST CONCRETE SPLASH PADS AT R/W AND SUMP PIT DISCHARGES.  
 C. ALL EXPOSED STEEL COLUMNS TO BE PAINTED. SEE WALL FINISH SCHEDULE.

SEE DRAWING A2.6 FOR CONTINUATION