SHEET: COW-A1 (05/2005)

REF. NORTH
TRUE NORTH

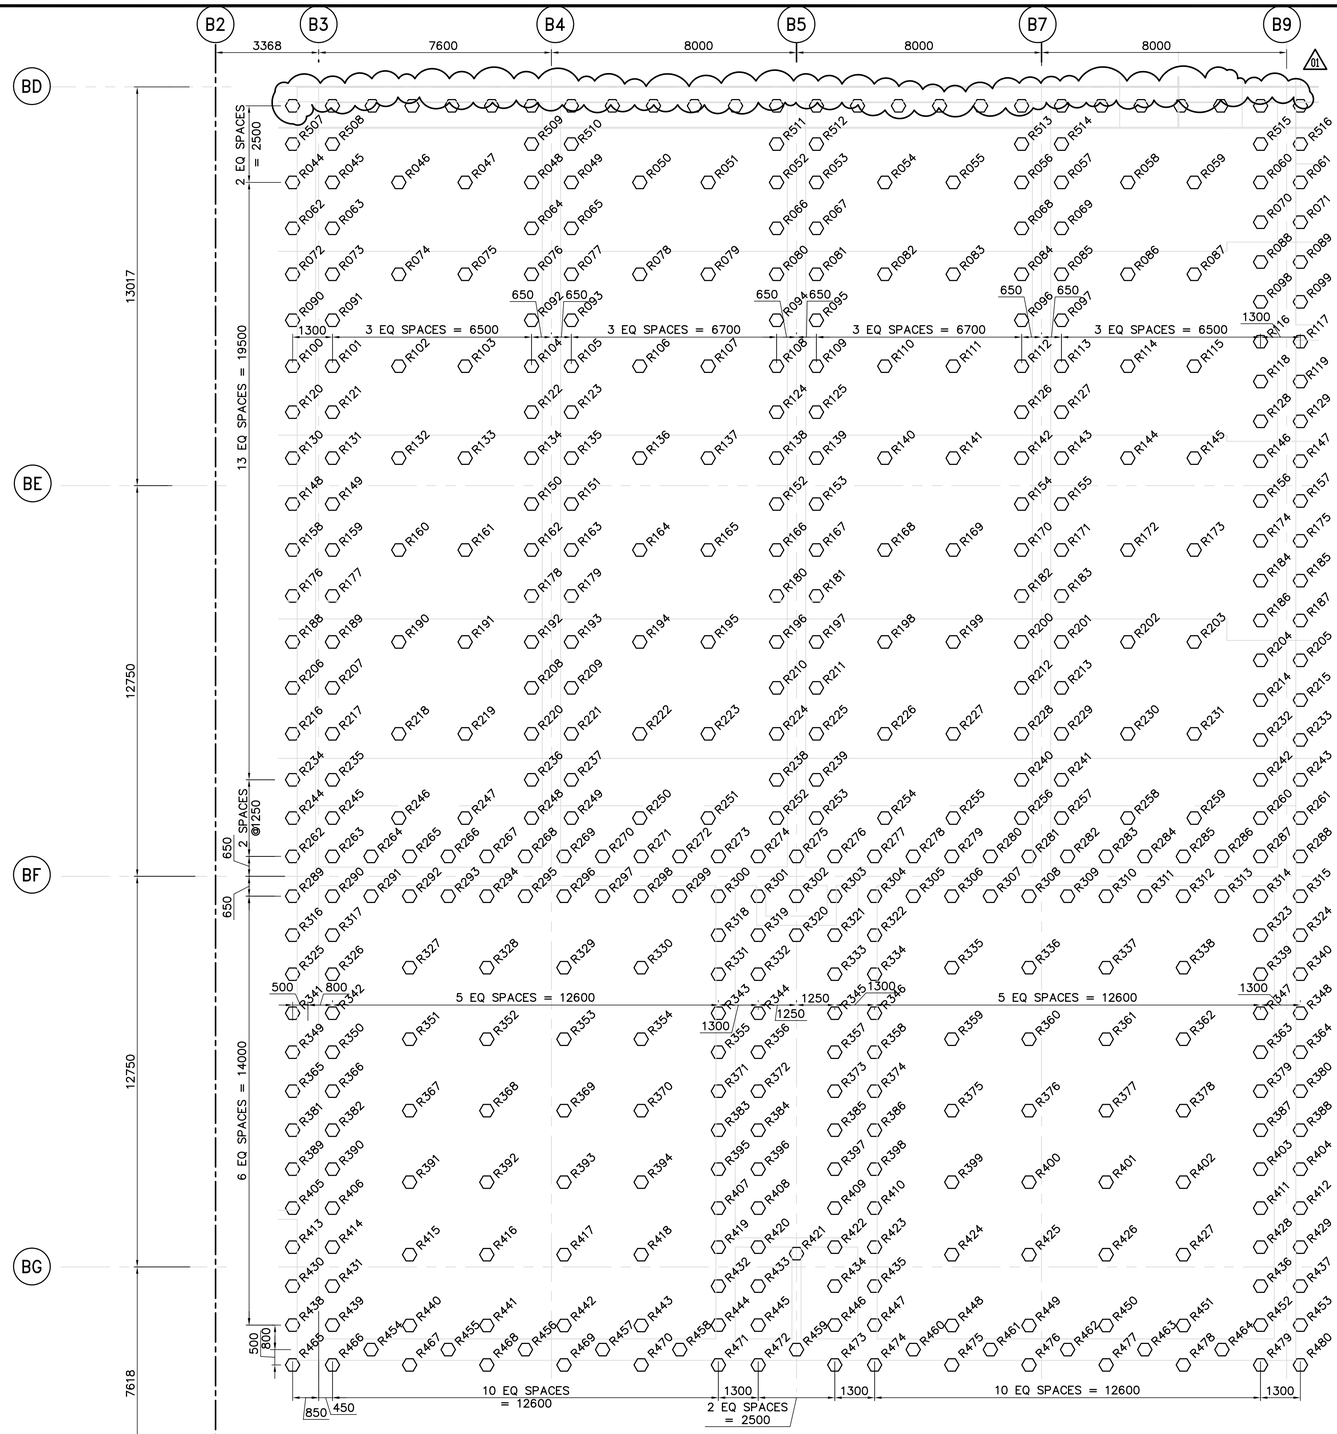

PILING PLAN
1:100

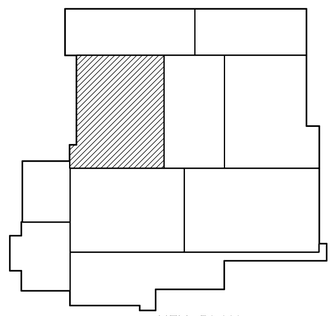

KEY PLAN

SCALE 1:100
SCALE 1:1
METRES 0 2 4 6 8 10
MILLIMETRES 0 20 40 60 80 100

NO.	REVISIONS	DATE	BY
01	ISSUED FOR ADDENDUM 4	05/09/23	MS
00	ISSUED FOR TENDER	05/09/12	MS

B.M.
ELEV.

CH2MHILL
Fredericksen Cooper ARCHITECTS
EarthTech A Tyco International Ltd. Company

DESIGNED BY	DK	CHECKED BY	
DRAWN BY	RRL	APPROVED BY	
SCALE:	1:100	RELEASED FOR CONSTRUCTION BY:	
DATE	2005/08/30	DATE	

ENGINEER'S SEAL

CONSULTANT DRAWING NO.
WR-F0101

THE CITY OF WINNIPEG
WATER AND WASTE DEPARTMENT
ENGINEERING DIVISION

WATER TREATMENT PLANT

SUPPLY AND INSTALLATION OF PILES

STRUCTURAL
RESIDUALS AREA
PILING PLAN

CITY FILE NUMBER
SHEET OF
CITY DRAWING NUMBER
1-0601R-B-F0101-001-00D

Last Save: 2005-09-23 8:14 PM

C:\DOCUMENTS AND SETTINGS\SEVERITT\MY DOCUMENTS\NDMPROJ\321352 - WINNIPEGWTP\DN_WR-F0101_CH2M-01.DWG