


**A SECTION**  
 WC-S0111 1:50  
 WC-S0121, WC-S0131  
 WC-S0141, WC-F0105  
 WC-S0146

**NOTES:**

- SEE PLANS FOR SLAB REINFORCEMENT.
- FOR FOUNDATION WALL WATERPROOFING AND INSULATION REFER TO DWG WC-S0461

01 BACKGROUND HIDDEN LINES REVISED OR SHOWN FOR CLARITY.

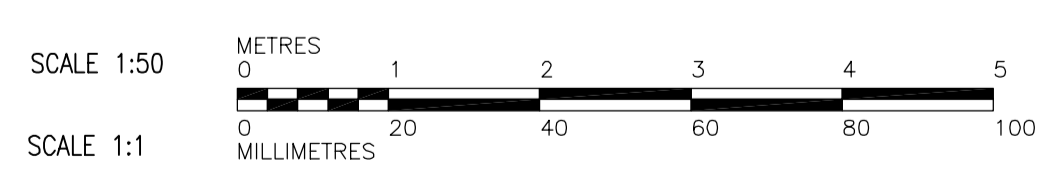

**APECA**  
 Certificate of Authorization  
 CH2M HILL Canada Ltd.  
 No. 1441 Expiry: April 30, 2006

NO.	REVISIONS	DATE	BY
01	583-2005 ADDENDUM 3	06/03/10	EL
00	ISSUED FOR TENDER	2006/02/03	EL

**CH2MHILL**  
 Frederickson Cooper  
 ARCHITECTS

**EarthTech**  
 A Yeo International Ltd. Company

DESIGNED BY	EL	CHECKED BY	AP
DRAWN BY	RL/DJ	APPROVED BY	DJT
SCALE:	1:50	RELEASED FOR CONSTRUCTION BY:	R. SOROKOWSKI
DATE	2005/07/29	DATE	2006/02/08

ENGINEER'S SEAL  
 ORIGINAL SIGNED BY  
 D. KRUGER  
 2006/02/06  
 CONSULTANT DRAWING NO.  
 WC-S0201

**THE CITY OF WINNIPEG**  
 WATER AND WASTE DEPARTMENT  
 ENGINEERING DIVISION

WATER TREATMENT PLANT  
 CHEMICAL FEED SYSTEMS  
 FOUNDATIONS AND CONCRETE STRUCTURES

STRUCTURAL  
 CHEMICAL AREA  
 SECTION

CITY FILE NUMBER  
 SHEET OF  
 CITY DRAWING NUMBER  
**1-0601C-A-90201-001-0D**