


D SECTION
WC-S0111 1:50

WC-S0121, WC-S0131
WC-S0141, WC-F0105
WC-S0146

01 BACKGROUND HIDDEN LINES REVISED OR SHOWN FOR CLARITY.

NOTE:
1. SEE PLANS FOR SLAB REINFORCEMENT.

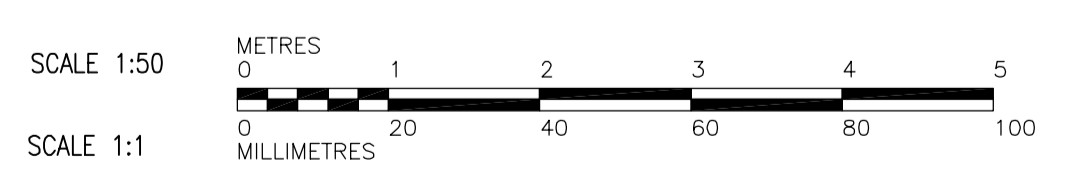

APECA
Certificate of Authorization
CH2M HILL Canada Ltd.
No. 1441 Expiry: April 30, 2006

NO.	REVISIONS	DATE	BY
01	583-2005 ADDENDUM 3	06/03/10	EL
00	ISSUED FOR TENDER	2006/02/03	EL

CH2MHILL Frederickson Cooper ARCHITECTS		EarthTech A Tyco International Ltd. Company	
DESIGNED BY	EL	CHECKED BY	AP
DRAWN BY	RL/DJ	APPROVED BY	DJT
SCALE:	1:50	RELEASED FOR CONSTRUCTION BY:	R. SOROKOWSKI
DATE	2005/07/29	DATE	2006/02/08

ENGINEER'S SEAL
ORIGINAL SIGNED BY
D. KRUGER
2006/02/06
CONSULTANT DRAWING NO.
WC-S0204

THE CITY OF WINNIPEG
WATER AND WASTE DEPARTMENT
ENGINEERING DIVISION

WATER TREATMENT PLANT
CHEMICAL FEED SYSTEMS
FOUNDATIONS AND CONCRETE STRUCTURES

STRUCTURAL
CHEMICAL AREA
SECTION

CITY FILE NUMBER
SHEET OF
CITY DRAWING NUMBER
1-0600C-A-80204-001-0D