SHEET: COW-A1 (05/2005)

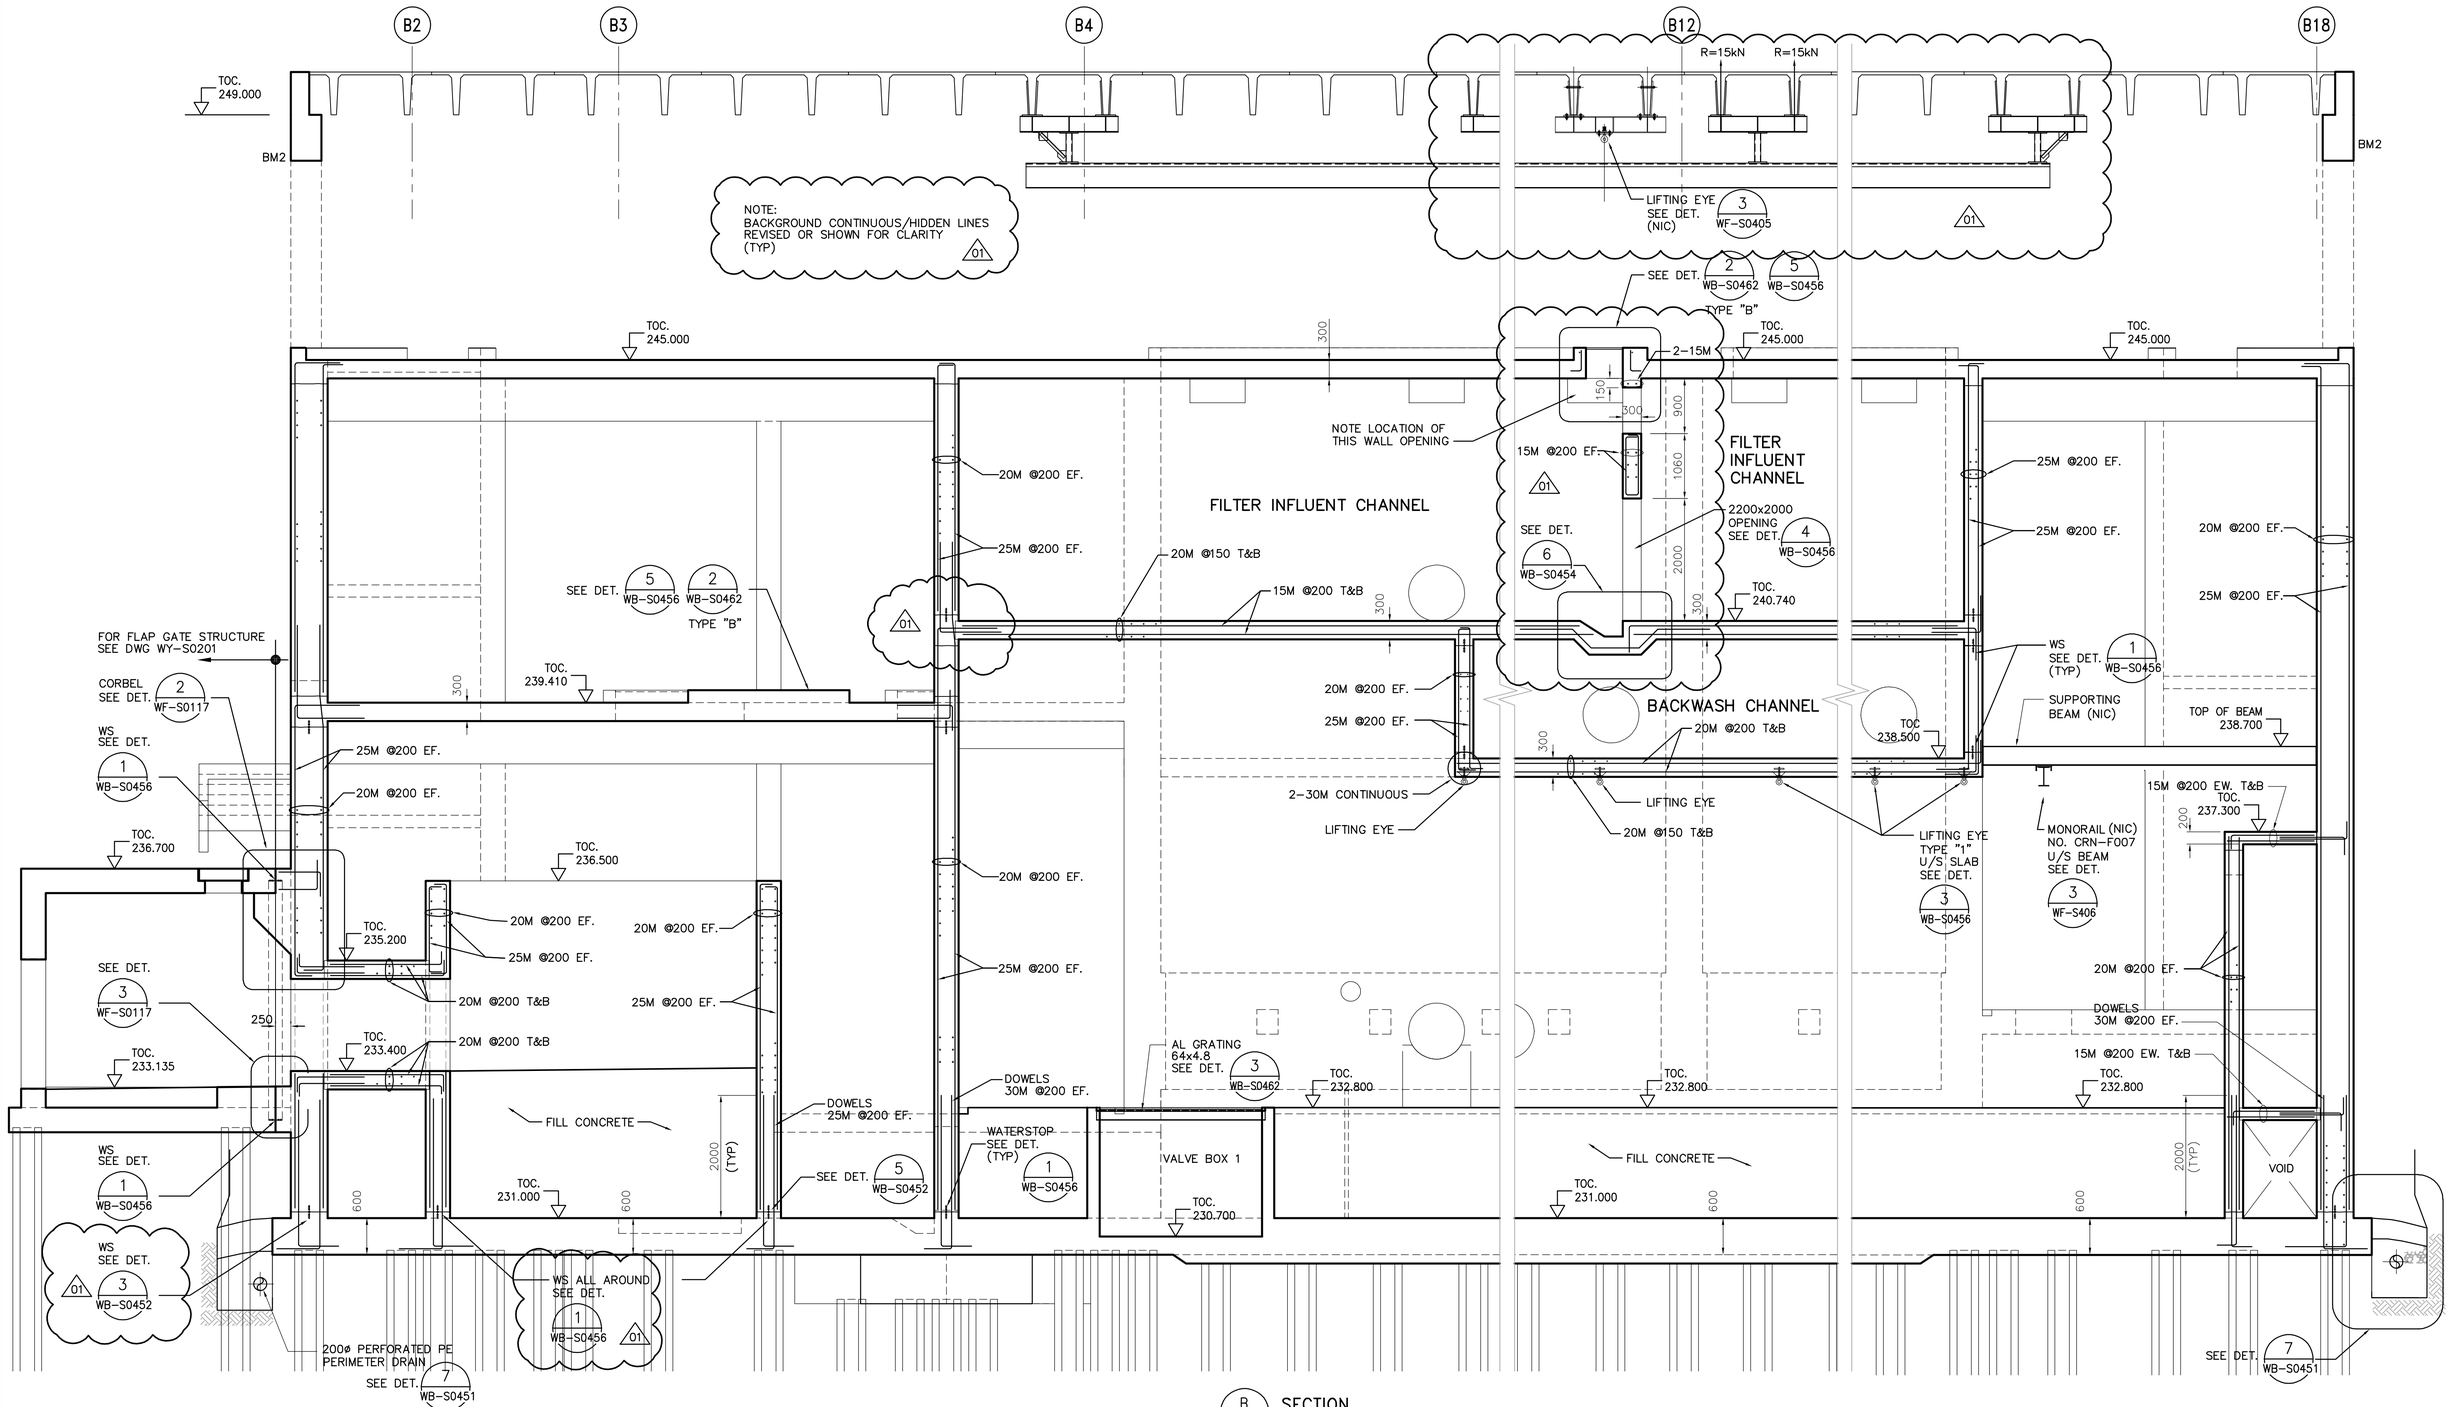


B SECTION WF-S0101 1:50

**NOTE:**

1. MONORAIL BEAM ARE SHOWN FOR INFORMATION ONLY.
2. SEE PLANS FOR SLAB REINFORCEMENT.

WF-S0102 WF-S0105 WF-S0106 WF-S0111 WF-S0112 WF-S0115 WF-S0116 WF-S0117 WF-S0118 WF-S0121 WF-S0122 WF-S0125 WF-S0131 WF-S0132 WF-S0135 WF-S0136 WF-S0141 WF-S0142 WF-S0146 WF-S0147

SCALE 1:50 METRES 0 1 2 3 4 5

SCALE 1:1 0 20 40 60 80 100 MILLIMETRES

APEGM Certificate of Authorization CH2M HILL Canada Ltd. No. 1441 Expiry: April 30, 2006

| NO. | REVISIONS | DATE | BY |
|---|---|---|---|
| 01 | 583-2005 ADDENDUM 3 | 06/03/10 | KA |
| 00 | ISSUED FOR TENDER | 2006/02/03 | KA |

B.M. ELEV.

CH2MHILL Fredericksen Cooper ARCHITECTS — EarthTech A Tyco International Ltd. Company

| | | | |
|---|---|---|---|
| DESIGNED BY | KA | CHECKED BY | AP |
| DRAWN BY | PM | APPROVED BY | DJT |
| SCALE: | 1:50 | RELEASED FOR CONSTRUCTION BY: | R. SOROKOWSKI |
| DATE | 2005/08/10 | DATE | 2006/02/08 |

ENGINEER'S SEAL

ORIGINAL SIGNED BY

D. KRUGER

2006/02/06

CONSULTANT DRAWING NO. WF-S0202

Winnipeg

# THE CITY OF WINNIPEG

## WATER AND WASTE DEPARTMENT ENGINEERING DIVISION

WATER TREATMENT PLANT
FILTRATION
FOUNDATIONS AND CONCRETE STRUCTURES

STRUCTURAL
FILTRATION AREA
SECTION

CITY FILE NUMBER

SHEET OF

CITY DRAWING NUMBER 1-0601F-A-S0202-001-01D

Last Save: 2006-03-13 5:03 PM

P: \EARTHTECH\321352WINNIPEGWTP\NDM\DESIGN\ACAD\583-POSTTENDER\DN_WF-S0202_CH2M.DWG