SHEET: COW-A1 (05/2005)

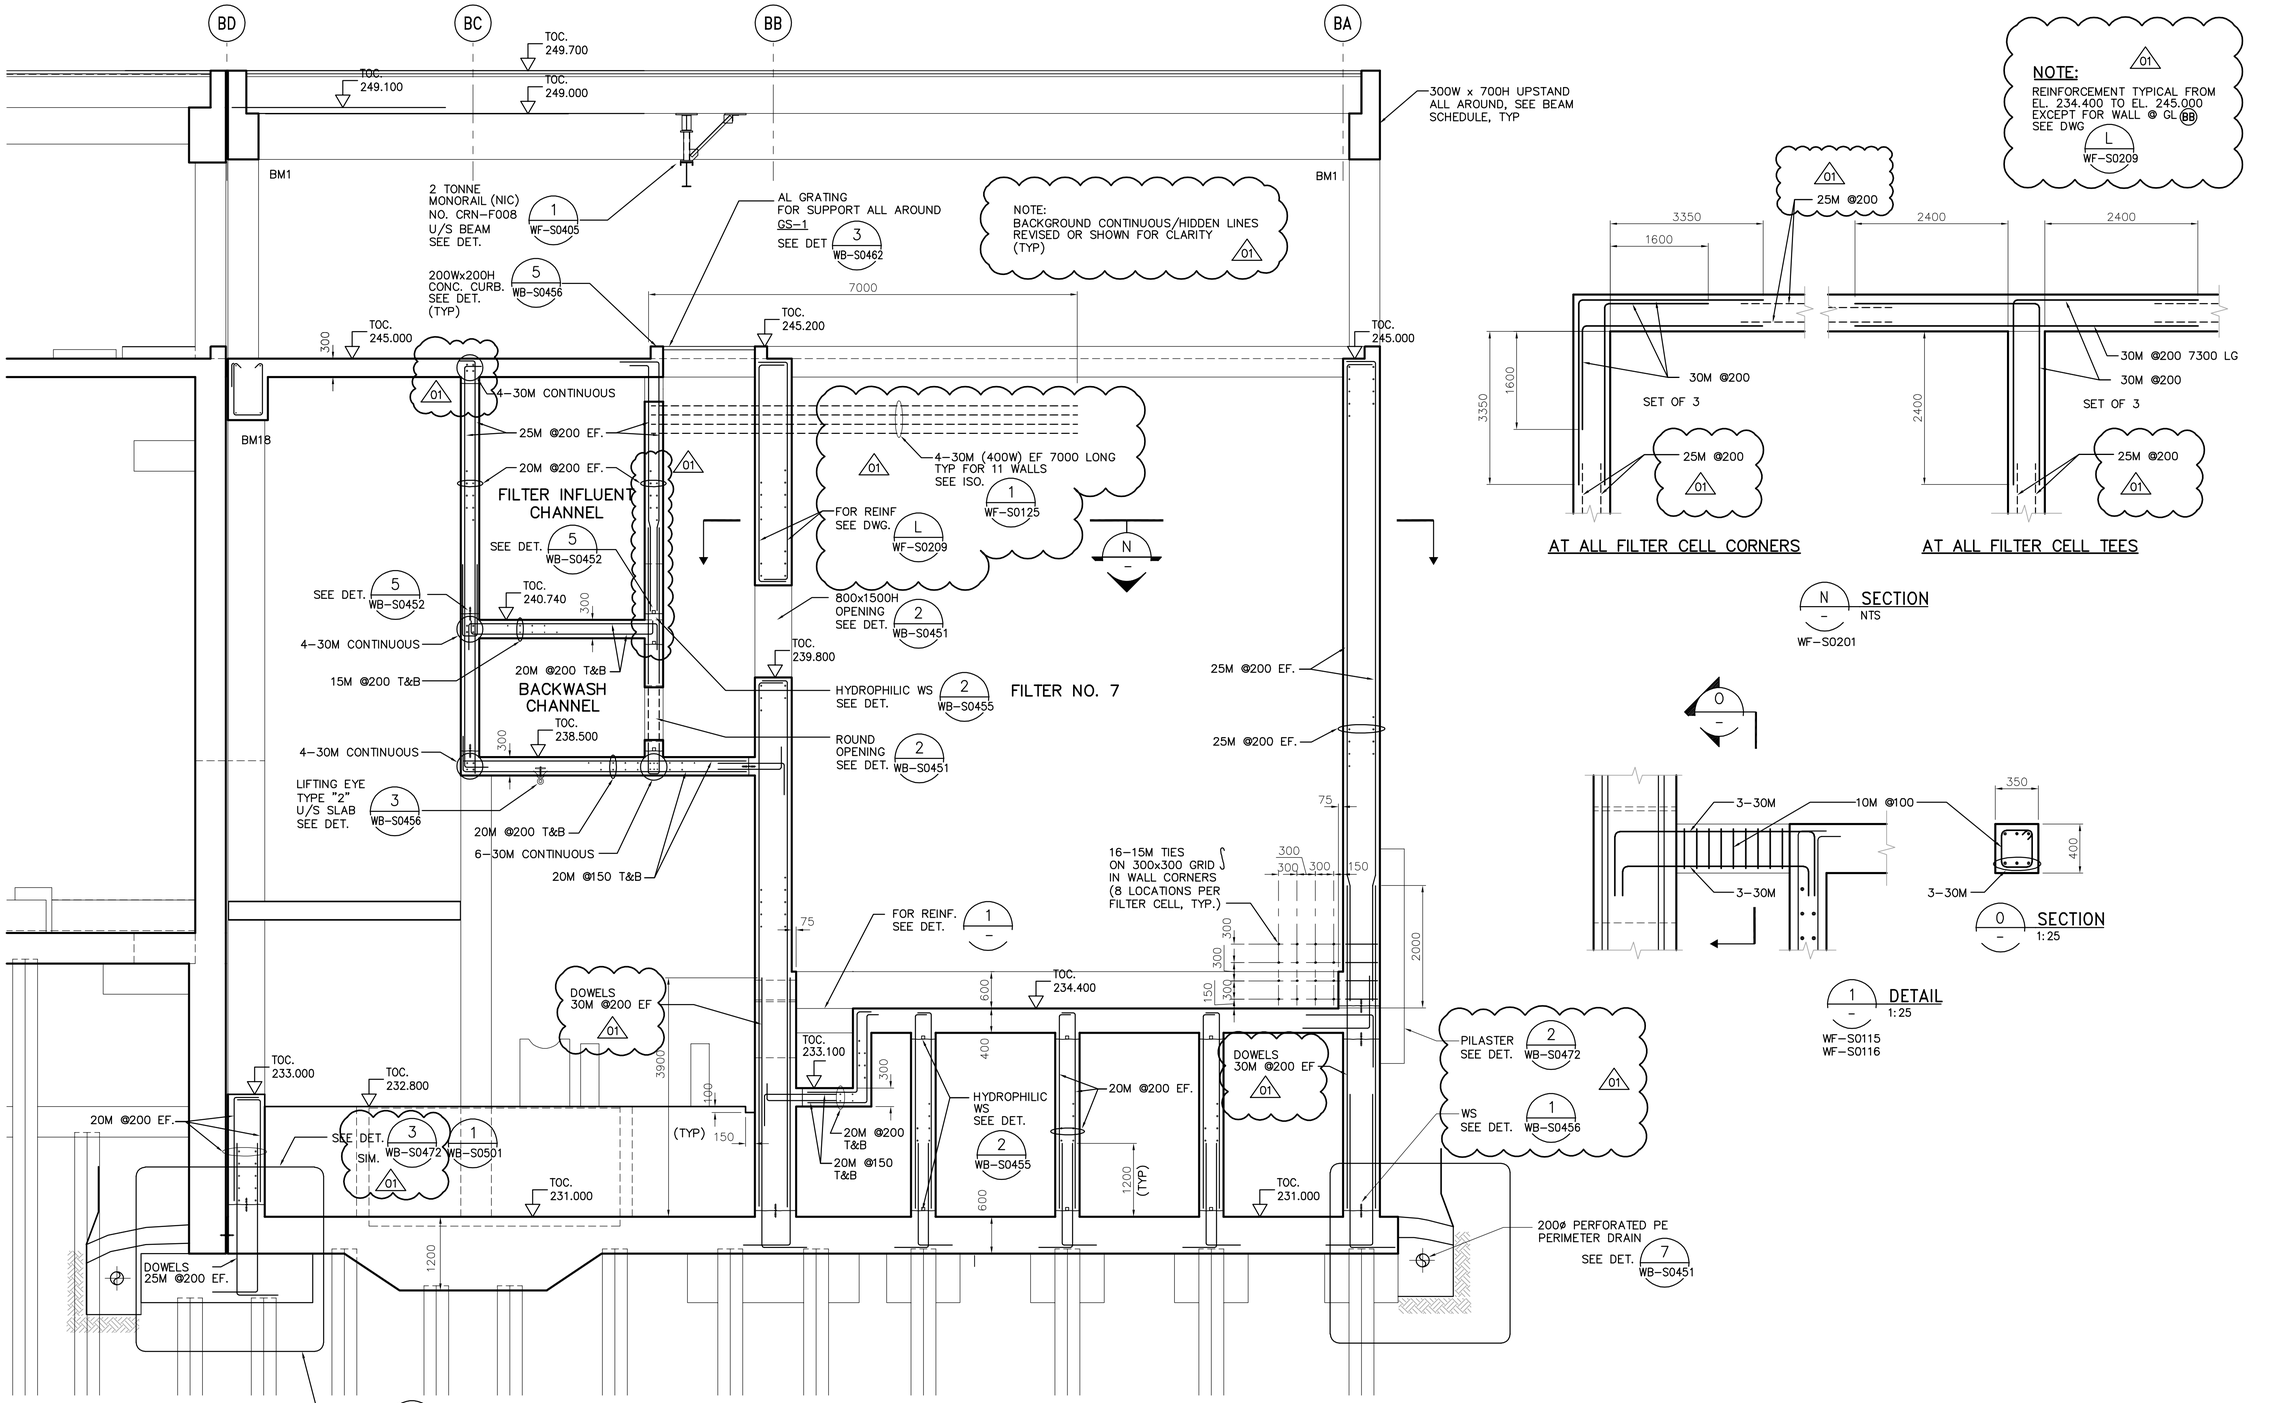

NOTES:
1. SEE PLANS FOR SLAB REINFORCEMENT.

SCALE 1:50 METRES 0 1 2 3 4 5
SCALE 1:1 0 20 40 60 80 100 MILLIMETRES

APEGM
Certificate of Authorization
CH2M HILL Canada Ltd.
No. 1441 Expiry: April 30, 2006

B.M. ELEV.

NO.	REVISIONS	DATE	BY
01	583-2005 ADDENDUM 3	06/03/10	KA
00	ISSUED FOR TENDER	2006/02/03	KA

CH2MHILL
Frederickson Cooper ARCHITECTS
EarthTech A Tyco International Ltd. Company

DESIGNED BY	KA	CHECKED BY	AP
DRAWN BY	PM	APPROVED BY	DJT
SCALE:	1:50	RELEASED FOR CONSTRUCTION BY:	R. SOROKOWSKI
DATE	2005/08/10	DATE	2006/02/08

ENGINEER'S SEAL
ORIGINAL SIGNED BY
D. KRUGER
2006/02/06

CONSULTANT DRAWING NO.
WF-S0206

Winnipeg
THE CITY OF WINNIPEG
WATER AND WASTE DEPARTMENT
ENGINEERING DIVISION

WATER TREATMENT PLANT
FILTRATION
FOUNDATIONS AND CONCRETE STRUCTURES

STRUCTURAL
FILTRATION AREA
SECTIONS

CITY FILE NUMBER
SHEET OF
CITY DRAWING NUMBER
1-0601F-A-S0206-001-01D

Last Save: 2006-03-13 5:03 PM

P:\EARTHTECH\321352WINNIPEGWTP\NDM\DESIGN\ACAD\583-POSTTENDER\DN_WF-S0206_CH2M.DWG