SHEET: COW-A1 (05/2005)

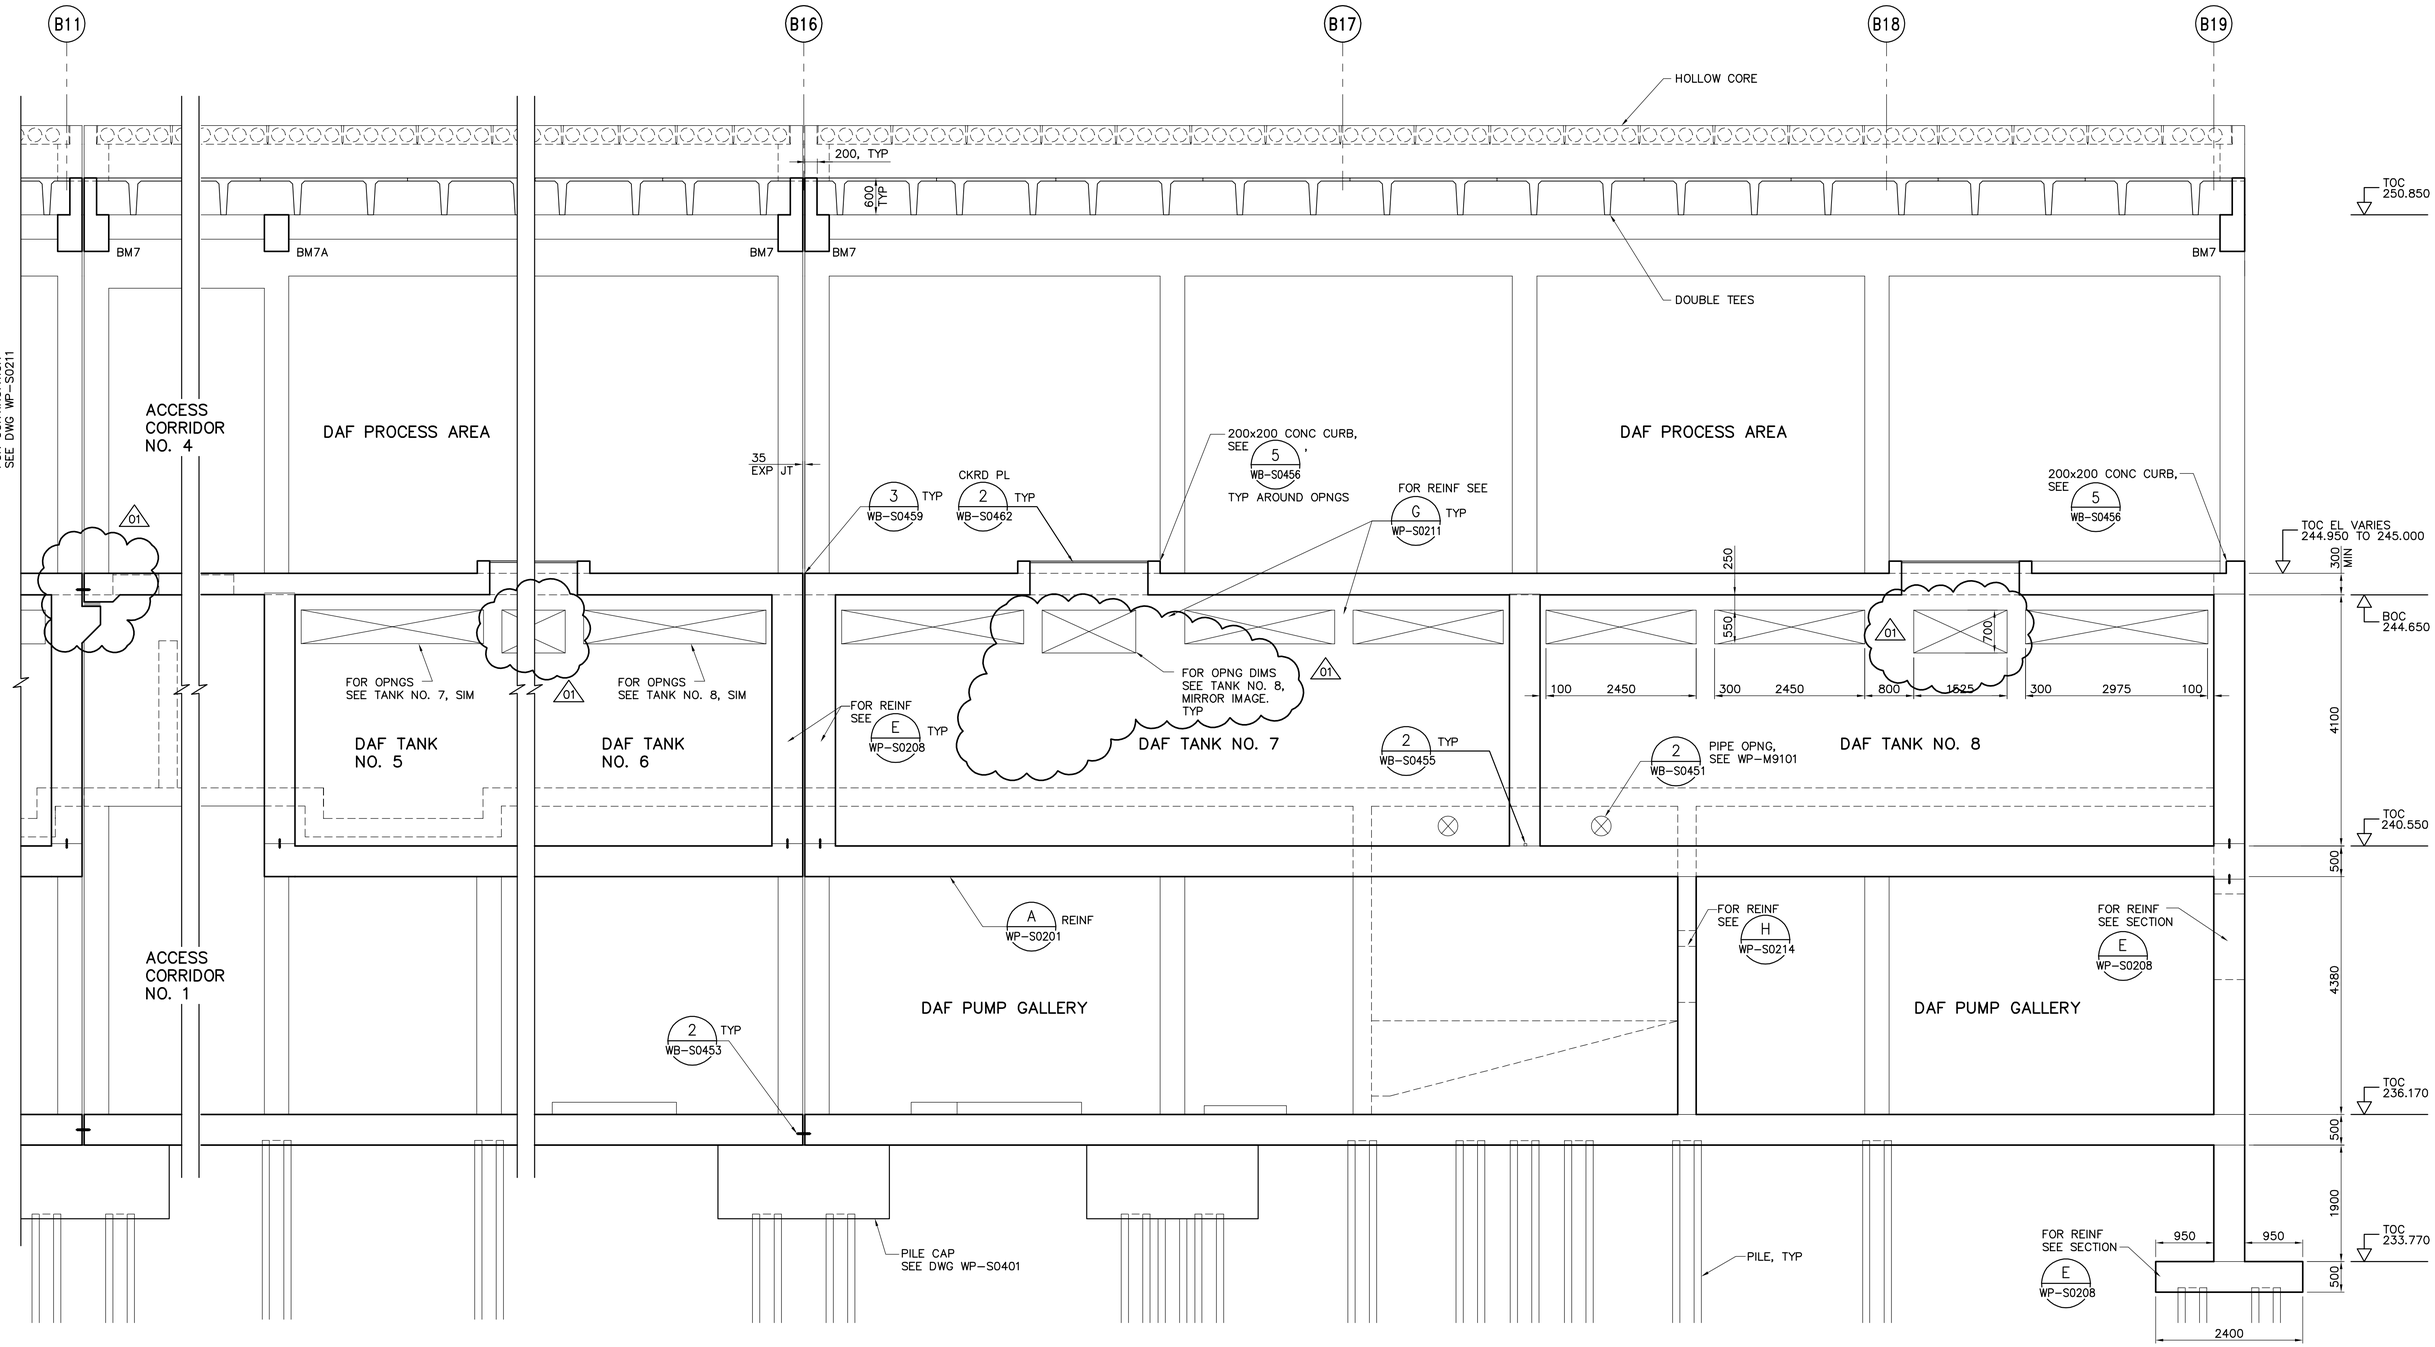

G WP-F0106 SECTION 1:50

WP-S0122, WP-S0132
WP-S0142, WP-S0147

NOTES:

1. SEE DWGS WP-S0111 TO WP-S0132 FOR SLAB REINFORCING AND WALL ADDITIONAL REBARS, UNO.
2. SEE DWG WP-S0515 FOR BEAM AND COLUMN SCHEDULES.

SCALE 1:50 METRES 0 1 2 3 4 5

SCALE 1:1 MILLIMETRES 0 20 40 60 80 100

APEGM
Certificate of Authorization
CH2M HILL Canada Ltd.
No. 1441 Expiry: April 30, 2006

B.M.
ELEV.

NO.	REVISIONS	DATE	BY
01	583-2005 ADDENDUM 3	06/03/10	RZ
00	ISSUED FOR TENDER	2006/02/03	RZ

CH2MHILL
Fredericksen Cooper ARCHITECTS
EarthTech A Tyco International Ltd. Company

DESIGNED BY	RZ	CHECKED BY	AP
DRAWN BY	CA	APPROVED BY	DJT
SCALE:	1:50	RELEASED FOR CONSTRUCTION BY:	R. SOROKOWSKI
DATE	2005/11/01	DATE	2006/02/08

ENGINEER'S SEAL
ORIGINAL SIGNED BY
D. KRUGER
2006/02/06

CONSULTANT DRAWING NO.
WP-S0212

Winnipeg
THE CITY OF WINNIPEG
WATER AND WASTE DEPARTMENT
ENGINEERING DIVISION

WATER TREATMENT PLANT
FLOCCULATION AND DAF
FOUNDATIONS AND CONCRETE STRUCTURES

STRUCTURAL
FLOC/DAF AREA 2
SECTION

CITY FILE NUMBER
SHEET OF
CITY DRAWING NUMBER
1-0601P-A-S0212-001-01D

Last Save: 2006-03-13 11:51 AM

P:\EARTHTECH\321352WINNIPEGWTP\NDM\DESIGN\ACAD\583-POSTTENDER\DN_WP-S0212_CH2M.DWG