
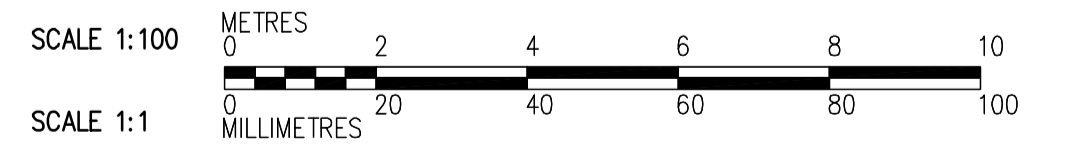


- NOTES:**
- DESIGN LIVE LOAD IS 14.4kPa.
 - FOR BEAM AND COLUMN SCHEDULE SEE DWG WR-S0515.
 - MONORAILS TO BE PROVIDED AND INSTALLED IN SEPARATE CONTRACT. EMBEDDED ANCHOR RODS AND PLATES TO BE PROVIDED AND INSTALLED IN THIS CONTRACT.
 - APPROXIMATE LOCATIONS FOR EQUIPMENT SUPPORT PADS ARE SHOWN. TOTAL CONCRETE FOR TENDER: 20m³

REBAR LEGEND:

—— TOP BARS
 - - - - BOTTOM BARS

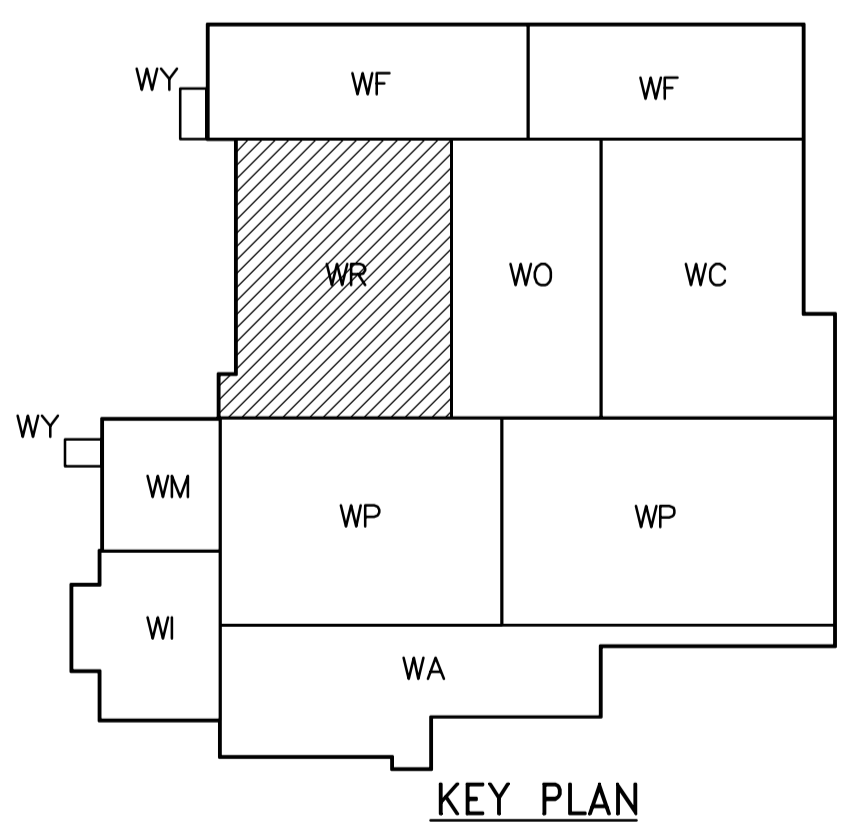

THIRD FLOOR PLAN
1:100

APECA
 Certificate of Authorization
 CH2M HILL Canada Ltd.
 No. 1441 Expiry: April 30, 2006

NO.	REVISIONS	DATE	BY
01	583-2005 ADDENDUM 3	06/03/10	EL
00	ISSUED FOR TENDER	2006/02/03	EL

DESIGNED BY	MFC/EL	CHECKED BY	AP
DRAWN BY	RRL	APPROVED BY	DJT
SCALE:	1:100	RELEASED FOR CONSTRUCTION BY:	R. SOROKOWSKI
DATE	2005/06/28	DATE	2006/02/08

ENGINEER'S SEAL
 ORIGINAL SIGNED BY
 D. KRUGER
 2006/02/06
 CONSULTANT DRAWING NO.
 WR-S0131

THE CITY OF WINNIPEG
 WATER AND WASTE DEPARTMENT
 ENGINEERING DIVISION

WATER TREATMENT PLANT
 RESIDUALS HANDLING
 FOUNDATIONS AND CONCRETE STRUCTURES

STRUCTURAL
 RESIDUALS HANDLING AREA
 THIRD FLOOR PLAN

CITY FILE NUMBER
 SHEET OF
 CITY DRAWING NUMBER
1-060R-A-5031-001-0D