

B SECTION
WR-S0101 1:50


ADD 30M@200 BOT BENT BARS (NET SPACING 100mm)
PLACE SECONDARY CONCRETE AFTER COMPLETION OF WALLS AND SLABS TO EL 239.410

ADD 30M@200 EW, T&B HOOK AT DISCONTINUOUS ENDS, TYP UNO

ADD 30M@200 x 9200 BOT (NET SPACING 100mm)

10M DOWELS ON 800 x 800 GRID 800 LG PROJECT 400

ROUGHEN WALL AND LEAVE SLAB SURFACE ROUGH TYPICAL IN GRAVITY THICKENERS

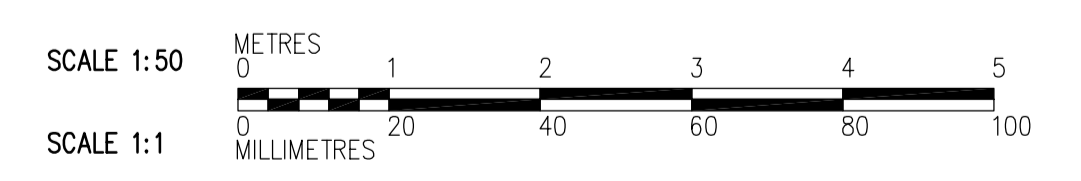

WR-S0111, WR-S0121
WR-S0131, WR-S0141
WR-S0146



NO.	REVISIONS	DATE	BY
01	583-2005 ADDENDUM 3	06/03/10	EL
00	ISSUED FOR TENDER	2006/02/03	EL

DESIGNED BY	EL	CHECKED BY	AP
DRAWN BY	RL/CA	APPROVED BY	DJT
SCALE:	1:50	RELEASED FOR CONSTRUCTION BY:	R. SOROKOWSKI
DATE	2005/07/27	DATE	2006/02/08

ENGINEER'S SEAL
ORIGINAL SIGNED BY
D. KRUGER
2006/02/06
CONSULTANT DRAWING NO.
WR-S0202

THE CITY OF WINNIPEG
WATER AND WASTE DEPARTMENT
ENGINEERING DIVISION

WATER TREATMENT PLANT
RESIDUALS HANDLING
FOUNDATIONS AND CONCRETE STRUCTURES

STRUCTURAL
RESIDUALS HANDLING AREA
SECTION

CITY FILE NUMBER
SHEET OF
CITY DRAWING NUMBER
1-060R-A-50202-01-0D