


NOTES:
 1. SEE DWG WR-S0101 FOR ADDITIONAL WALL REINFORCING.
 2. SEE DWG WR-S0111 AND WR-S0121 FOR ADDITIONAL SLAB REINFORCING.

E SECTION
 WR-S0101 1:50

WR-S0111, WR-S0121
 WR-S0131, WR-S0141

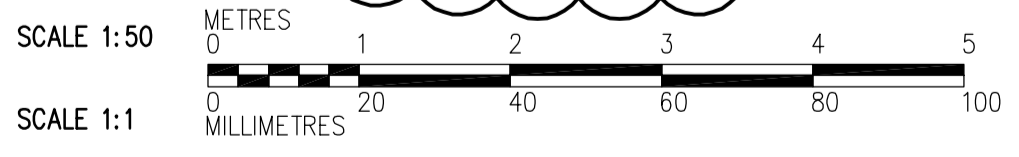

 Certificate of Authorization CH2M HILL Canada Ltd. No. 1441 Expiry: April 30, 2006	B.M. ELEV.	 Frederickson Cooper ARCHITECTS	 A Terra International Ltd. Company	ENGINEER'S SEAL	 THE CITY OF WINNIPEG WATER AND WASTE DEPARTMENT ENGINEERING DIVISION WATER TREATMENT PLANT RESIDUALS HANDLING FOUNDATIONS AND CONCRETE STRUCTURES STRUCTURAL RESIDUALS HANDLING AREA SECTION	CITY FILE NUMBER
	DESIGNED BY EL			CHECKED BY AP		ORIGINAL SIGNED BY D. KRUGER
	DRAWN BY RL/CA	APPROVED BY DJT	2006/02/06	CITY DRAWING NUMBER		
	SCALE: 1:50	RELEASED FOR CONSTRUCTION BY: R. SOROKOWSKI	CONSULTANT DRAWING NO. WR-S0205	1-060R-A-50205-001-0D		
01 583-2005 ADDENDUM 3 06/03/10 EL	DATE BY DATE 2005/09/29	DATE 2006/02/08				
00 ISSUED FOR TENDER 2006/02/03 EL						
NO. REVISIONS	DATE BY	DATE				