


NOTE:
1. SEE PLANS FOR SLAB REINFORCEMENT.

NOT IN CONTRACT

C SECTION
WI-S0101 1:50

WI-F0105, WI-S0111,
WI-S0131, WI-S0141

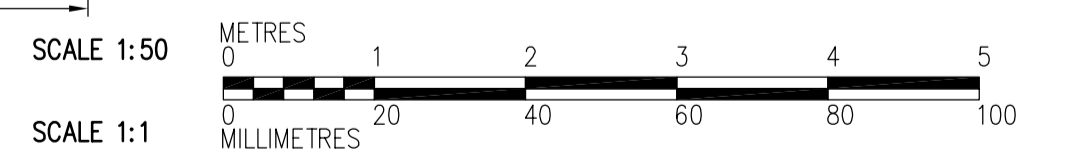

APEGM
Certificate of Authorization
CH2M Hill Canada Limited (ON)
No. 1441 Expiry: April 30, 2006

B.M.	ELEV.	DATE	BY
01	650-2005 ADDENDUM 2	05/11/16	EL
00	ISSUED FOR TENDER	05/10/28	EL
NO.	REVISIONS	DATE	BY

CH2MHILL
Frederickson Cooper
ARCHITECTS

EarthTech
A Tyco International Ltd. Company

DESIGNED BY: EL
CHECKED BY: AP
DRAWN BY: RL
APPROVED BY:
SCALE: 1:50
RELEASED FOR CONSTRUCTION BY:
DATE: 2005/08/02
DATE:

ENGINEER'S SEAL

THE CITY OF WINNIPEG
WATER AND WASTE DEPARTMENT
ENGINEERING DIVISION

WATER TREATMENT PLANT
FOUNDATIONS AND CONCRETE STRUCTURES 1

STRUCTURAL
RAW WATER PUMP STATION AREA
SECTION

CITY FILE NUMBER
SHEET OF
CITY DRAWING NUMBER
1-0601-A-80203-001-0D

CONSULTANT DRAWING NO.
WI-S0203