


FILE NAME: 2004-180-06-01.dwg/A3R1

DATE: 2005.11.15

DESCRIPTION: SECOND FLOOR PLAN - REFLECTED CEILING

PROJECT No: 2004-180-06

ADDRESS: 510 MAIN ST.

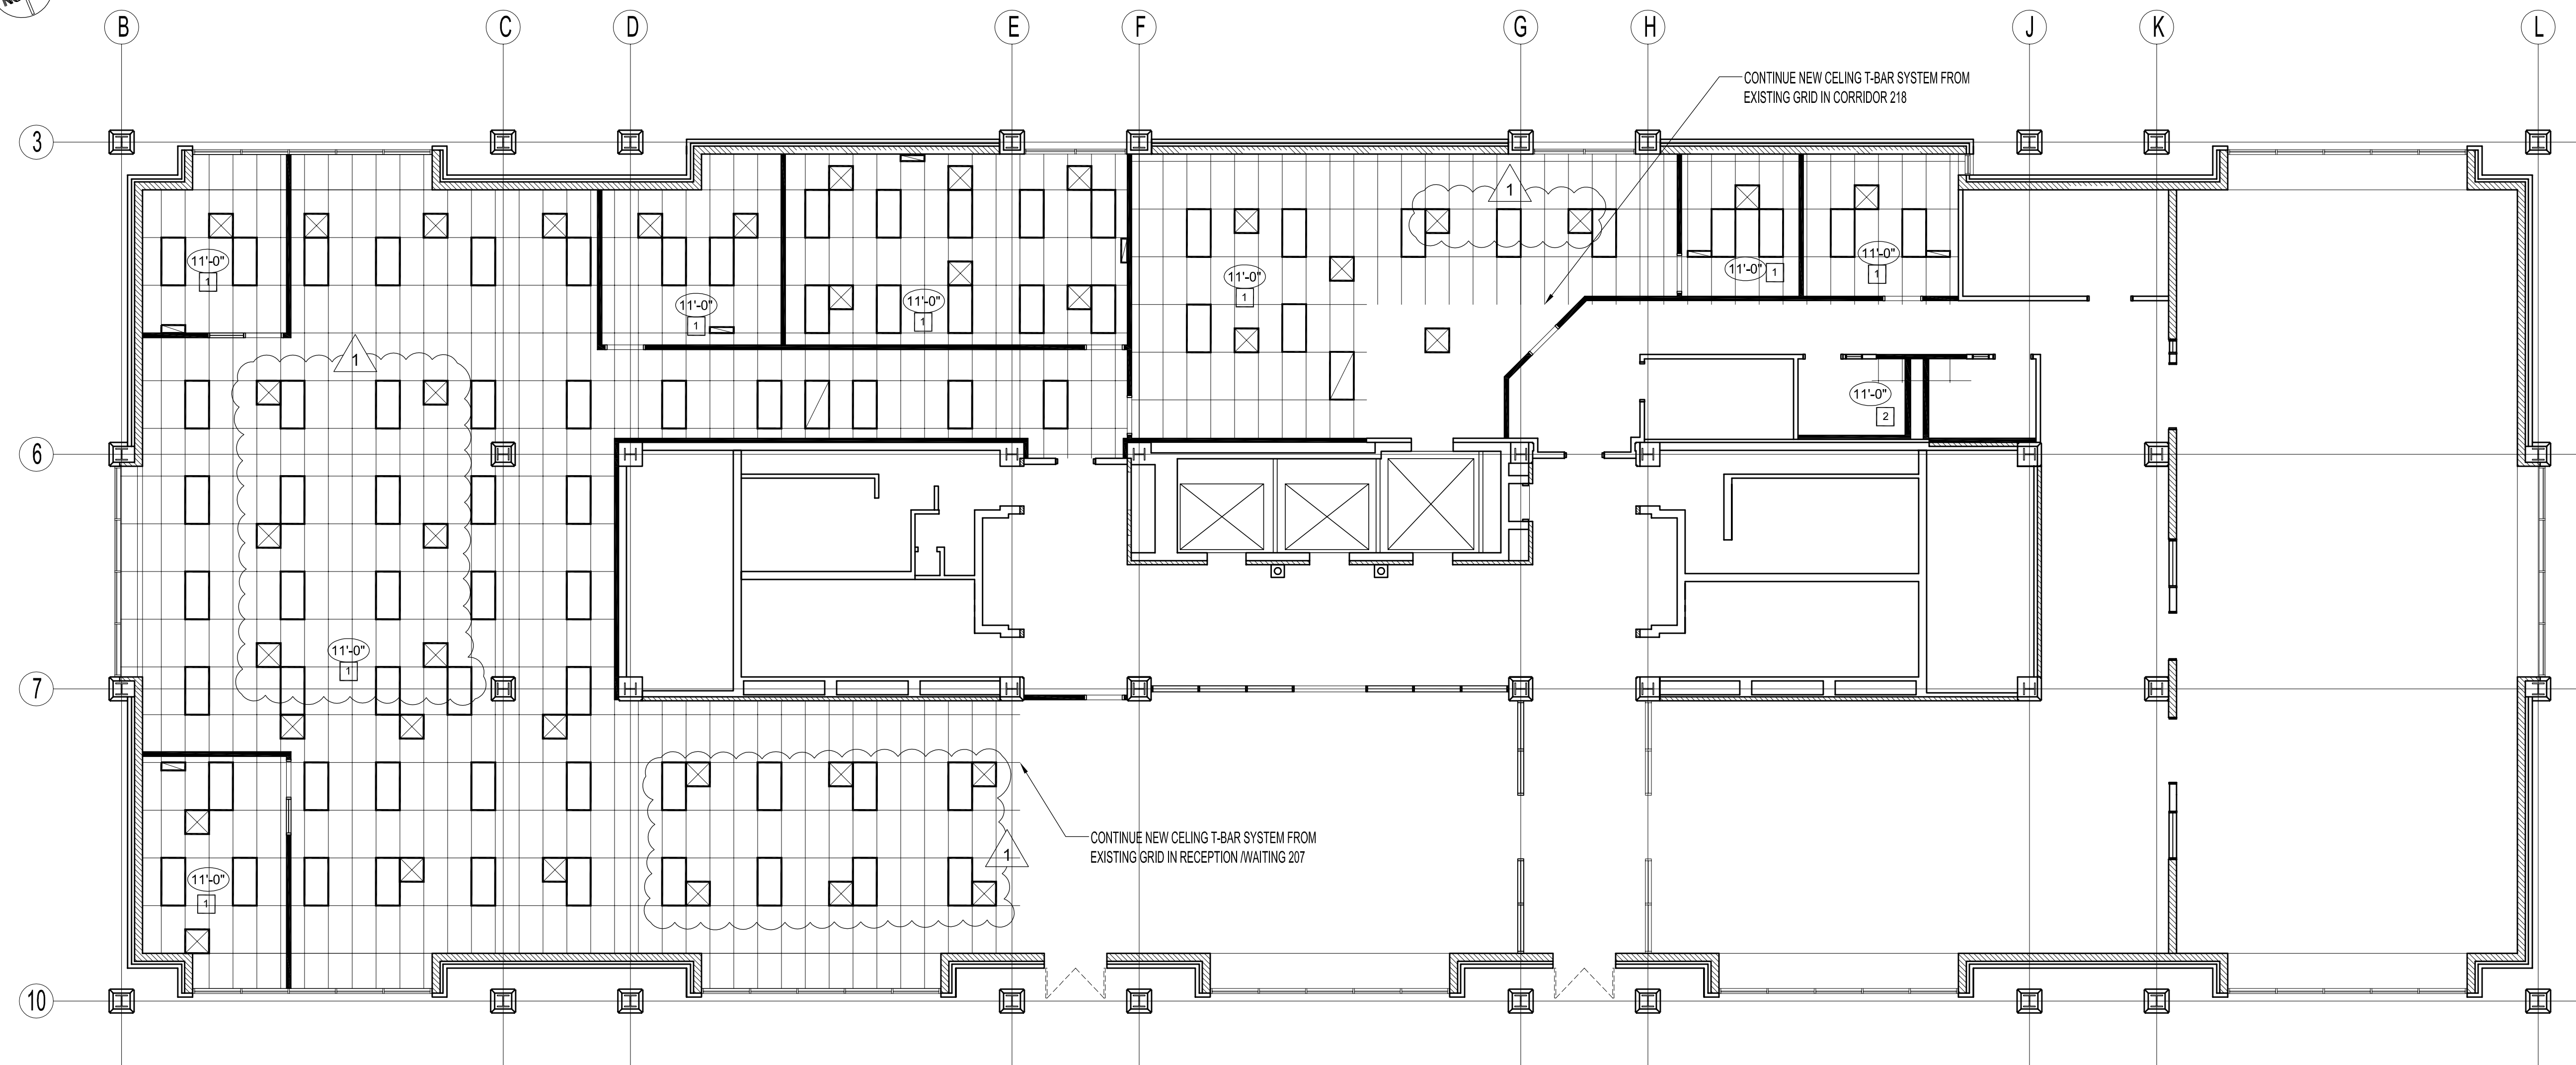

SECOND FLOOR PLAN - REFLECTED CEILING

SCALE: 1/8"=1'-0"

NEW CEILING TYPE LEGEND

- NEW CEILING HEIGHT (VARIES)
- NEW 24" x 48" CGC STANDARD ACOUSTIC CEILING TILE PANELS IN COLOUR WHITE C/W T-BAR SYSTEM IN WHITE
- ADJUST EXISTING CEILING GRID TO SUIT NEW WALLS & MATCH 24" x 24" CGC 'SANDRIFT' ACOUSTIC CEILING TILE PANELS IN COLOUR WHITE & C/W T-BAR SYSTEM IN WHITE TO EXISTING CEILING LAYOUT
- NEW 24" x 48" FLUORESCENT LIGHT FIXTURES
- NEW AIR SUPPLY & RETURN GRILLES

NOTES :

GENERAL REFLECTED CEILING NOTES:

- FRAMING MAY BE REQUIRED AT WALLS ETC. AT NEW CEILING HEIGHTS FOR ALL T-BAR SYSTEMS.
- AREAS OF FLOOR NOT SHOWING REFLECTED CEILING ARE PREVIOUSLY COMPLETED.
- RELOCATE ANY EXISTING LIGHTING AS REQUIRED DUE TO NEW WALL LOCATIONS.

ORIGINAL SEALED BY:
R.K. FOK LI Arch.
Date: 2005.11.15

RELOCATED AIR SUPPLY GRILLES AS SHOWN ON PLAN.

MMK 2005.11.28

| NO. | REVISION/DESCRIPTION | BY | DATE |
|-----|----------------------|----|------|
| | | | |

| DRAWN BY | CHECKED BY | APPROVED |
|-----------------|---------------|----------|
| MMK | MMK | |
| DATE 2005.11.15 | USER APPROVAL | |

CITY OF WINNIPEG
PLANNING, PROPERTY &
DEVELOPMENT DEPARTMENT
CIVIC ACCOMMODATIONS DIVISION
300 - 65 GARRY ST. R3C 4K4

PROJECT
ADMINISTRATION BUILDING
SECOND FLOOR RENOVATIONS
CONVERSION TO OFFICE AREA
510 MAIN STREET

SHEET TITLE

SECOND FLOOR PLAN
REFLECTED CEILING

| SCALE | PROJECT NO. | SHEET NO. |
|----------|-------------|-----------|
| AS NOTED | 2004-180 | A3R1 |

DRAWING SHEET SIZE: A1 (841mm x 594mm) PLOT 1:1