




A PLAN
2.04 1:20

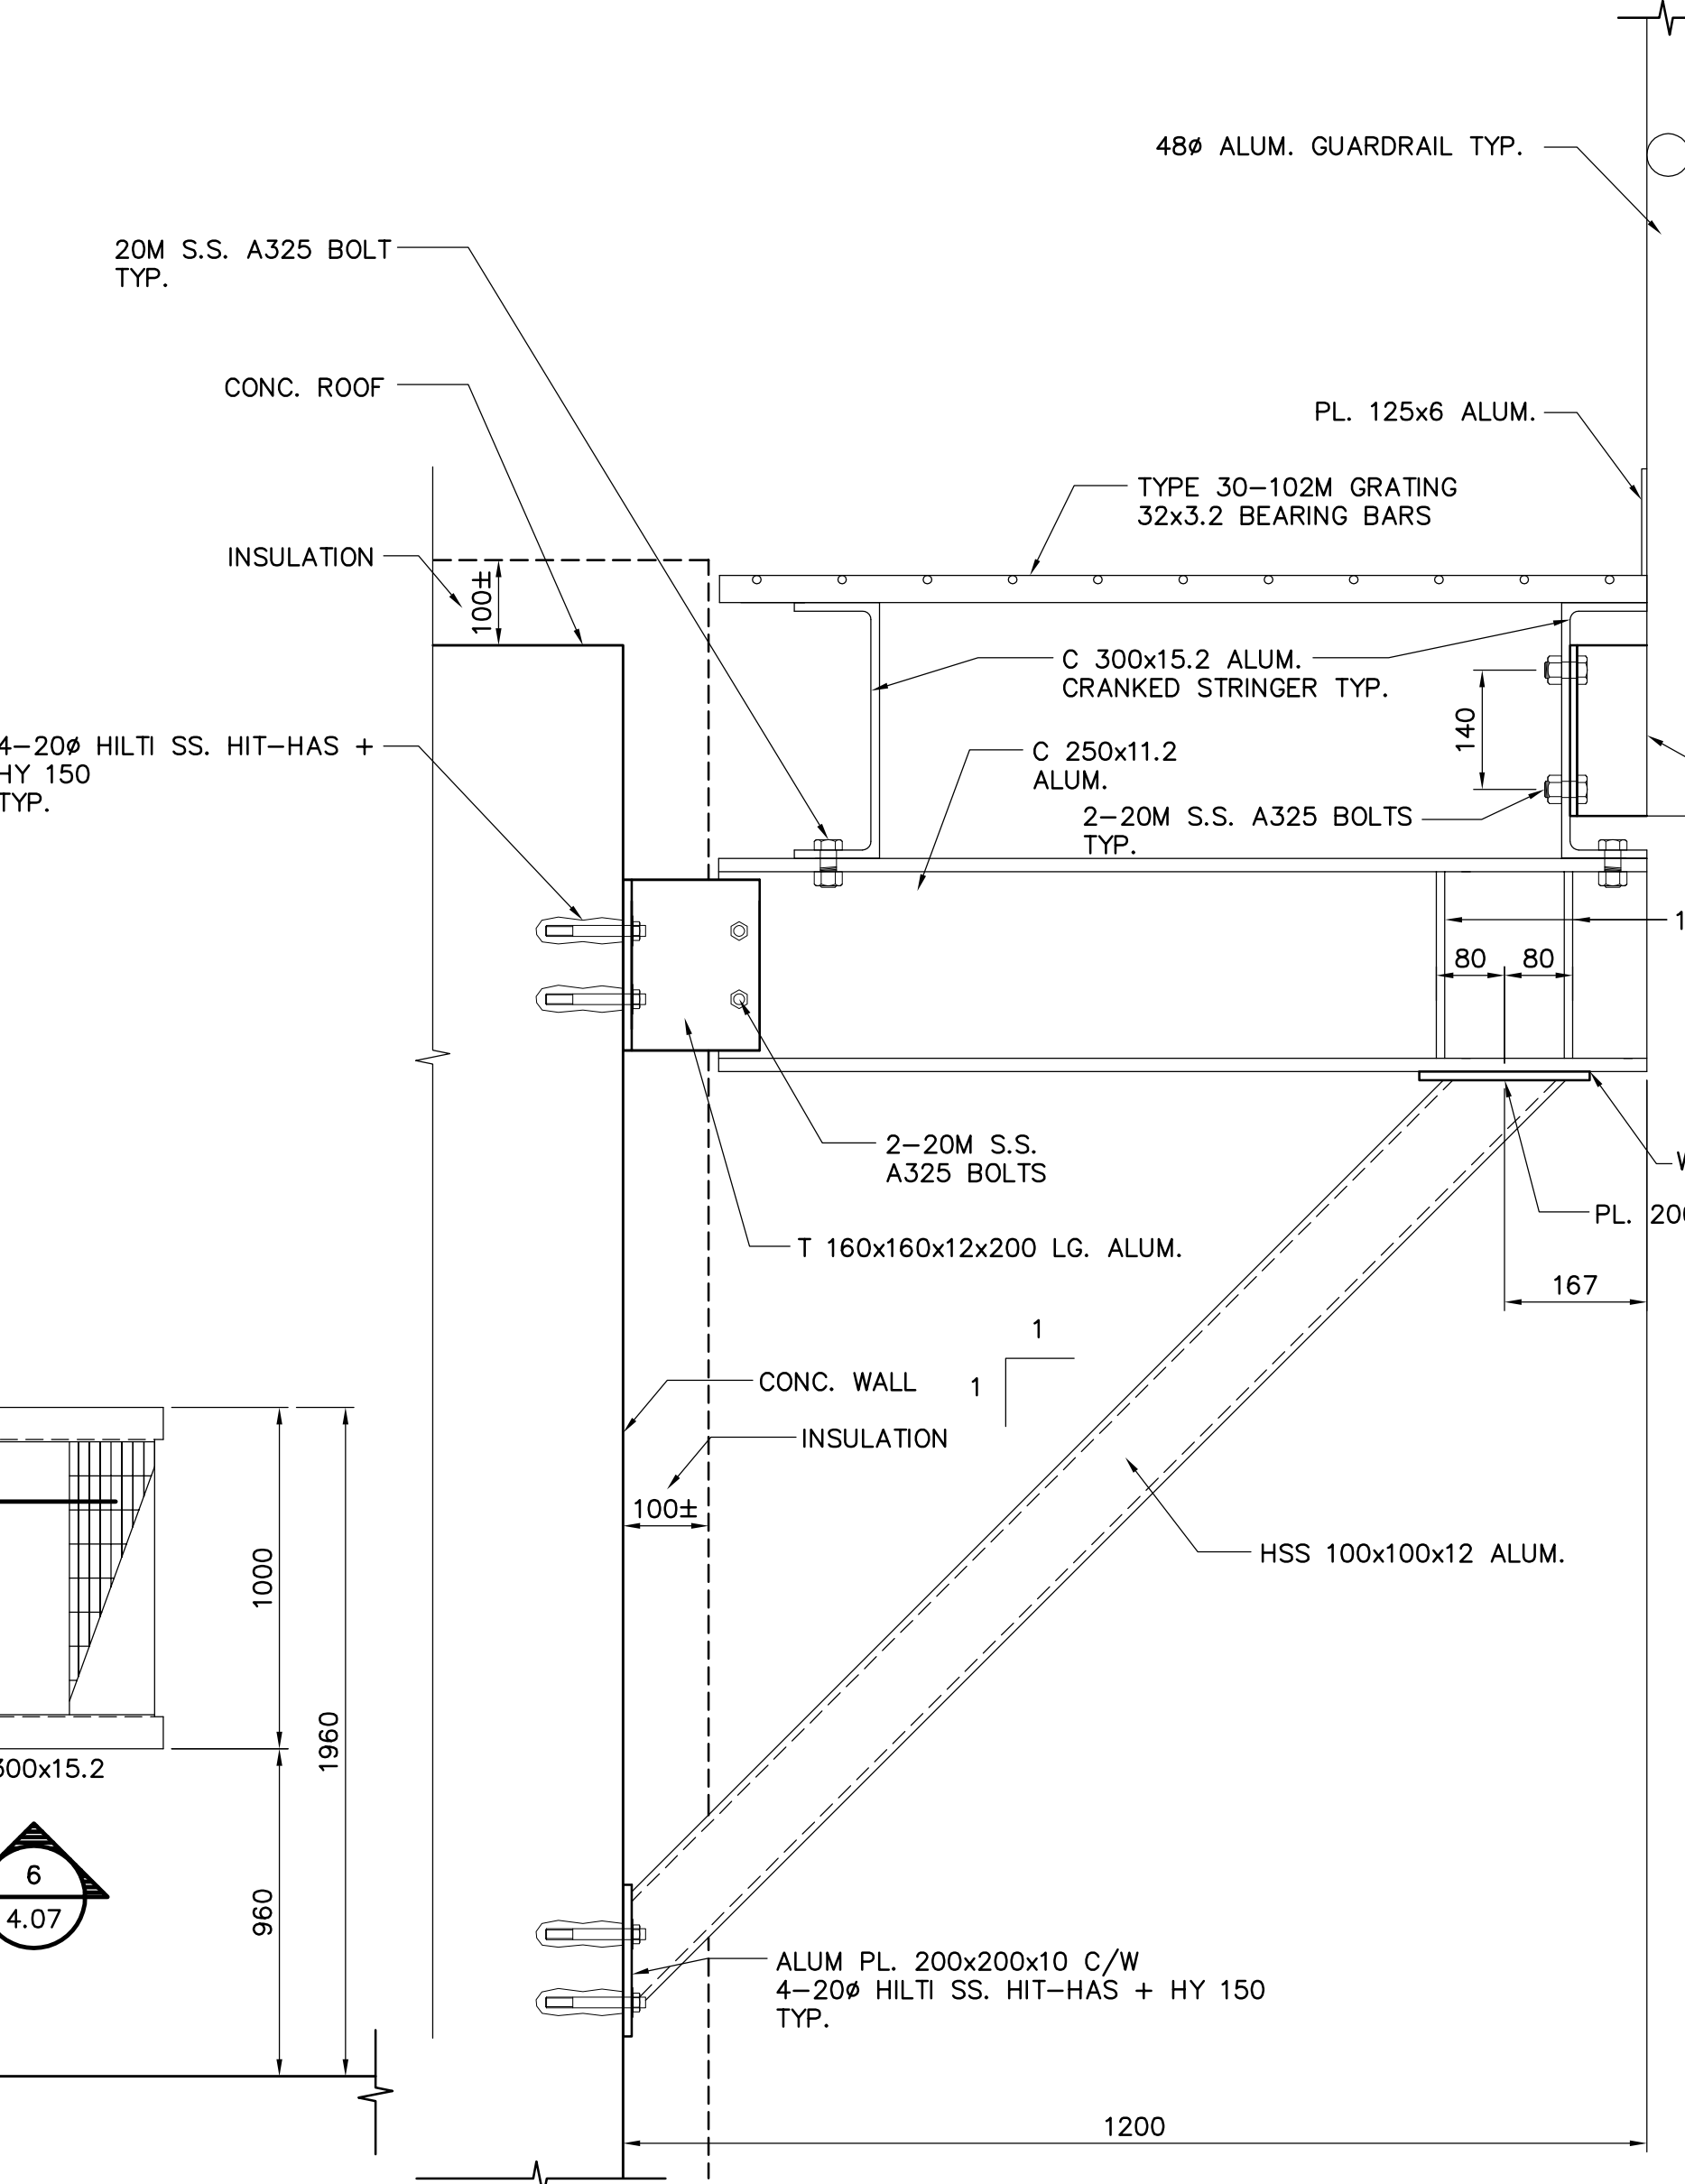


1 SECTION
4.07 1:10

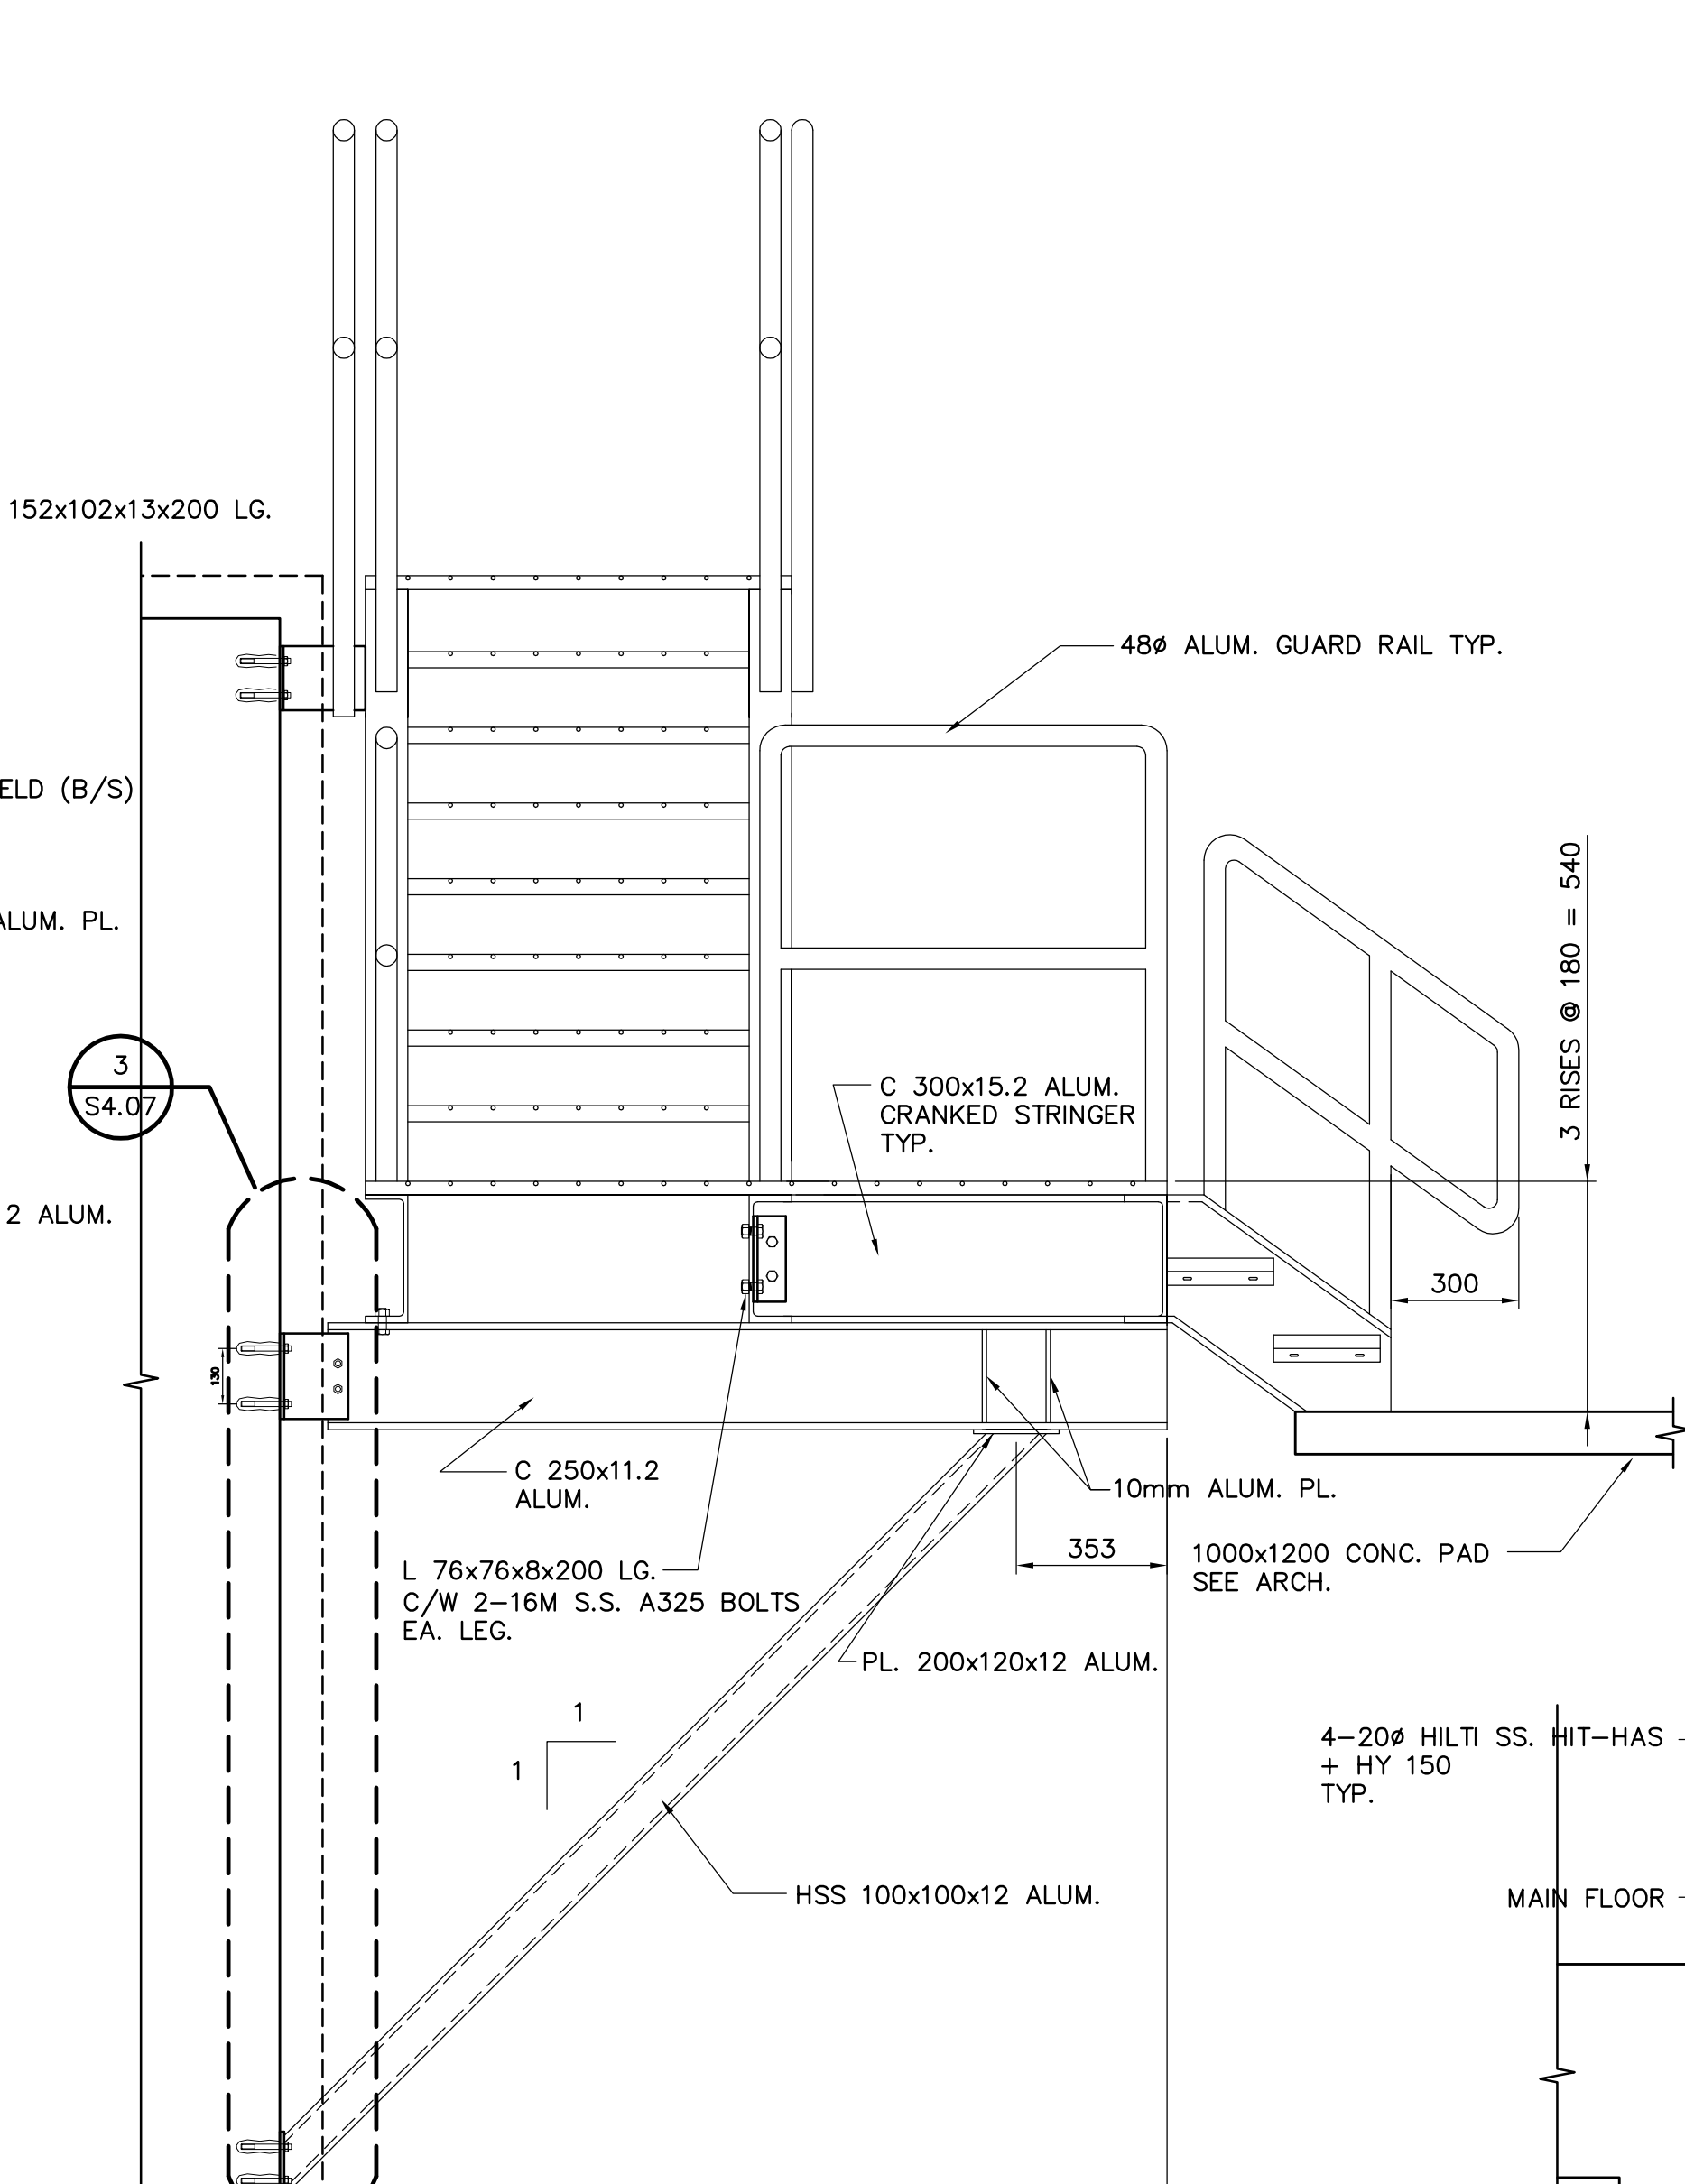


2 SECTION
4.07 1:16

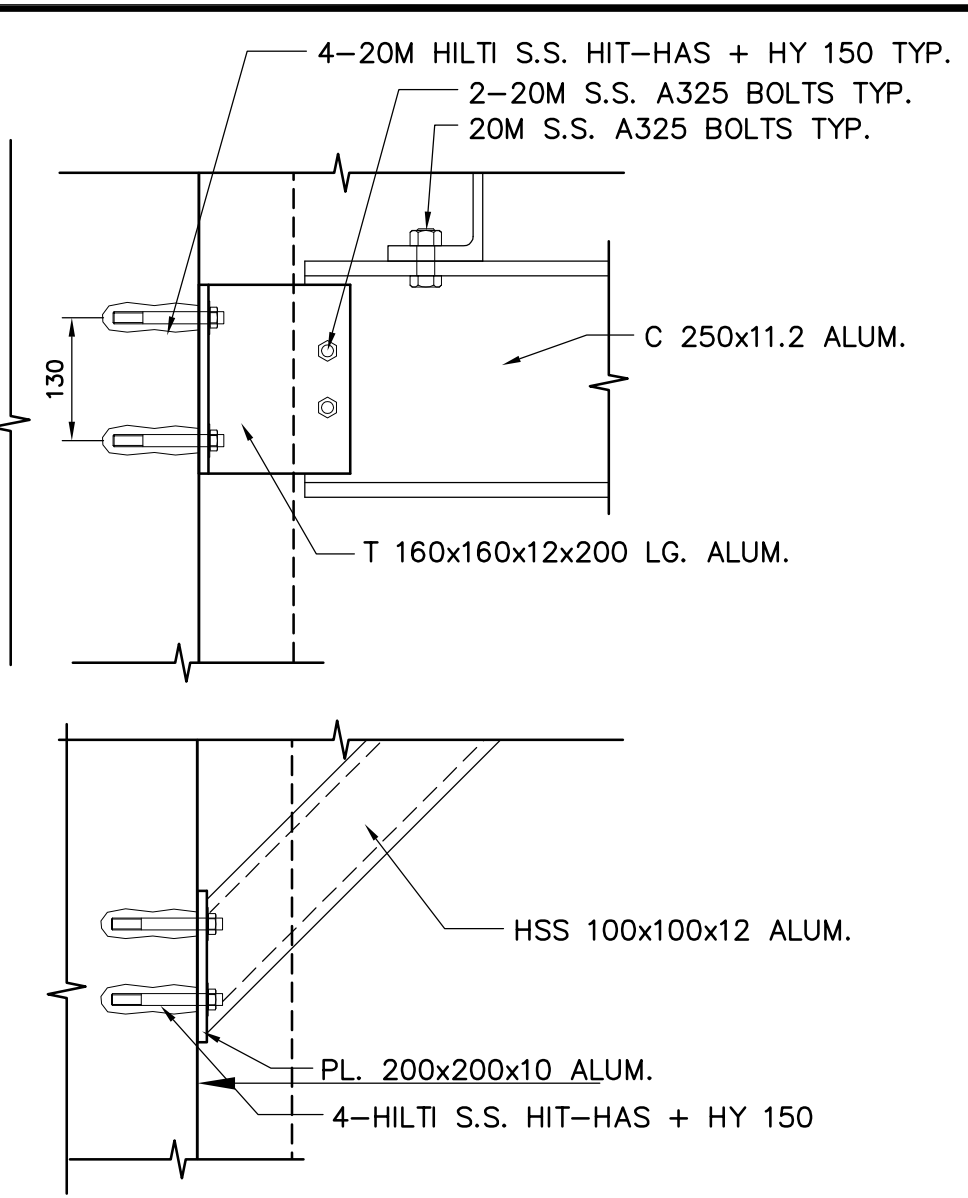


3 DETAIL
4.07 1:8

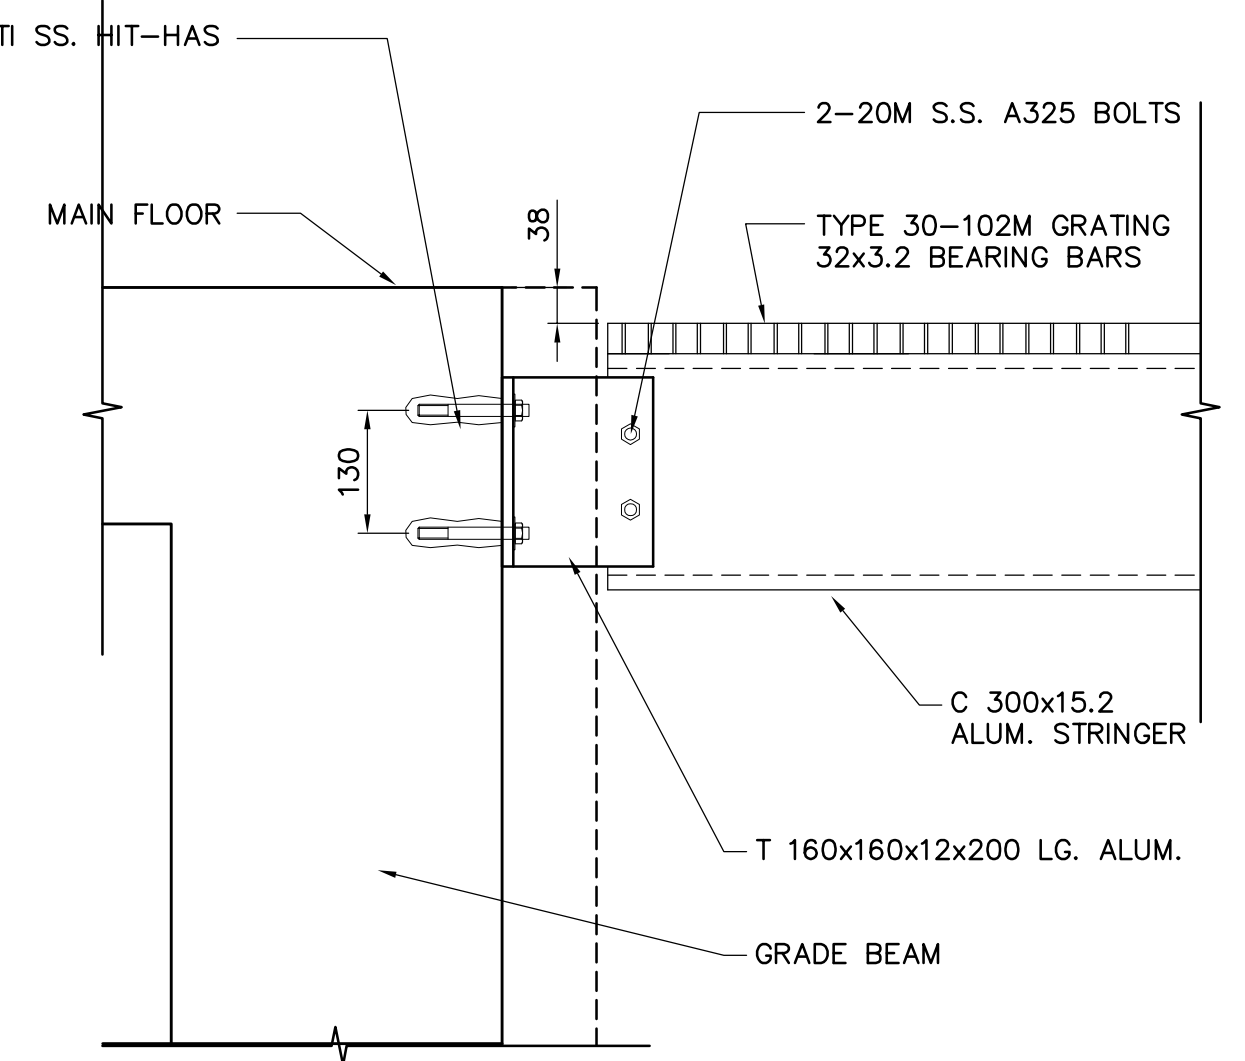

4 DETAIL
4.07 1:8

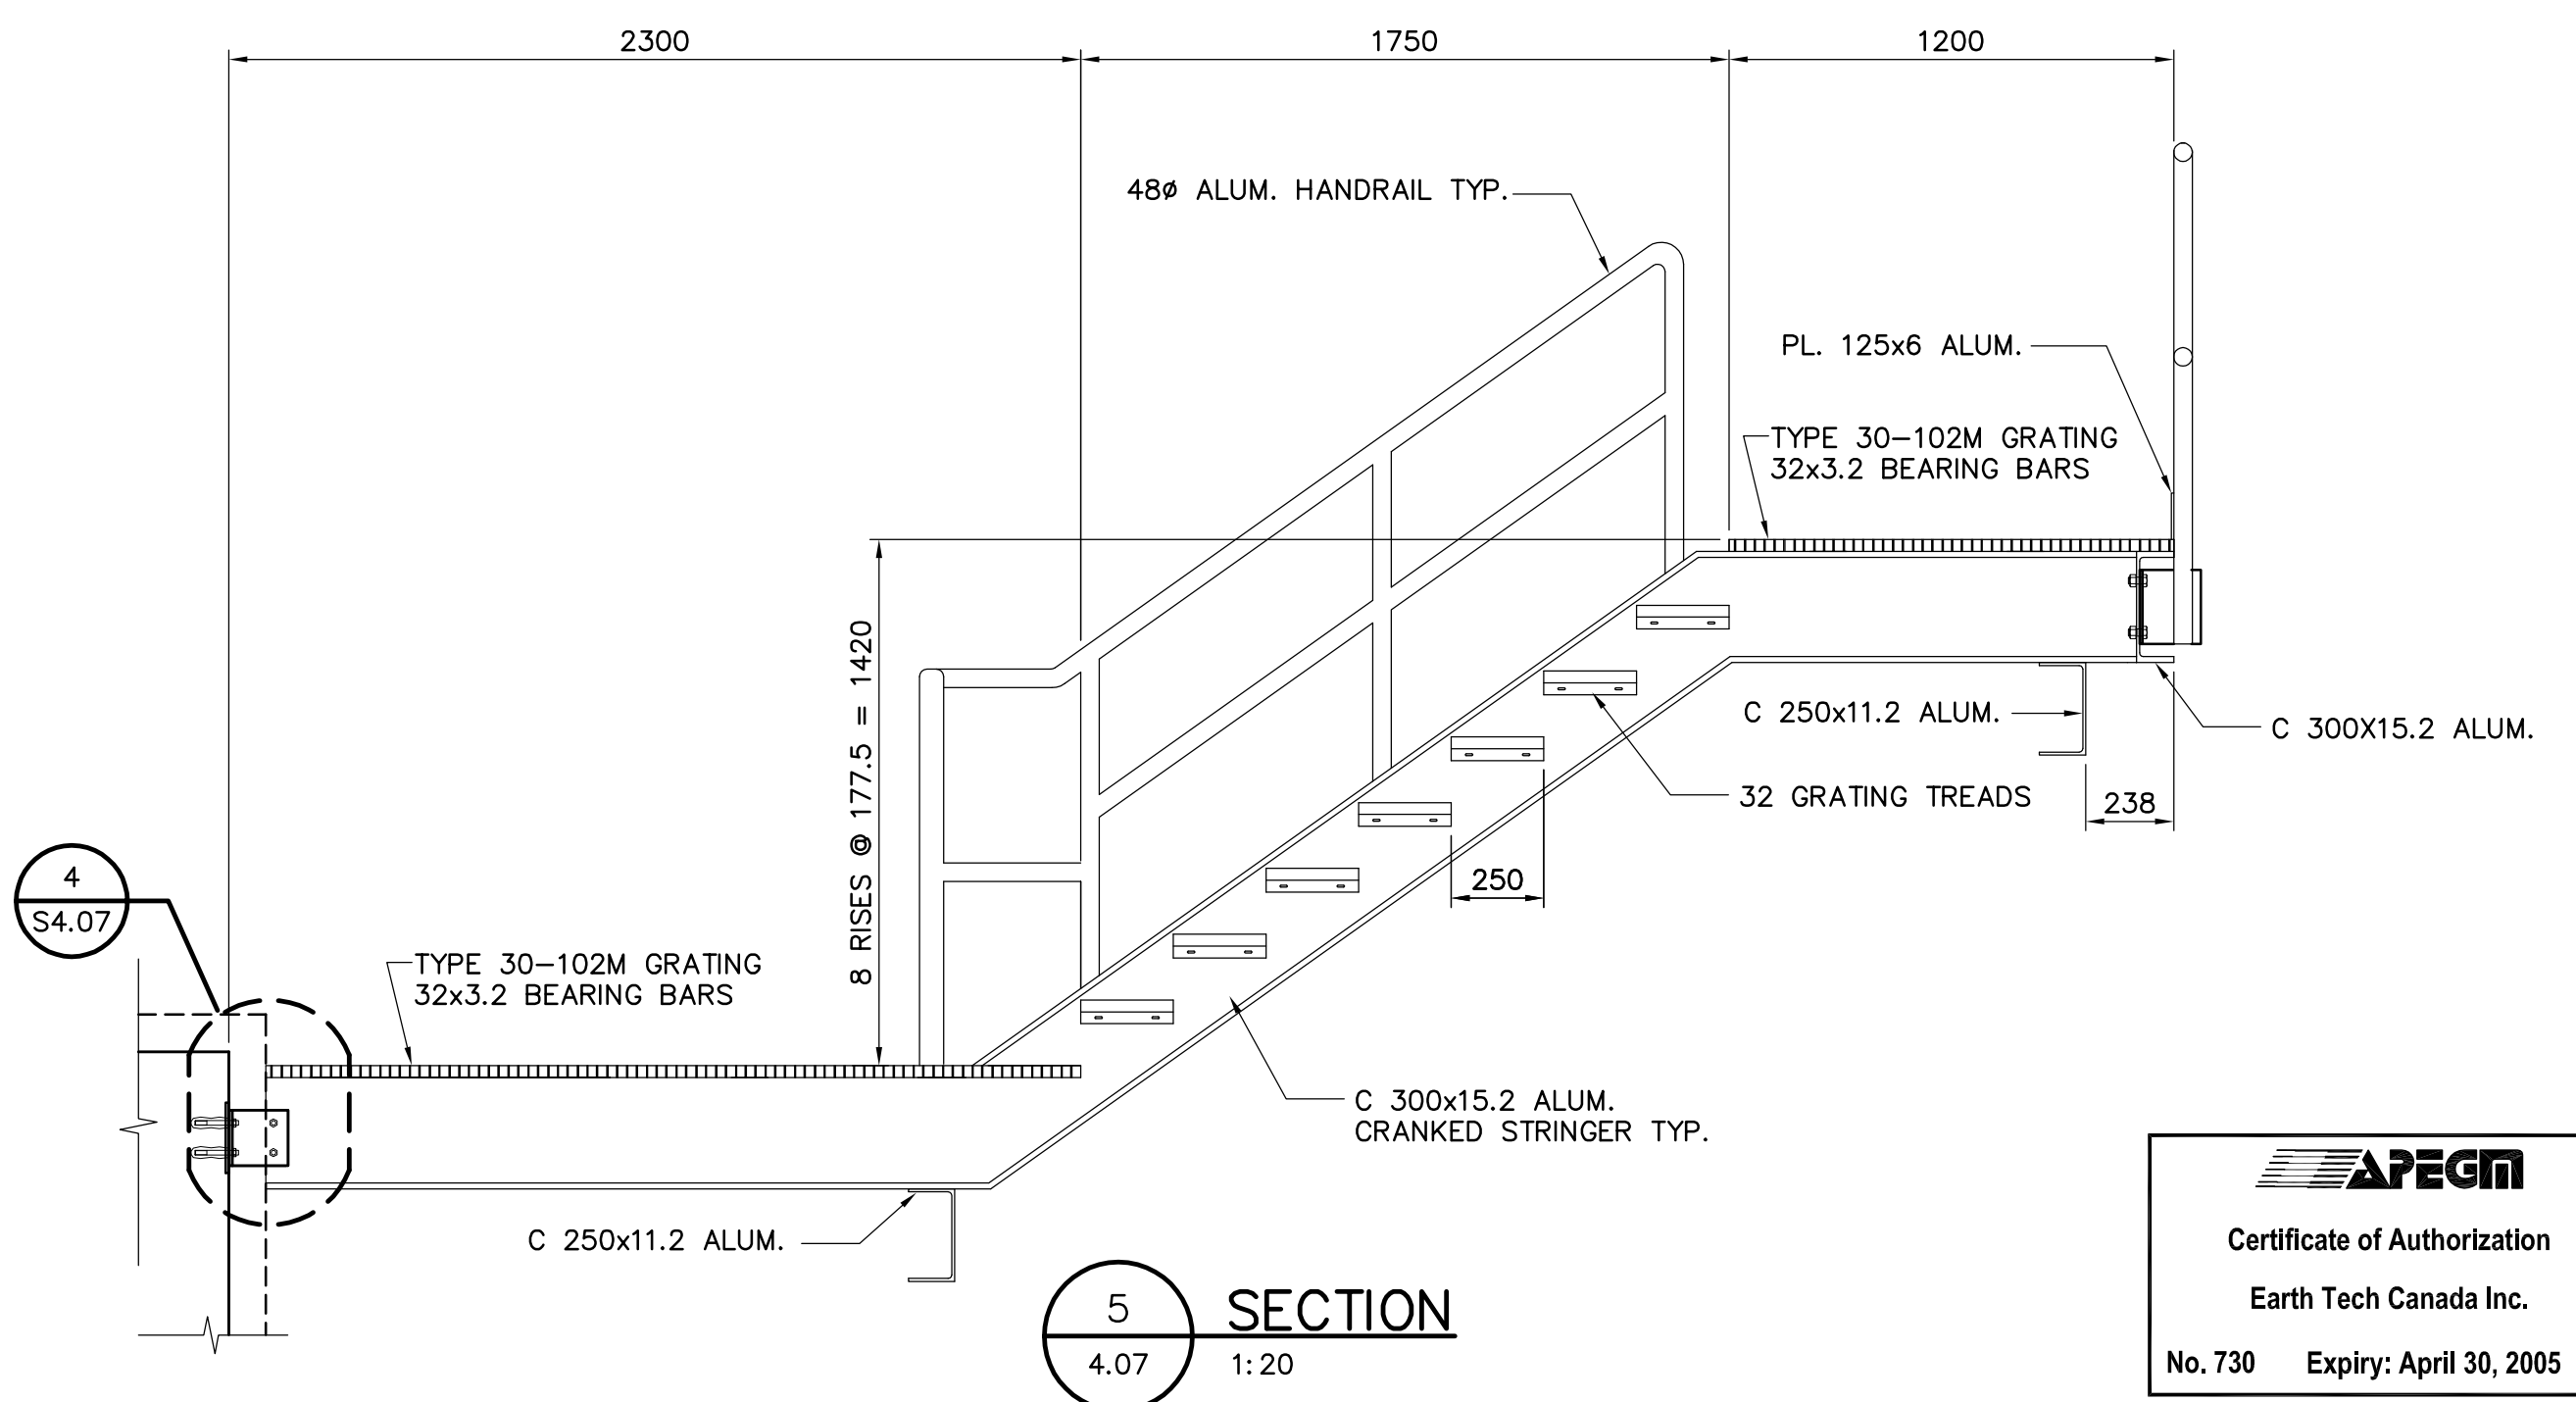

5 SECTION
4.07 1:20

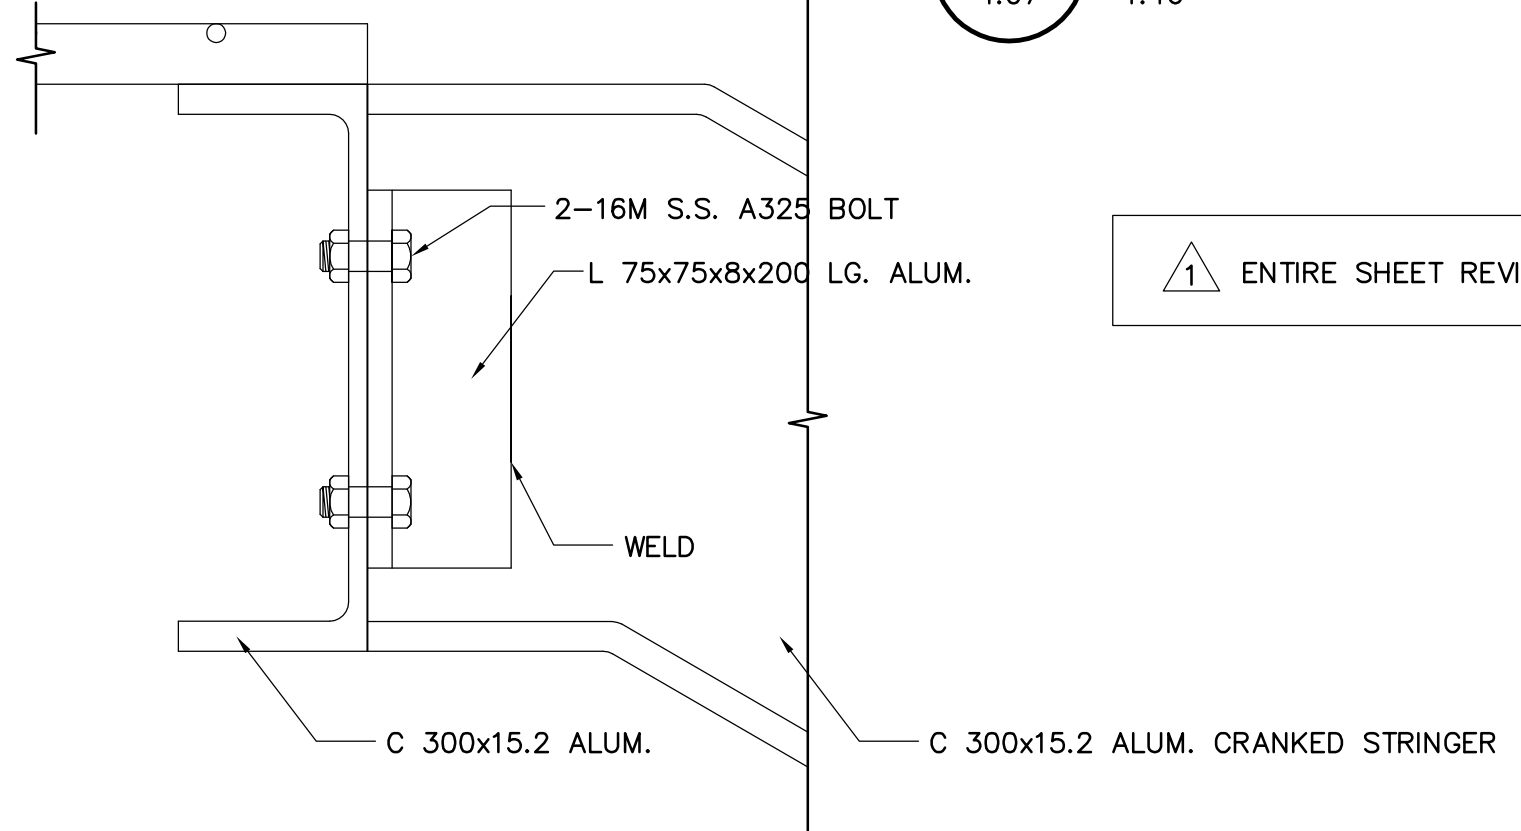

6 DETAIL
4.07 1:4

ENTIRE SHEET REVISED

NOTES:

1. FOR GENERAL NOTES AND SCHEDULES REFER TO DRAWING CS1.01.
2. FOR STANDARD DETAILS REFER TO DRAWINGS CS4.01, CS4.02, AND CS4.03.
3. ALL STRUCTURAL MEMBERS TO BE ALUMINIUM.
4. ALL BOLTS TO BE STAINLESS STEEL.
5. ALL GRATING TO BE ALUMINIUM.

APEGM
Certificate of Authorization
Earth Tech Canada Inc.
No. 730 Expiry: April 30, 2005

| | | | | | |
|---------------|--|--|--|--|------------------------------------|
| B.M. ELEV. | EARTH TECH | | ENGINEER'S SEAL | THE CITY OF WINNIPEG Winnipeg WATER AND WASTE DEPARTMENT | |
| | Earth Tech (Canada) Inc. Winnipeg, Manitoba 204.477.5381 | | ORIGINAL SIGNED BY R.B. ERIC | | |
| | DESIGNED BY RE, MK | CHECKED BY GGP | FEB. 18/05 | | |
| | DRAWN BY CMS | APPROVED BY DT | | | |
| 1 | ISSUED FOR ADDENDUM 1 | 05/03/04 | JEH | NEWPC - SECONDARY EFFLUENT UV DISINFECTION FACILITY | |
| 0 | ISSUED FOR TENDER | 05/02/18 | JEH | | CITY FILE NUMBER SHEET 15 OF 19 |
| | | HOR. SCALE: AS NOTED VERTICAL SCALE: AS NOTED | RELEASED FOR CONSTRUCTION BY: T. KJARTANSON | STRUCTURAL STAIRS SECTIONS AND DETAILS SHEET 4 OF 4 | CITY DRAWING NUMBER |
| NO. REVISIONS | | DATE | DATE 2005/01/07 | CONSULTANT DRAWING NO. 66303D-CS4.07 | |