



- NOTES:**
1. PROVIDE STAIRWELL SMOKE DETECTORS AS SHOWN ON FIRE PROTECTION DRAWINGS
 2. FOR CABLE TRAY TAGGING SEE DET. 3 WB-E0455

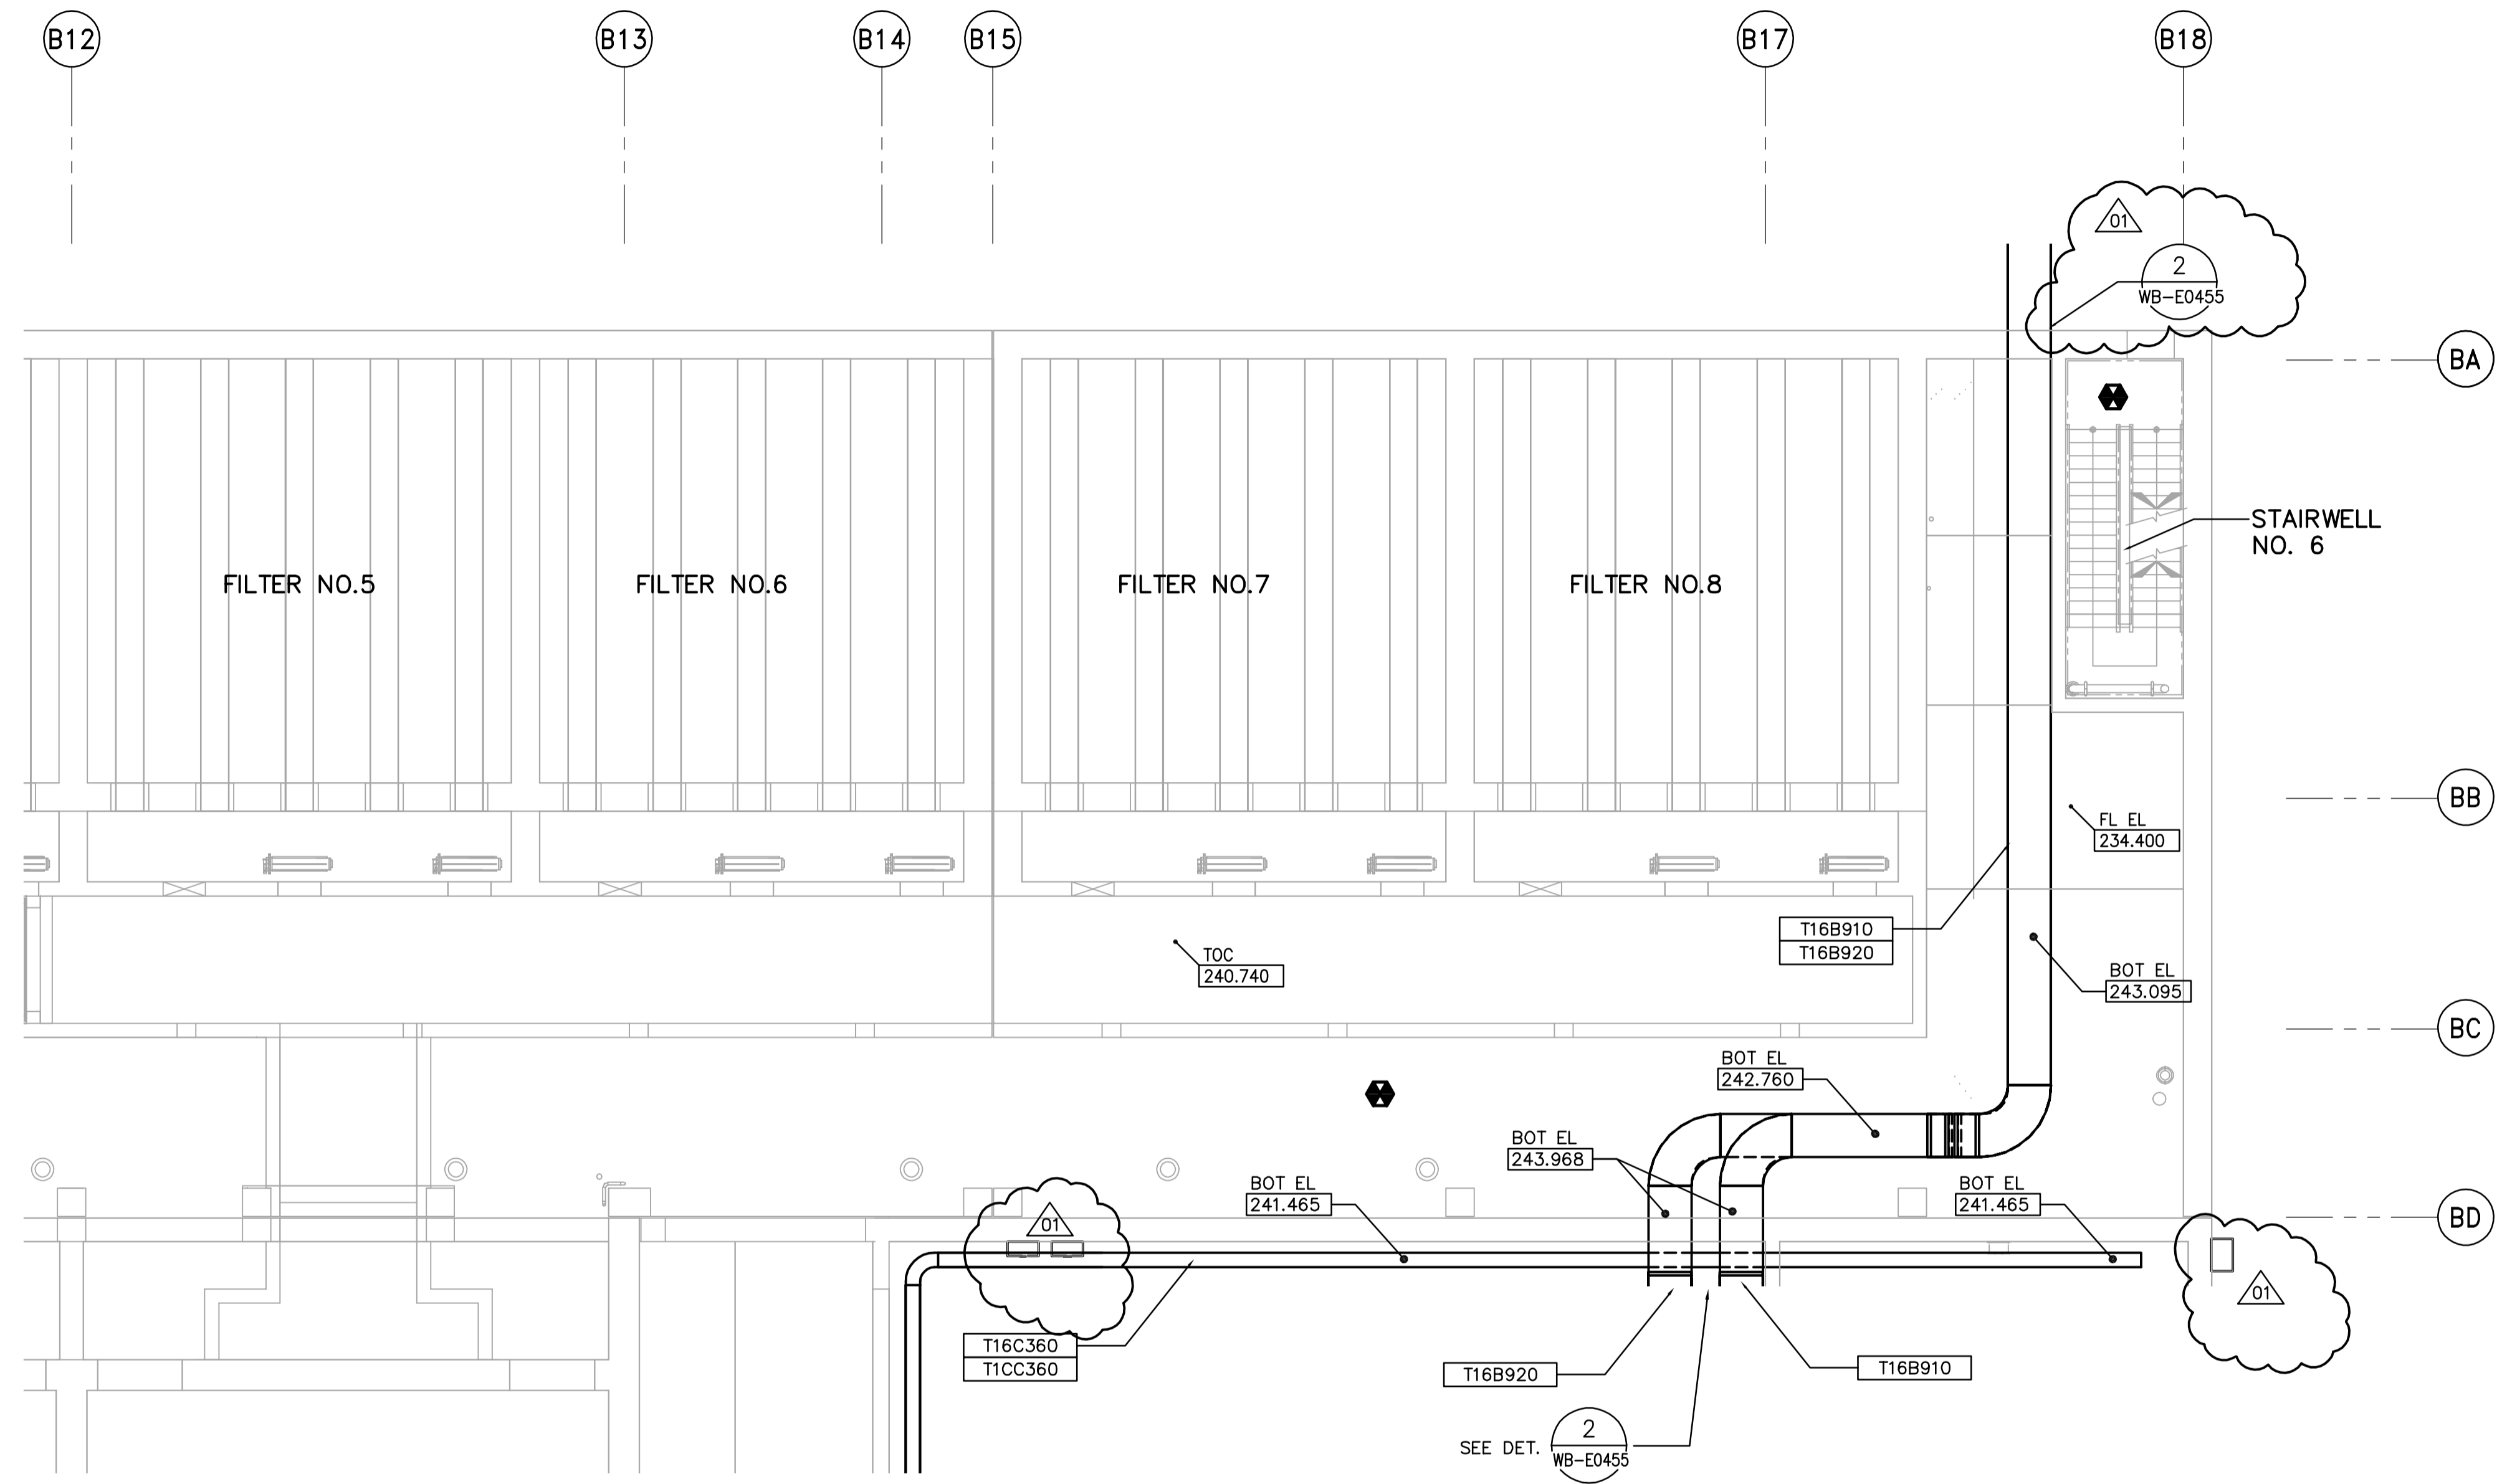

SECOND FLOOR FACILITY PLAN (AREA 2)
1:100

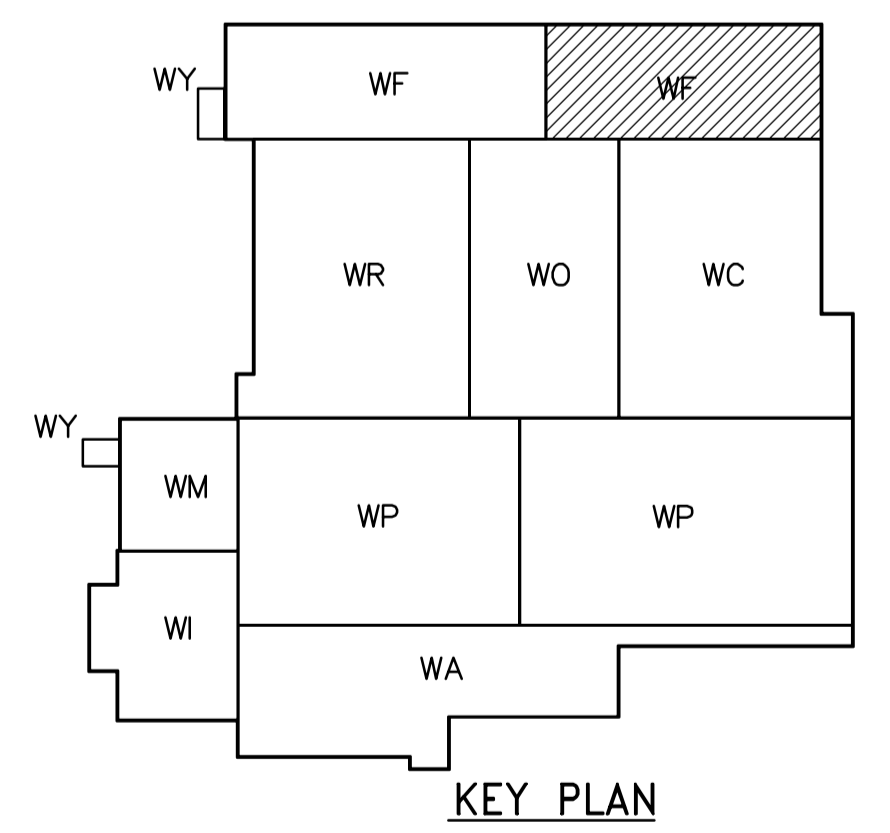

 APEGN Certificate of Authorization CH2M HILL Canada Ltd. No. 1441 Expiry: April 30, 2007	 Frederickson Cooper ARCHITECTS	 A Tyco International Ltd. Company	ENGINEER'S SEAL ORIGINAL SIGNED BY L.D. LLEWELLYN 2006/03/29	 THE CITY OF WINNIPEG WATER AND WASTE DEPARTMENT ENGINEERING DIVISION	CITY FILE NUMBER SHEET OF
	DESIGNED BY LL CHECKED BY ND DRAWN BY TL APPROVED BY AHL	SCALE: 1:100 RELEASED FOR CONSTRUCTION BY: R. SOROKOWSKI	CONSULTANT DRAWING NO. WF-E0122	WATER TREATMENT PLANT FILTRATION MECHANICAL AND ELECTRICAL	CITY DRAWING NUMBER 1-0601F-A-E0122-001-01D
	B.M. ELEV.	NO. REVISIONS DATE BY	DATE 2005/07/08 DATE 2006/03/29	ELECTRICAL FILTRATION AREA 2 SECOND FLOOR FACILITY PLAN (AREA 2)	
	01 742-2005 ADDENDUM 3 06/05/05 LL 00 ISSUED FOR TENDER 06/03/29 LL				