SHEET: COW-A1 (05/2005)

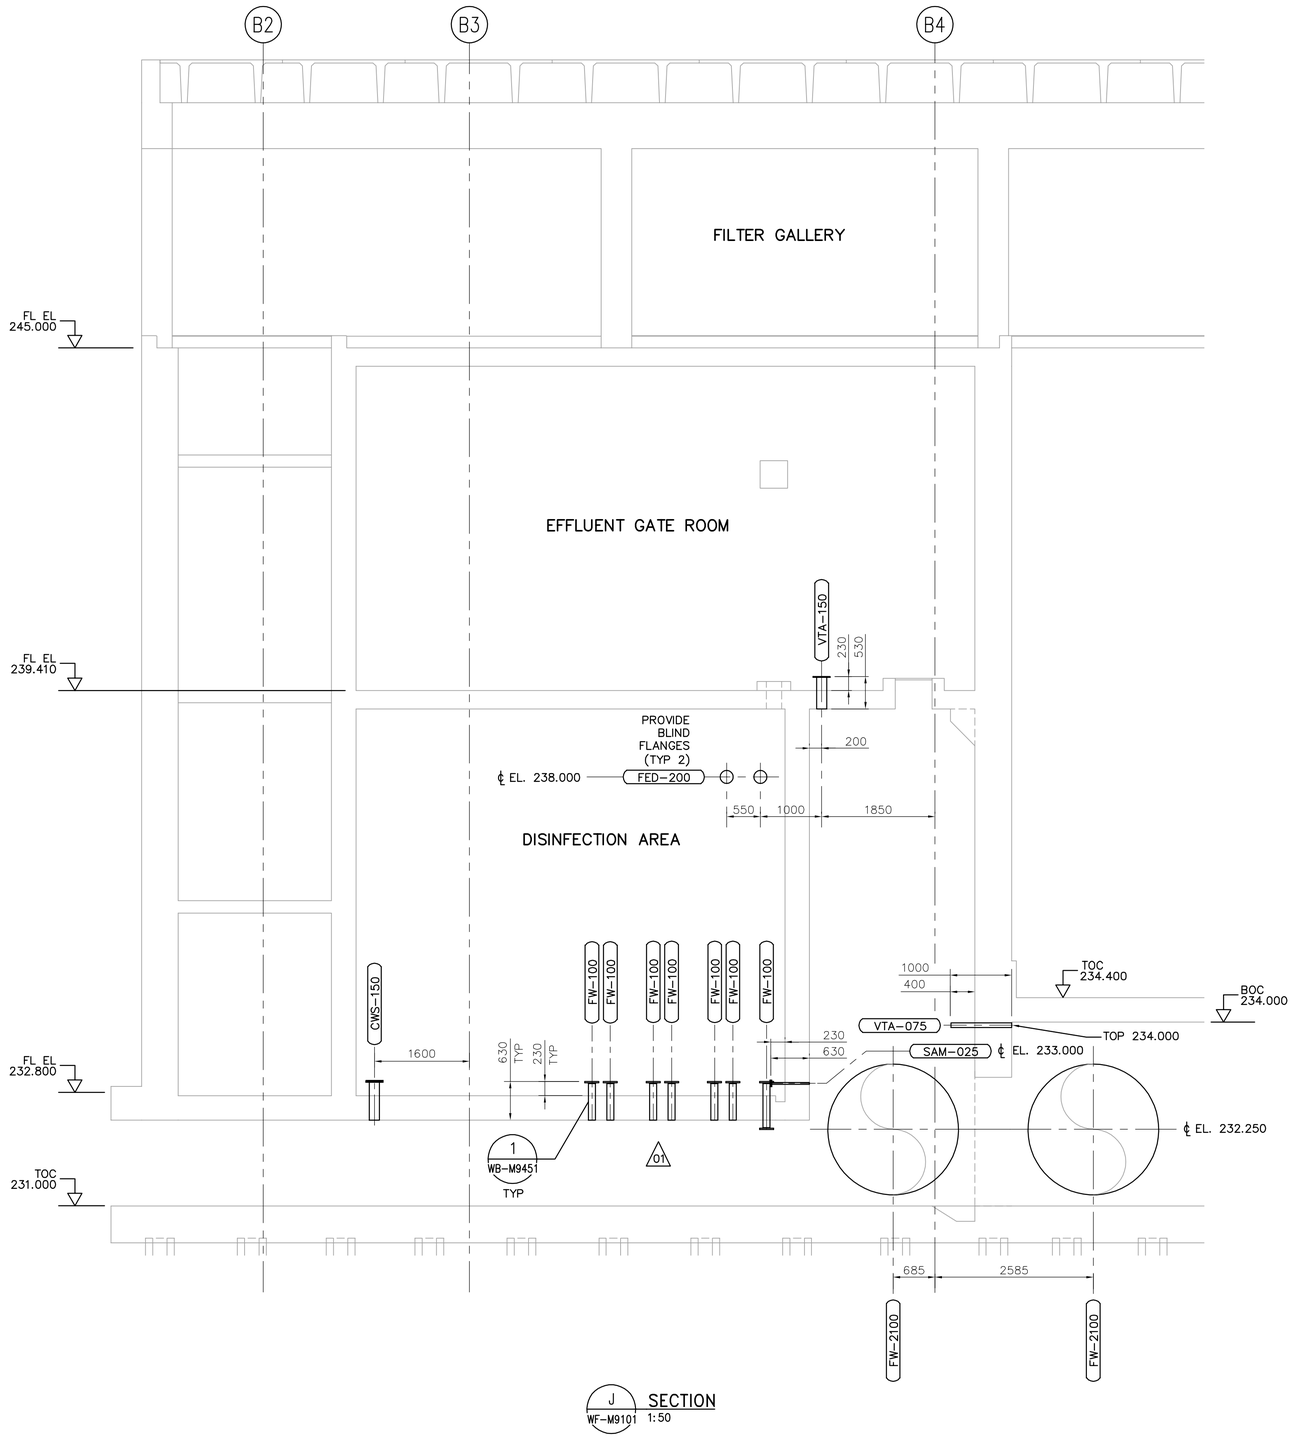

SCALE 1:50 METRES 0 1 2 3 4 5

SCALE 1:1 MILLIMETRES 0 20 40 60 80 100

APEGM
Certificate of Authorization
CH2M HILL Canada Ltd.
No. 1441 Expiry: April 30, 2007

B.M.
ELEV.

NO.	REVISIONS	DATE	BY
02	742-2005 ADDENDUM 3	06/05/05	PW
01	583-2005 ADDENDUM 3	06/03/10	PW
00	ISSUED FOR TENDER	2006/02/03	PW

CH2MHILL
Fredericksson Cooper ARCHITECTS
EarthTech A Tyco International Ltd. Company

DESIGNED BY	TB/PW	CHECKED BY	LS
DRAWN BY	TAR/EK	APPROVED BY	DJT
SCALE:	1:50	RELEASED FOR CONSTRUCTION BY:	R. SOROKOWSKI
DATE	2005/07/08	DATE	2006/02/08

ENGINEER'S SEAL
ORIGINAL SIGNED BY
P. WOBMA
2006/02/06

CONSULTANT DRAWING NO.
WF-M9209

Winnipeg
THE CITY OF WINNIPEG
WATER AND WASTE DEPARTMENT
ENGINEERING DIVISION

WATER TREATMENT PLANT
FILTRATION
MECHANICAL AND ELECTRICAL

CITY FILE NUMBER
SHEET OF

PROCESS MECHANICAL
PIPE EMBEDS
FILTRATION AREA SECTION

CITY DRAWING NUMBER
1-0601F-A-M9209-001-02D

Last Save: 2006-05-04 11:38 AM

C:\DOCUMENTS AND SETTINGS\SEVERITT\MY DOCUMENTS\NDMPROJ\321352 - WINNIPEGWTP\DN_WF-M9209_CH2M.DWG