


NOTE: CHAINAGES SHOWN ARE ALONG S. R. OF PANDORA AVE. (W)

PANDORA AVENUE (WEST)

SEWER SERVICE INFORMATION		
ADDRESS	SIZE	R. DIST. JUNCTION TIE
1340 PANDORA AVE		1.68 WEL BLDG
RESIDENTIAL		32.2 E 1ST MH E REGENT
1490 PANDORA AVE		5.10 EWL BLDG
COMMERCIAL		3.10 E 1ST MH E REGENT

FOR CONSTRUCTION NOTES SEE DRAWING 05533

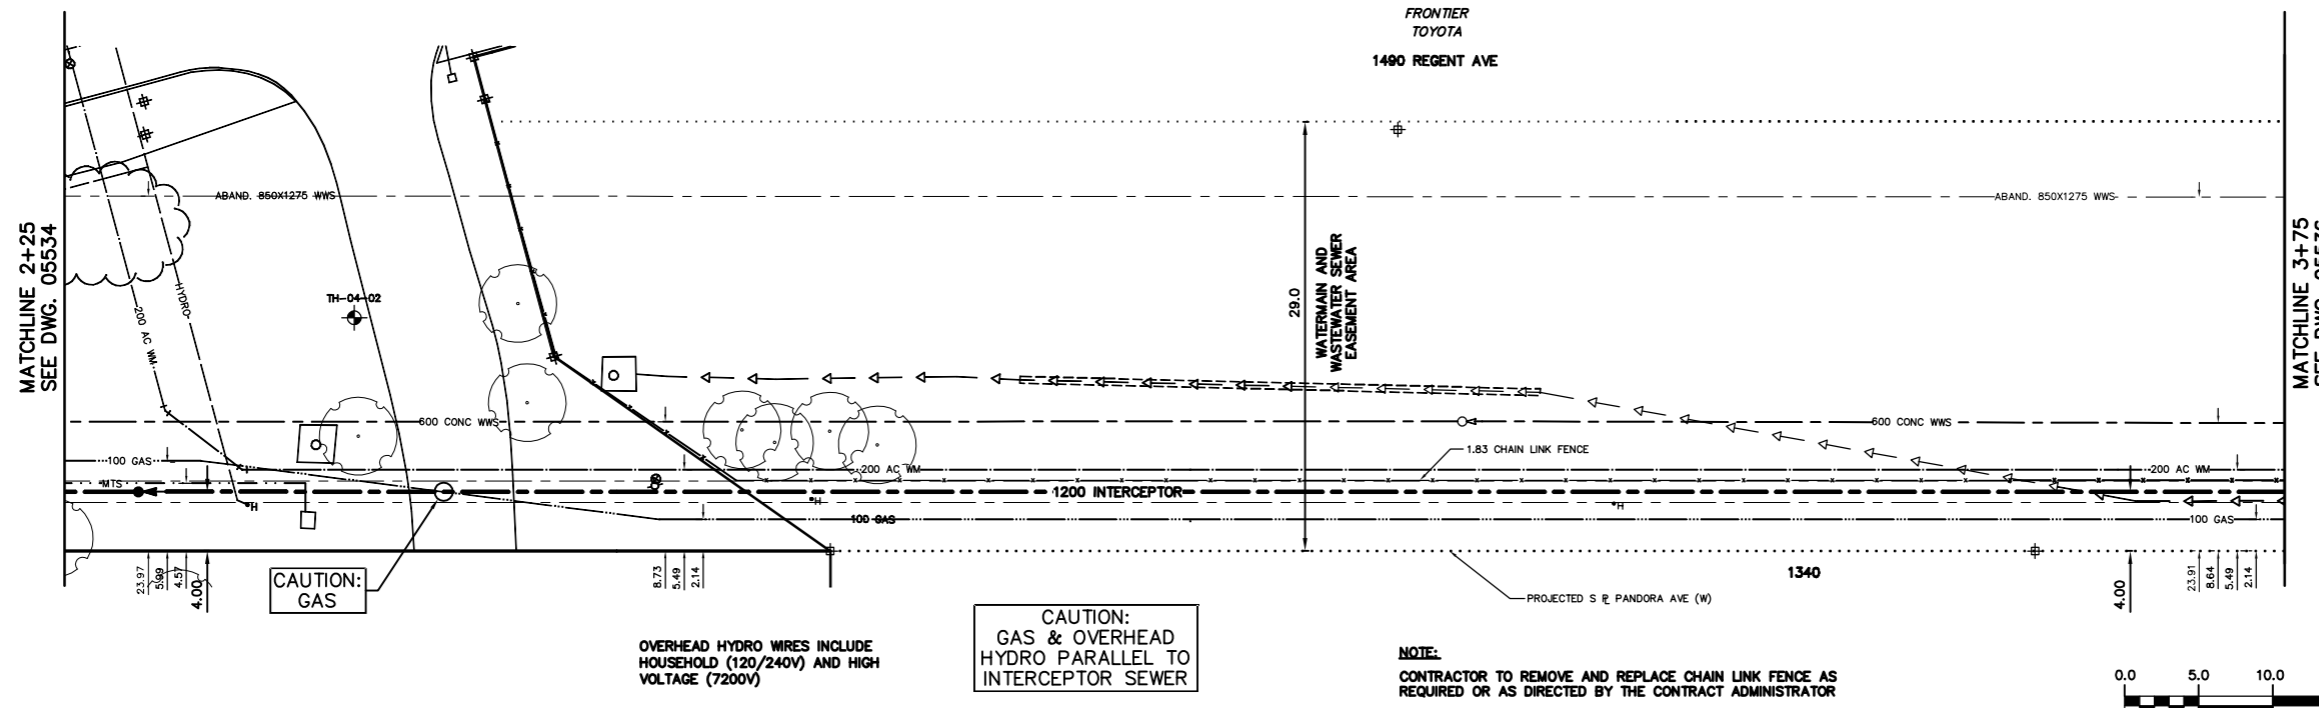

METRIC
WHOLE NUMBERS INDICATE MILLIMETRES
DECIMALIZED NUMBERS INDICATE METRES

WARNING
IF POWER EQUIPMENT OR EXPLOSIVES ARE TO BE USED FOR EXCAVATION ON THIS PROJECT THE CONTRACTOR
LOCATION OF EXCAVATION:
1) NOTIFY THE GAS COMPANY OF THE PROPOSED
2) TAKE PRECAUTION TO AVOID DAMAGE TO GAS COMPANY INSTALLATIONS.
SEE PROVINCIAL REGULATION 210/72 FOR DETAILS

200 WM	WATERMAIN	200 WM	SL, HYDRO	150 WM	WATERMAIN	150 WM
⊕	HYDRANT	⊕	MTS	⊕	HYDRANT	⊕
⊙	VALVE	⊙	TRAFFIC SIGNALS	⊕	VALVE	⊕
525 LDS	LAND DRAINAGE SEWER	525 LDS	GAS	300 LDS	LAND DRAINAGE SEWER	300 LDS
375 WWS	WASTEWATER SEWER	375 WWS	SURVEY BAR	250 WWS	WASTEWATER SEWER	250 WWS
○	MANHOLE	○	FENCE	⊕	PROFILE	⊕
□	CATCH BASIN	□	POLE - HYDRO, MTS	⊕	GROUND ABOVE PIPE	⊕
▽	CURB INLET	▽	CURB STOP	⊕	⊕ DITCH (NORTH & WEST)	⊕
⊕	JUNCTIONS	⊕	GUY ANCHOR	⊕	⊕ DITCH (SOUTH & EAST)	⊕
⊕	CULVERT	⊕	LIGHT STANDARD			
⊕	ANODE	⊕	TREE			
EXISTING	LEGEND-PLAN	PROPOSED	EXISTING	LEGEND-PLAN	PROPOSED	EXISTING

LOCATION APPROVED UNDERGROUND STRUCTURES		B.M. ELEV.	FIELD BOOK #:
POSTED TO LBIS			
1.) REVISION - ADDED MH NUMBERS	05.04.11	SC	
NO. REVISIONS	DATE	BY	DATE

CITY OF WINNIPEG
WATER AND WASTE
ENGINEERING DIVISION

DESIGNED BY: SC
CHECKED BY: TW
DRAWN BY: CJH
APPROVED BY: KZ

HOR. SCALE: 1:250
VERTICAL: 1:50

RELEASED FOR CONSTRUCTION: 2005 03 31

ENGINEER'S SEAL
ORIGINAL SIGNED BY K.R. ZUREK
05/03/31

THE CITY OF WINNIPEG
WATER AND WASTE DEPARTMENT

NORTHEAST INTERCEPTOR
STAGE VII
PANDORA AVENUE (WEST)
322 m W OF W.P. STARLIGHT DRIVE TO
172 m W OF W.P. STARLIGHT DRIVE

SHEET 3 of 18
CITY DRAWING NUMBER
05533