SHEET: COW-A1 (05/2005)

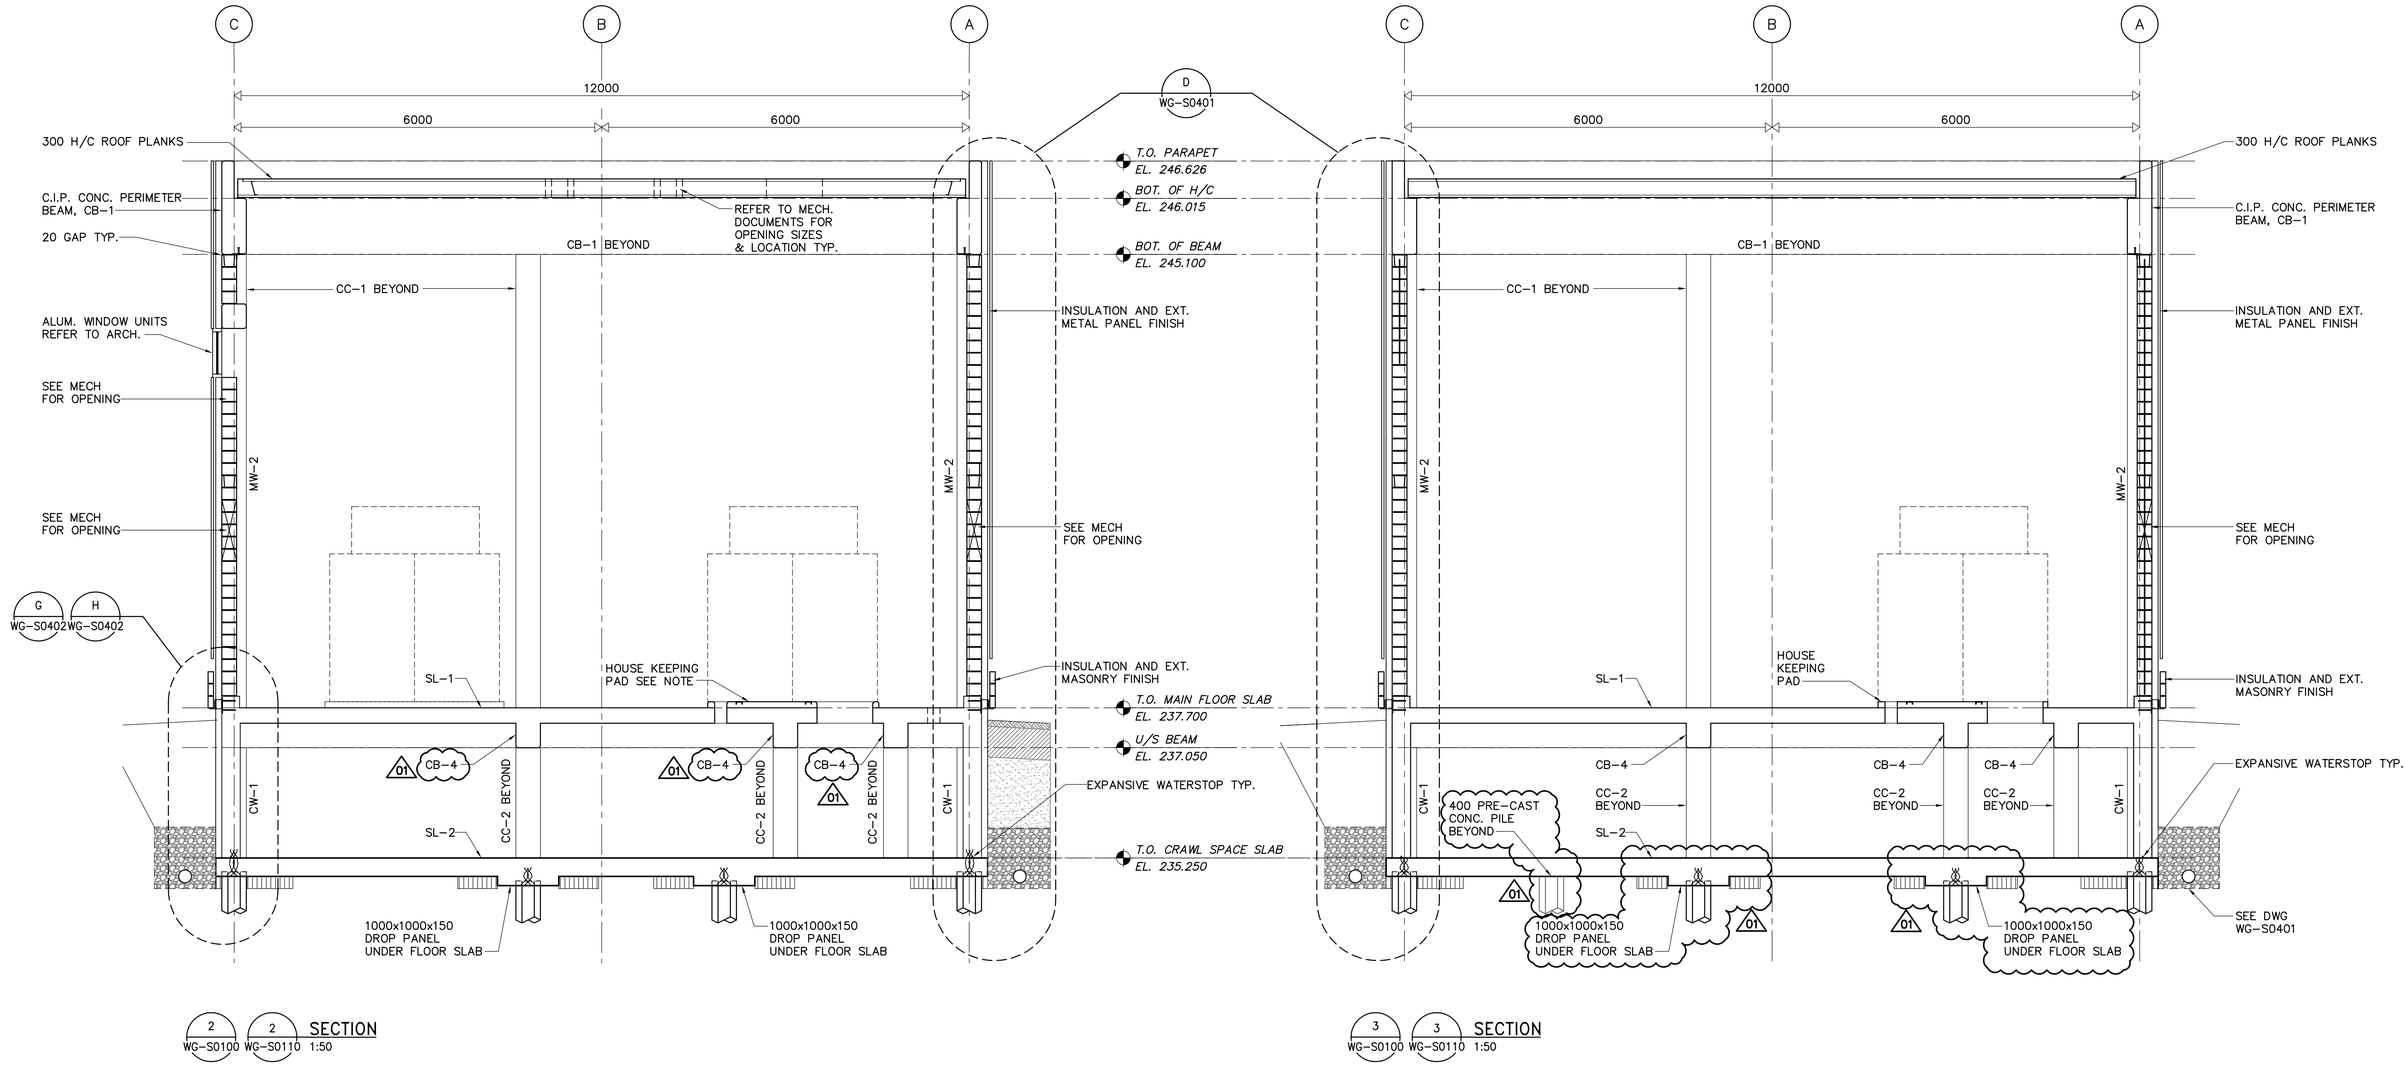

2 WG-S0100 2 WG-S0110 SECTION 1:50

3 WG-S0100 3 WG-S0110 SECTION 1:50

NOTE:
1. SEE MECH. & ELECT. DWG. FOR SIZE & LOCATION OF CONC. HOUSEKEEPING PADS

APEGM
Certificate of Authorization
Earth Tech Canada Inc.
No. 730 Expiry: April 30, 2007

B.M. ELEV.

NO.	REVISIONS	DATE	BY
01	498-2006 ADDENDUM 2	06/09/22	KK
00	ISSUED FOR TENDER	06/08/28	KK

CH2MHILL / Frederickson Cooper ARCHITECTS / EarthTech A Tyco International Ltd. Company

DESIGNED BY	AP/GGP	CHECKED BY	MK
DRAWN BY	KK	APPROVED BY	AHL
SCALE:	AS SHOWN	RELEASED FOR CONSTRUCTION BY:	R. SOROKOWSKI
DATE	2006/06/16	DATE	2006/08/30

ENGINEER'S SEAL
ORIGINAL SIGNED BY
A. POCHANART
2006/08/30

CONSULTANT DRAWING NO.
WG-S0202

Winnipeg
THE CITY OF WINNIPEG
WATER AND WASTE DEPARTMENT
ENGINEERING DIVISION

WATER TREATMENT PLANT
STANDBY POWER GENERATOR

CITY FILE NUMBER
SHEET OF

STRUCTURAL
BUILDING SECTIONS

CITY DRAWING NUMBER
1-0601G-A-S0202-001-01D

Last Save: 2006-09-27 9:48 AM

L:\WORK\79000\79538\02A-CAD\IND\CONTR\GENSET\DN_WG-S0202_ET.DWG