SHEET: COW-A1 (05/2005)

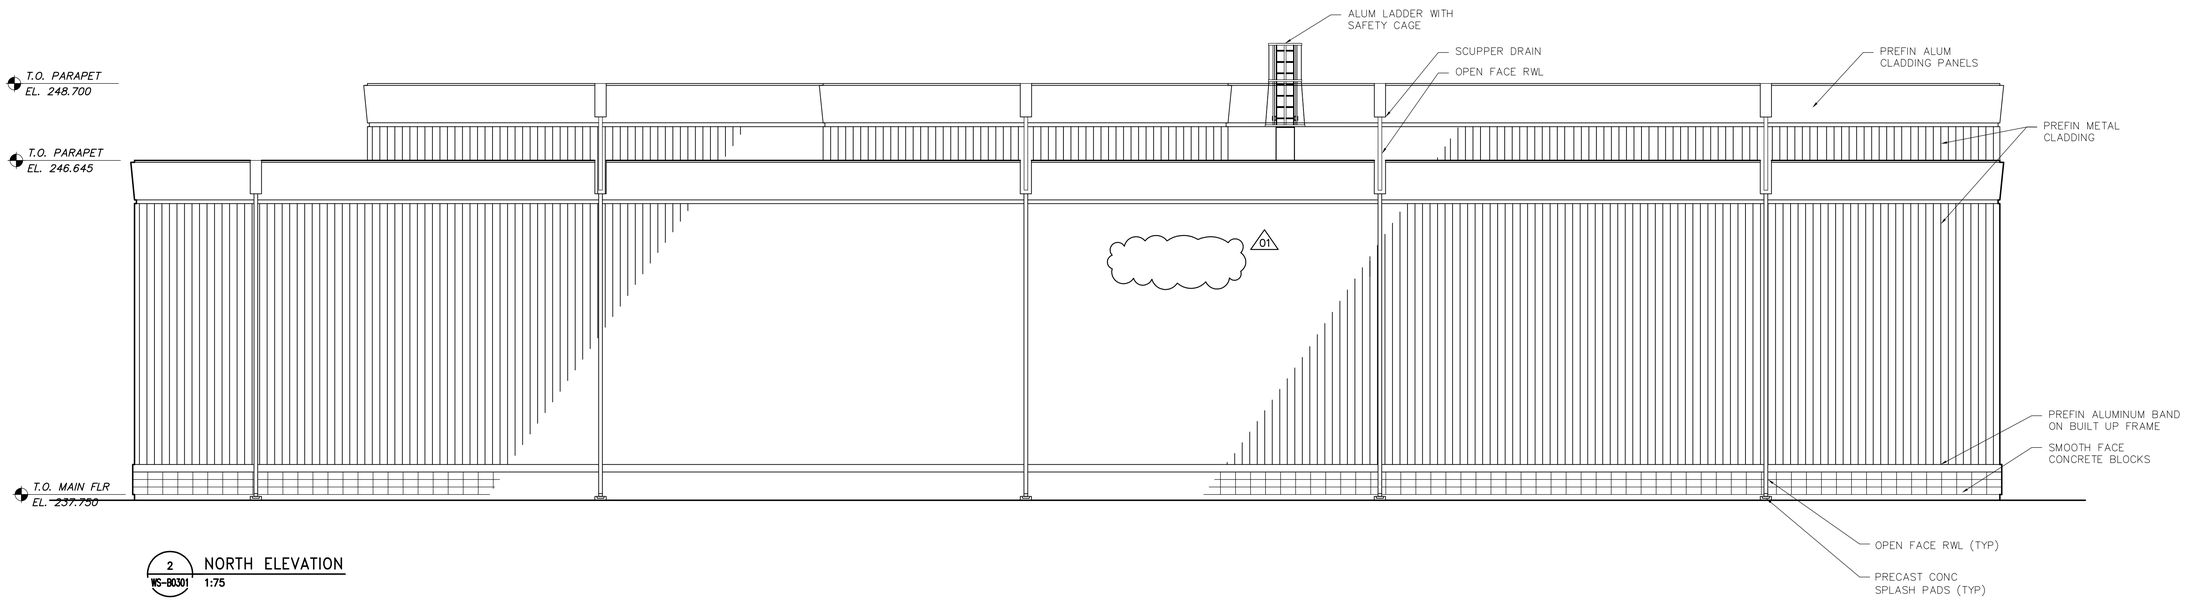

2 WS-B0301 NORTH ELEVATION
1:75

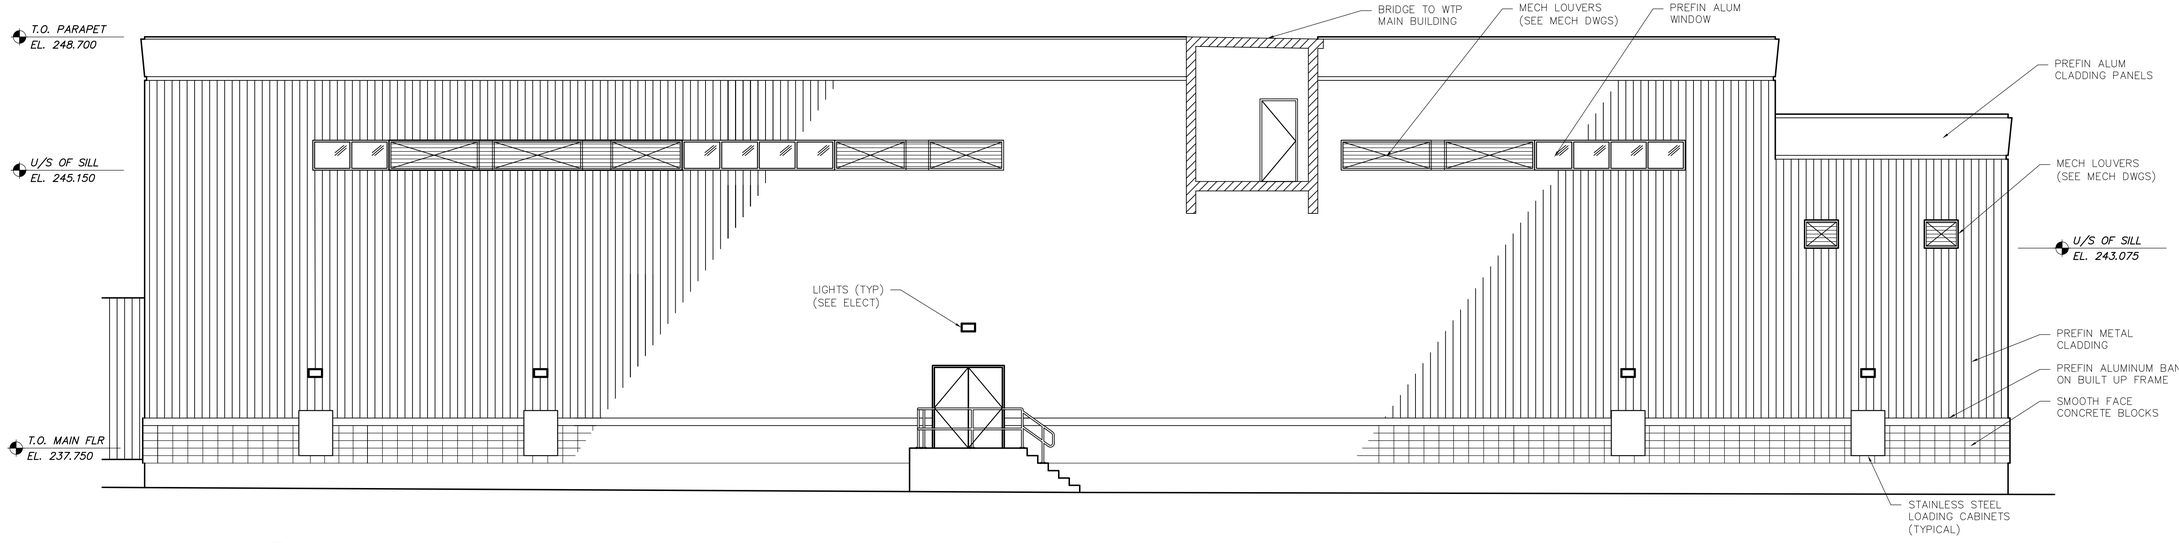

1 WS-B0301 SOUTH ELEVATION
1:75

PROVINCE OF MANITOBA
NEIL COOPER
ARCHITECT
INC.
№090
APPROVED ARCHITECTURAL CORPORATION

B.M.
ELEV.

NO.	REVISIONS	DATE	BY
01	792-2006 ADDENDUM 2	07/03/20	AL
00	ISSUED FOR TENDER	07/01/31	AL

CH2MHILL
Frederickson Cooper
ARCHITECTS

EarthTech
A Tyco International Ltd. Company

DESIGNED BY	NC	CHECKED BY	LK
DRAWN BY	AL	APPROVED BY	AHL
SCALE:	AS SHOWN	RELEASED FOR CONSTRUCTION BY:	R. SOROKOWSKI
DATE	2006/09/01	DATE	2007/01/31

ENGINEER'S SEAL
ORIGINAL SIGNED BY
NEIL COOPER
2007/01/31

CONSULTANT DRAWING NO.
WS-B0301

Winnipeg

THE CITY OF WINNIPEG
WATER AND WASTE DEPARTMENT
ENGINEERING DIVISION

WATER TREATMENT PLANT
BULK CHEMICAL BUILDING
SODIUM HYPOCHLORITE AND CHEMICAL STORAGE BUILDING

ARCHITECTURAL
BUILDING ELEVATIONS

CITY FILE NUMBER
SHEET OF
CITY DRAWING NUMBER
1-0601S-A-B0301-001-01D

Last Save: 2007-03-21 3:53 PM

E:\NC\JOBDATA\2004\04018 WINNIPEG WATER TREATMENT\02A-CAD\BULK CHEMICAL BUILDING\CONT DWGS\ARCH DWGS\ADDENDUM 2\DN_WS-B0301_FC.DWG