


1 SODIUM HYDROXIDE ROOM HEATING AND VENTILATION SCHEMATIC (MAU-H802A)
- N.T.S.

UY RELAY IN FIRE PANEL
I HARDWIRED INTERLOCK
TO SHUTDOWN ALL HVAC SYSTEMS IN EVENT OF FIRE ALARM

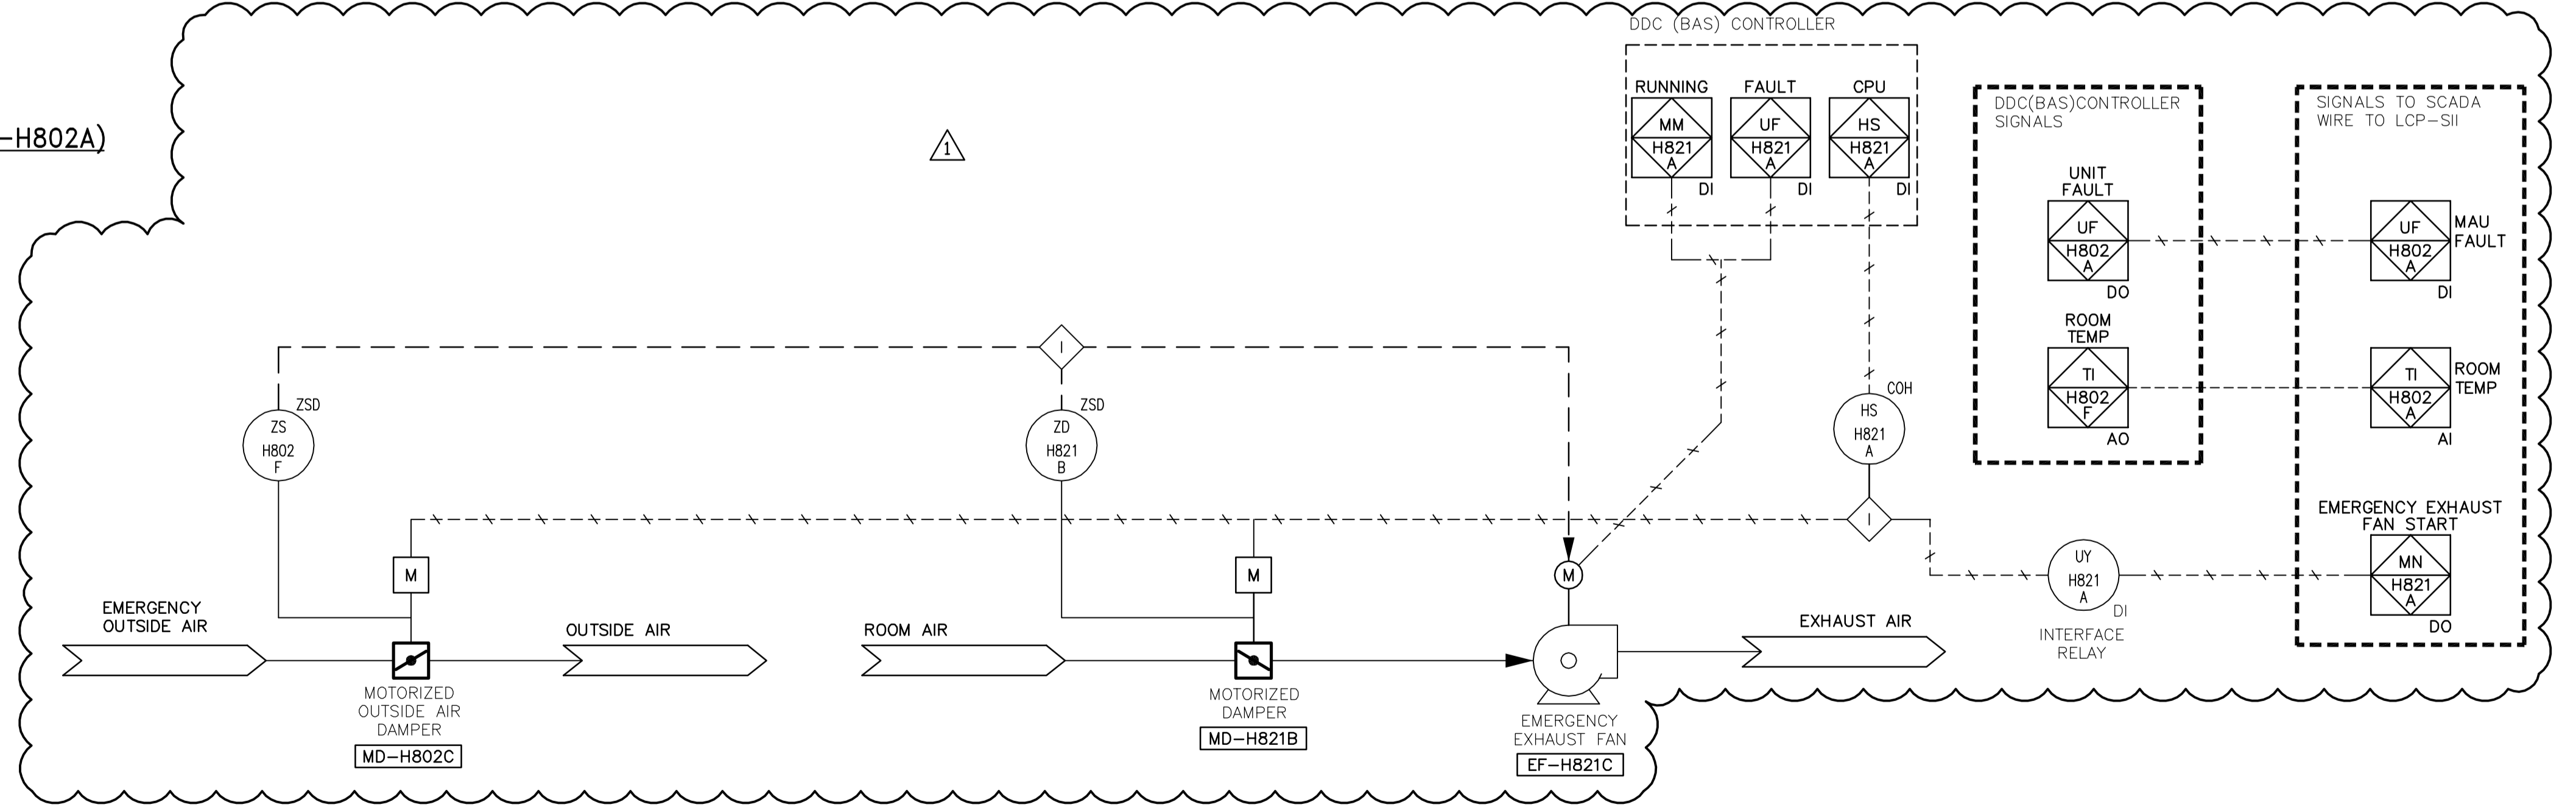

<p>Certificate of Authorization Earth Tech Canada Inc. No. 730 Expiry: April 30, 2007</p>	<p>B.M. ELEV.</p>		<p>Frederickson Cooper ARCHITECTS</p>	<p>A Tech International Ltd. Company</p>	<p>ENGINEER'S SEAL</p>		<p>THE CITY OF WINNIPEG WATER AND WASTE DEPARTMENT ENGINEERING DIVISION</p>	<p>WATER TREATMENT PLANT BULK CHEMICAL BUILDING SODIUM HYPOCHLORITE AND CHEMICAL STORAGE BUILDING</p>		<p>CITY FILE NUMBER</p>	
	<p>DESIGNED BY PVL/LJW</p>				<p>CHECKED BY PVL/AMA</p>			<p>ORIGINAL SIGNED BY A. M. AFTANAS</p>		<p>SHEET OF</p>	
	<p>DRAWN BY LJW</p>				<p>APPROVED BY AHL</p>			<p>2007/01/31</p>		<p>CITY DRAWING NUMBER</p>	
	<p>SCALE: N.T.S.</p>				<p>RELEASED FOR CONSTRUCTION BY: R. SOROKOWSKI</p>			<p>CONSULTANT DRAWING NO. WS-H0515</p>		<p>MECHANICAL SODIUM HYDROXIDE ROOM HEATING AND VENTILATION SYSTEM SCHEMATIC</p>	