



3 BUILDING SECTION
WS-B0100 1:75

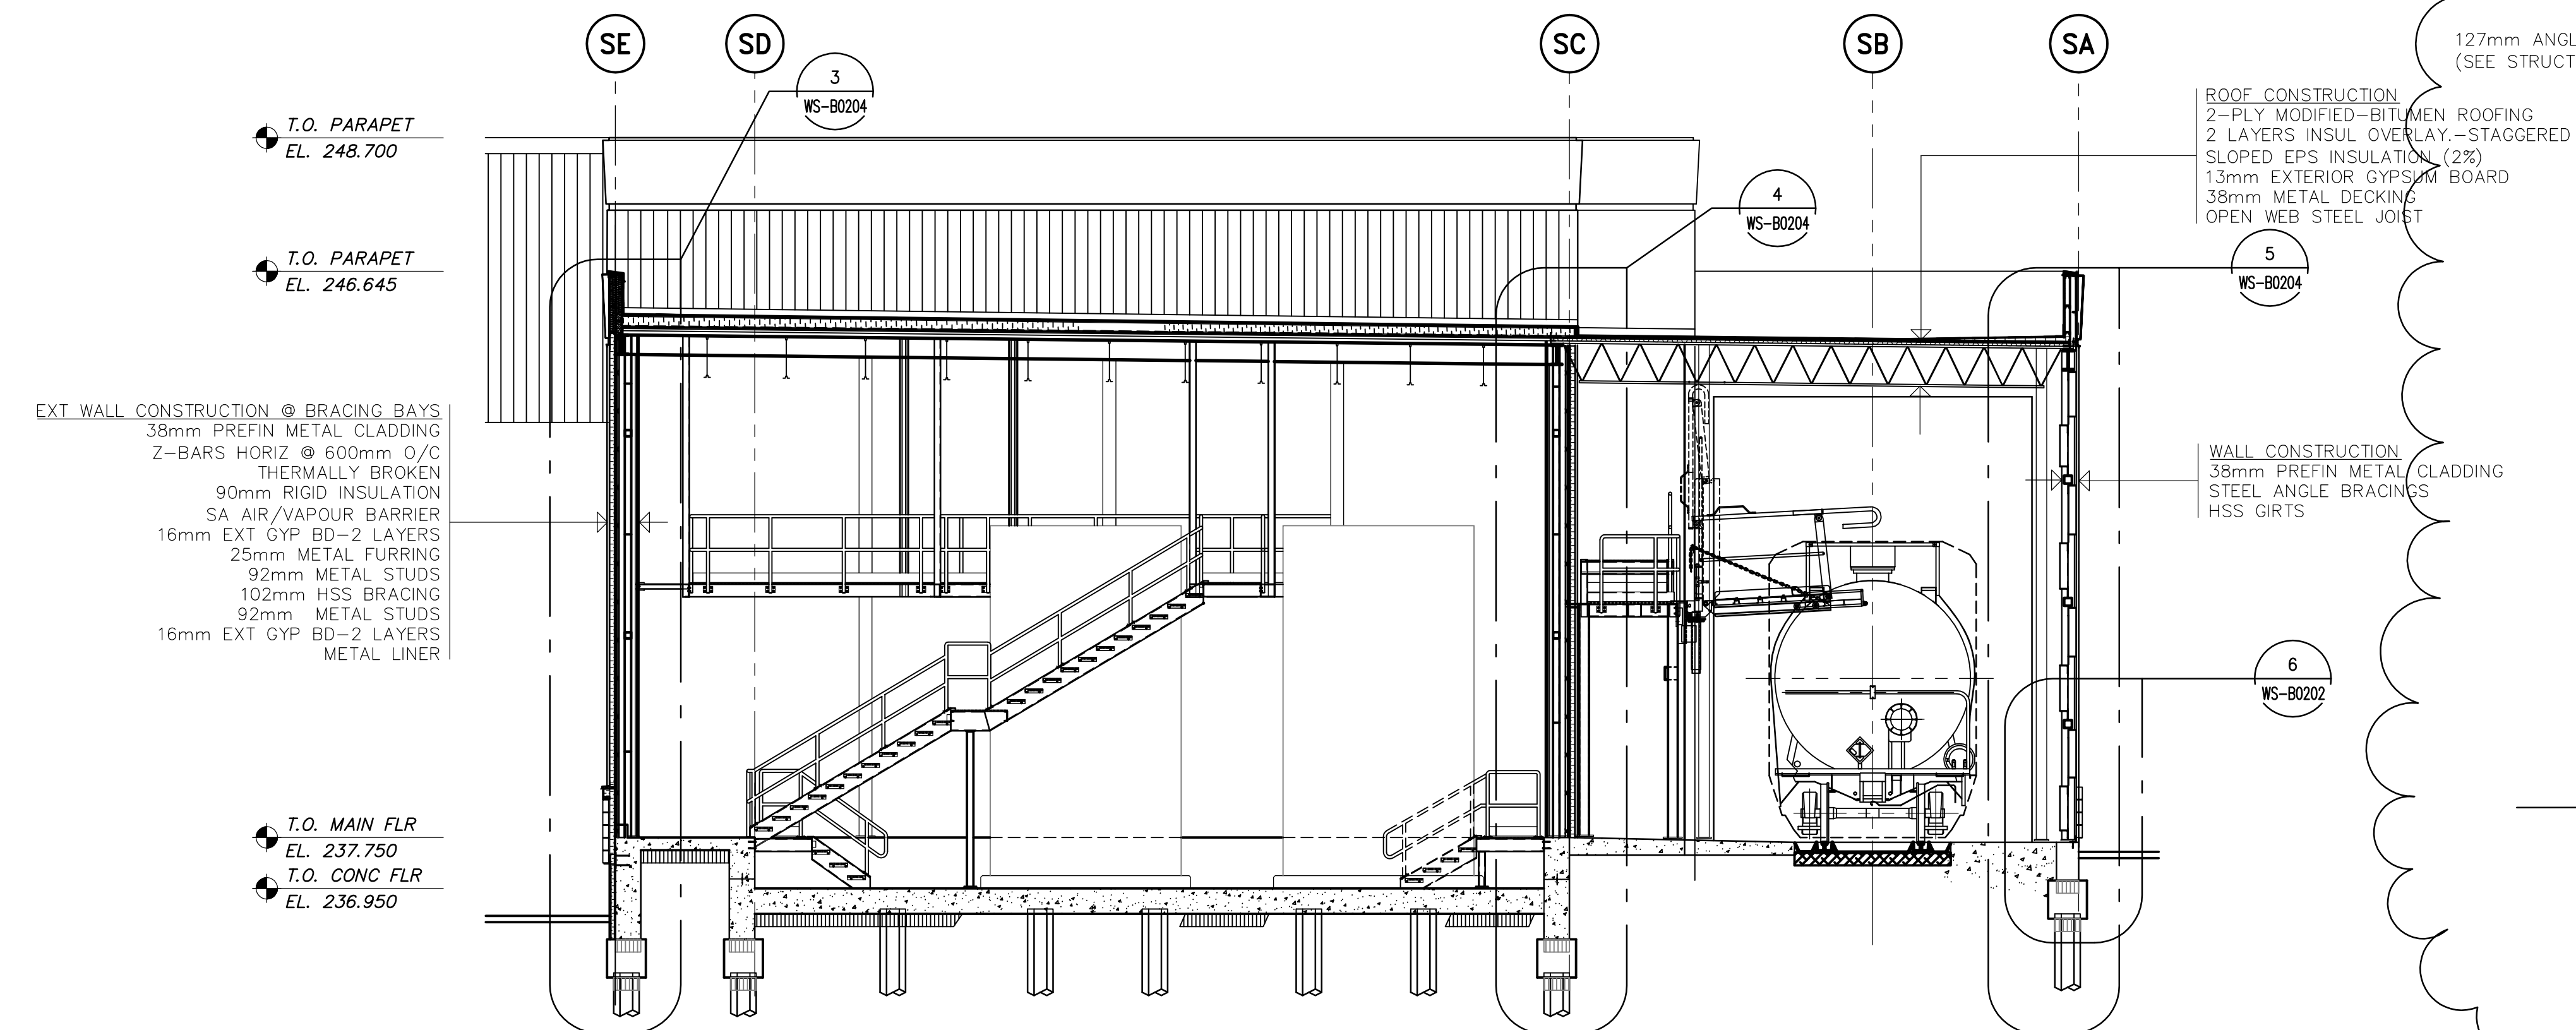

4 BUILDING SECTION
WS-B0100 1:75

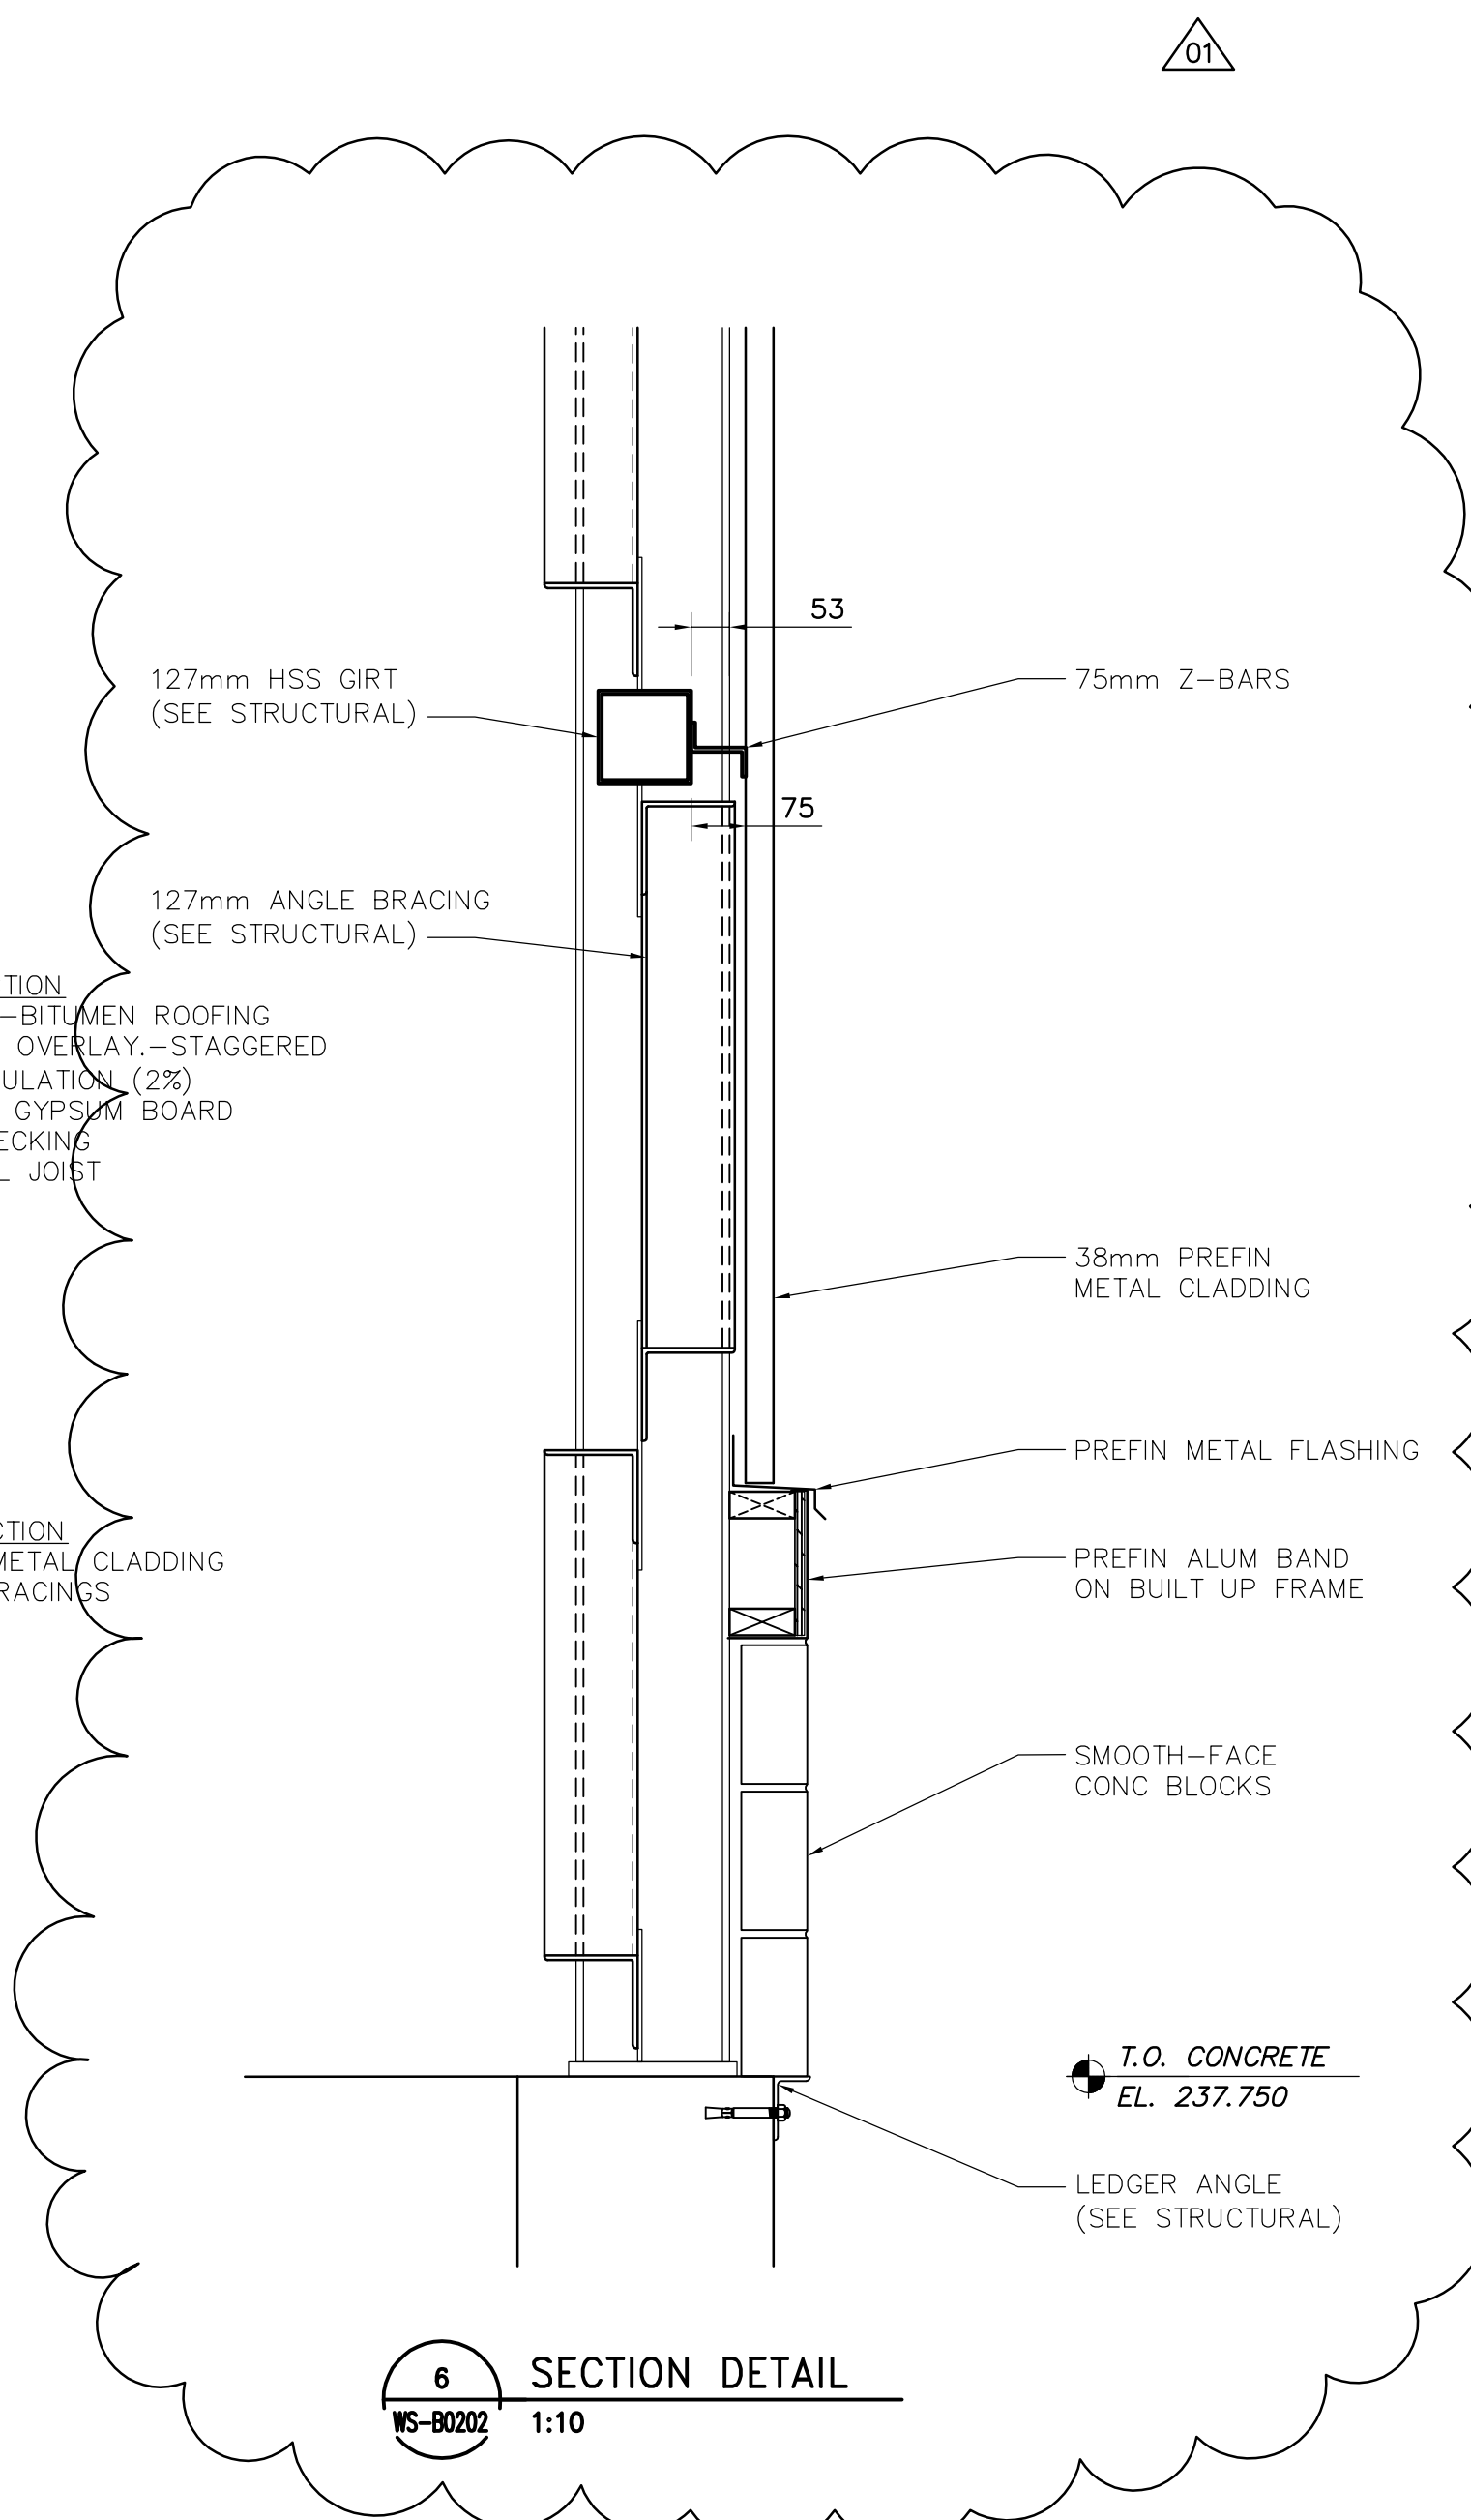

6 SECTION DETAIL
WS-B0202 1:10



B.M. ELEV.					
DESIGNED BY	NC	CHECKED BY	LK		
DRAWN BY	AL	APPROVED BY	AHL		
SCALE:	AS SHOWN	RELEASED FOR CONSTRUCTION BY:	R. SOROKOWSKI		
NO. REVISIONS		DATE	2006/09/01	DATE	2007/01/31

CH2MHILL
Frederickson Cooper ARCHITECTS

EarthTech
A Tyco International Ltd. Company

ENGINEER'S SEAL
ORIGINAL SIGNED BY
NEIL COOPER
2007/01/31

CONSULTANT DRAWING NO.
WS-B0202

THE CITY OF WINNIPEG
WATER AND WASTE DEPARTMENT
ENGINEERING DIVISION

WATER TREATMENT PLANT
BULK CHEMICAL BUILDING
SODIUM HYPOCHLORITE AND CHEMICAL STORAGE BUILDING

ARCHITECTURAL
BUILDING SECTIONS

CITY FILE NUMBER
SHEET OF
CITY DRAWING NUMBER
1-0601S-A-B0202-001-01D