


COW-A3 (02/2006)

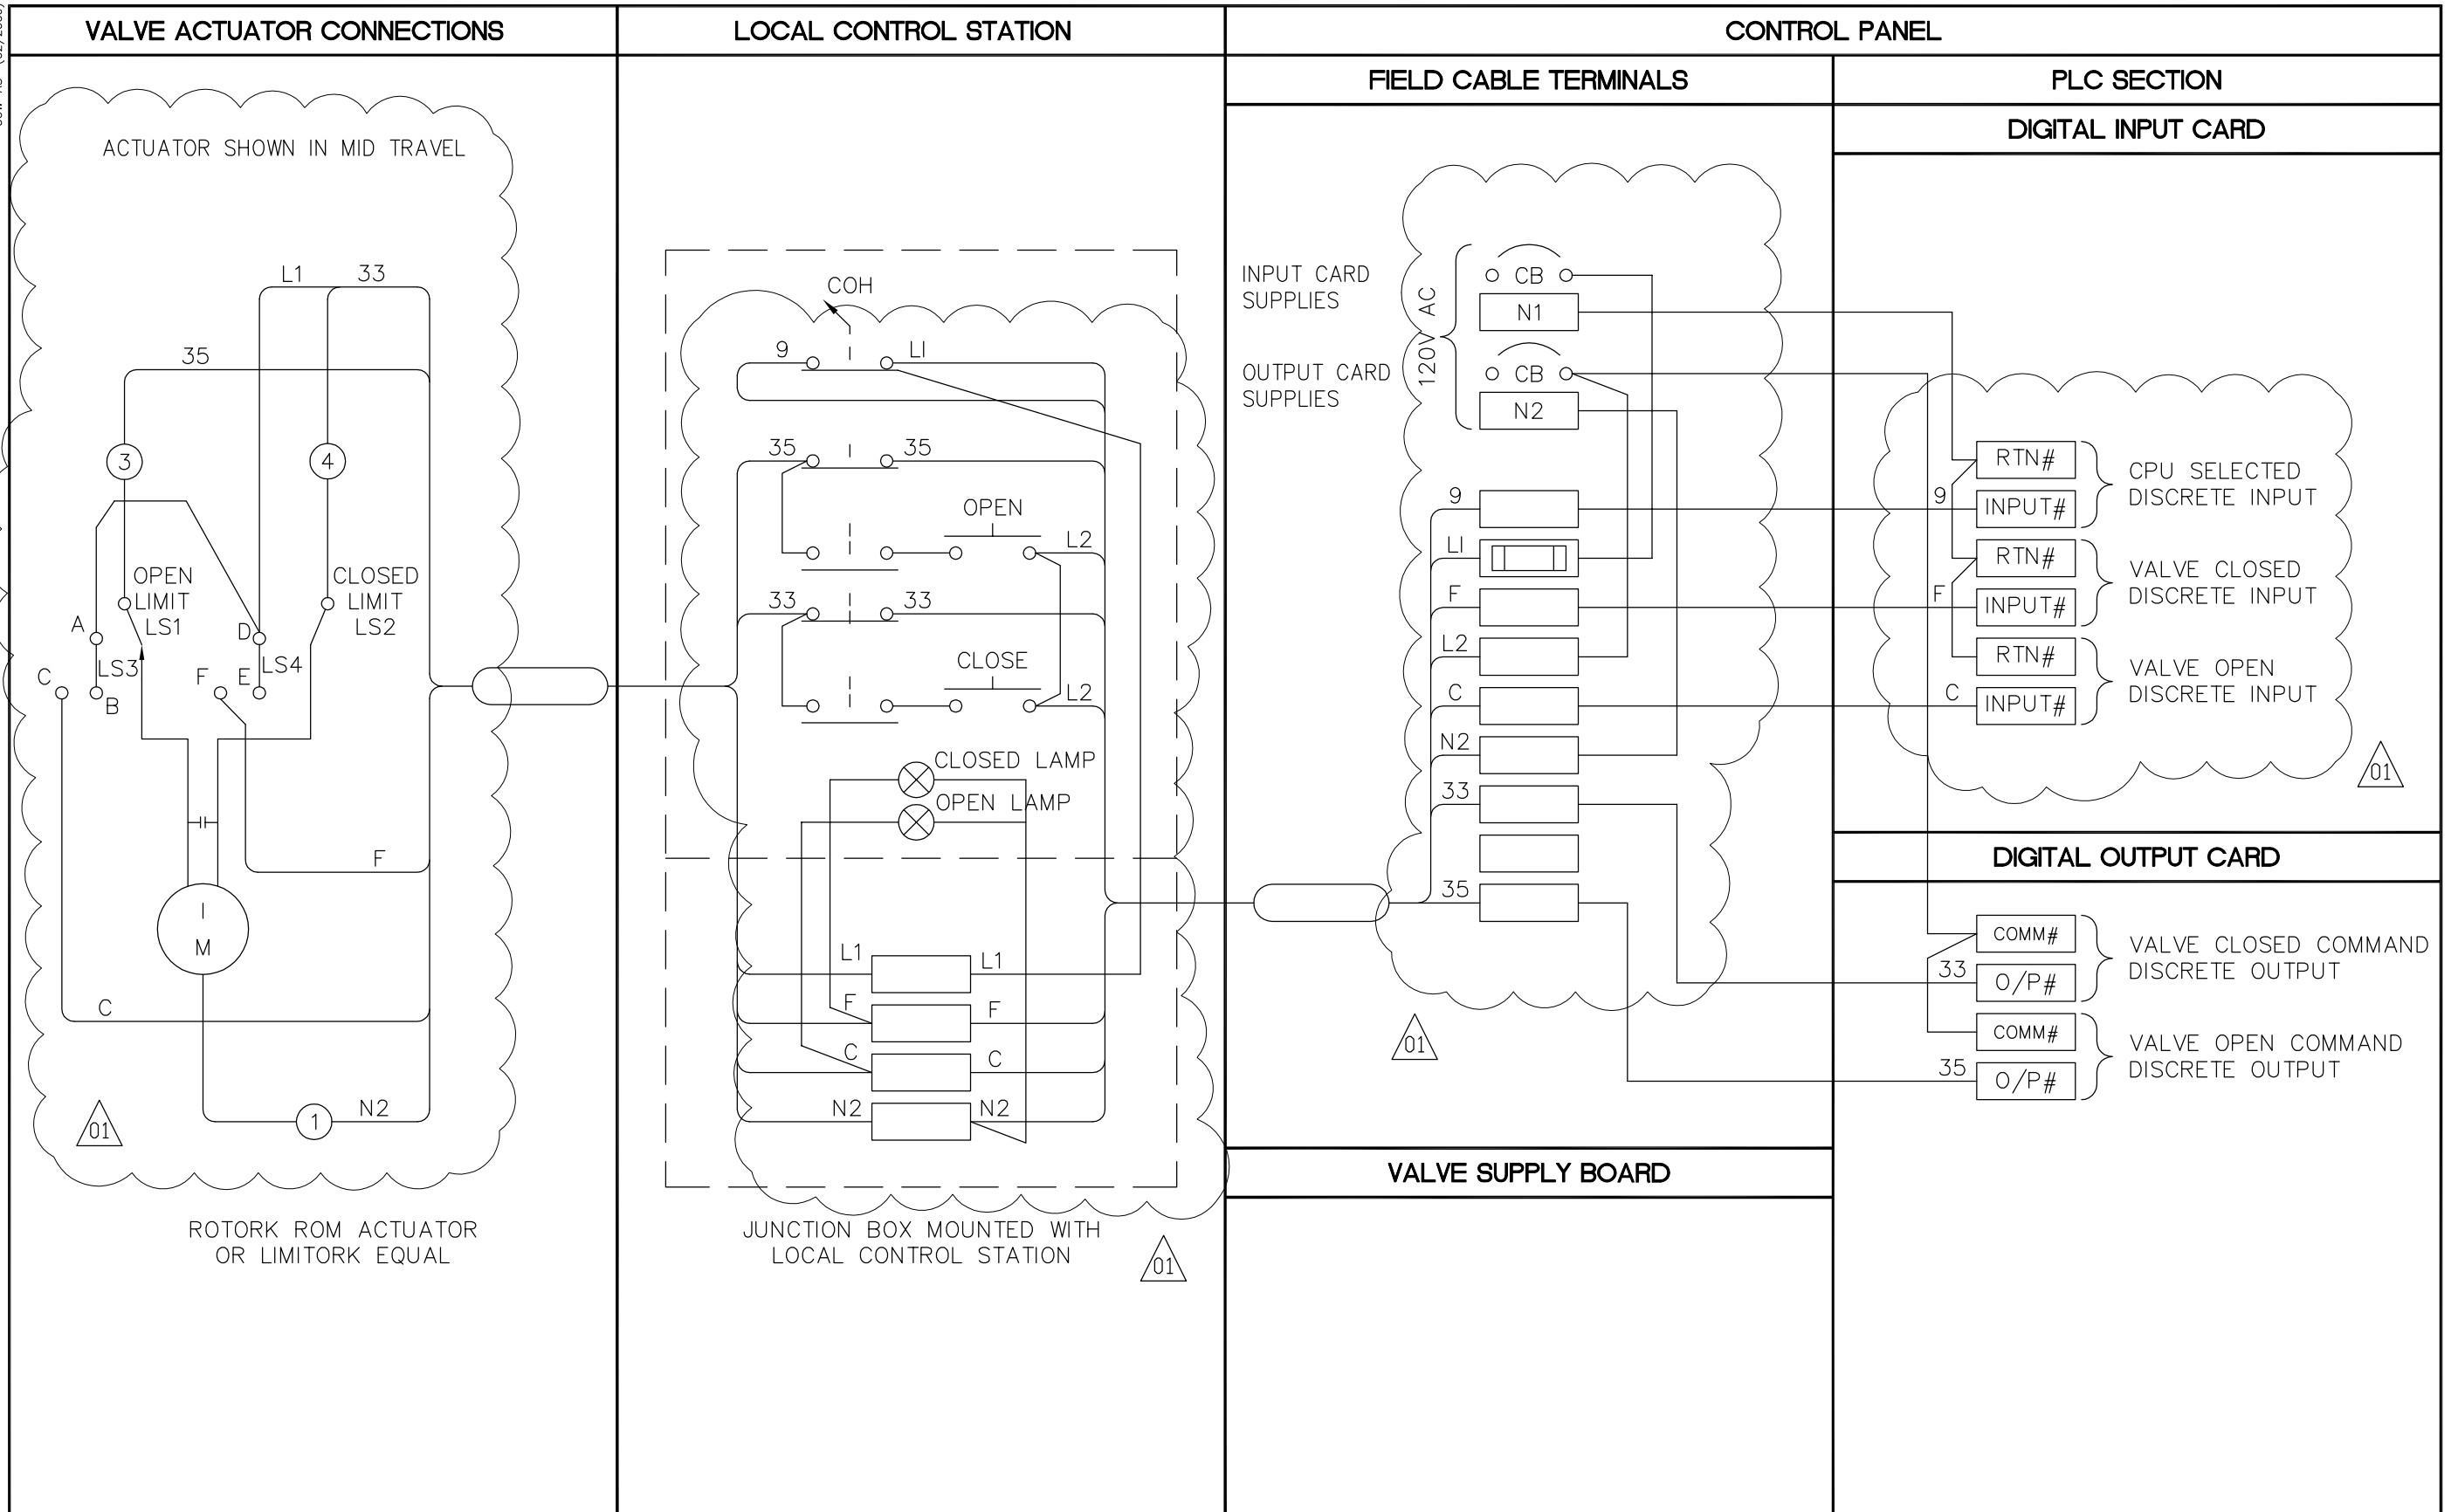

NOTE:

1. IF ACTUATOR CONTROLS ARE INACCESSIBLE THEN THIS ARRANGEMENT WILL APPLY.

<p>APEGM Certificate of Authorization Earth Tech Canada Inc. No. 730 Expiry: April 30, 2007</p>	<p>B.M. ELEV.</p>	<p>DESIGNED BY: NT DRAWN BY: GLG SCALE: NTS</p>	<p>CHECKED BY: SWT APPROVED BY: AHL RELEASED FOR CONSTRUCTION BY: R. SOROKOWSKI</p>	<p>ENGINEER'S SEAL</p> <p>ORIGINAL SIGNED BY: S.W. TORMEY 2007/01/31</p>	<p>THE CITY OF WINNIPEG WATER AND WASTE DEPARTMENT ENGINEERING DIVISION</p>										
	<table border="1"> <tr> <td>01</td> <td>792-2006 ADDENDUM 4</td> <td>07/04/05</td> <td>LAE</td> </tr> <tr> <td>00</td> <td>ISSUED FOR TENDER</td> <td>07/01/31</td> <td>LAE</td> </tr> <tr> <td>NO.</td> <td>REVISIONS</td> <td>DATE</td> <td>BY</td> </tr> </table>					01	792-2006 ADDENDUM 4	07/04/05	LAE	00	ISSUED FOR TENDER	07/01/31	LAE	NO.	REVISIONS
01	792-2006 ADDENDUM 4	07/04/05	LAE												
00	ISSUED FOR TENDER	07/01/31	LAE												
NO.	REVISIONS	DATE	BY												