




**3 BUILDING SECTION**  
 WS-B0100 1:75

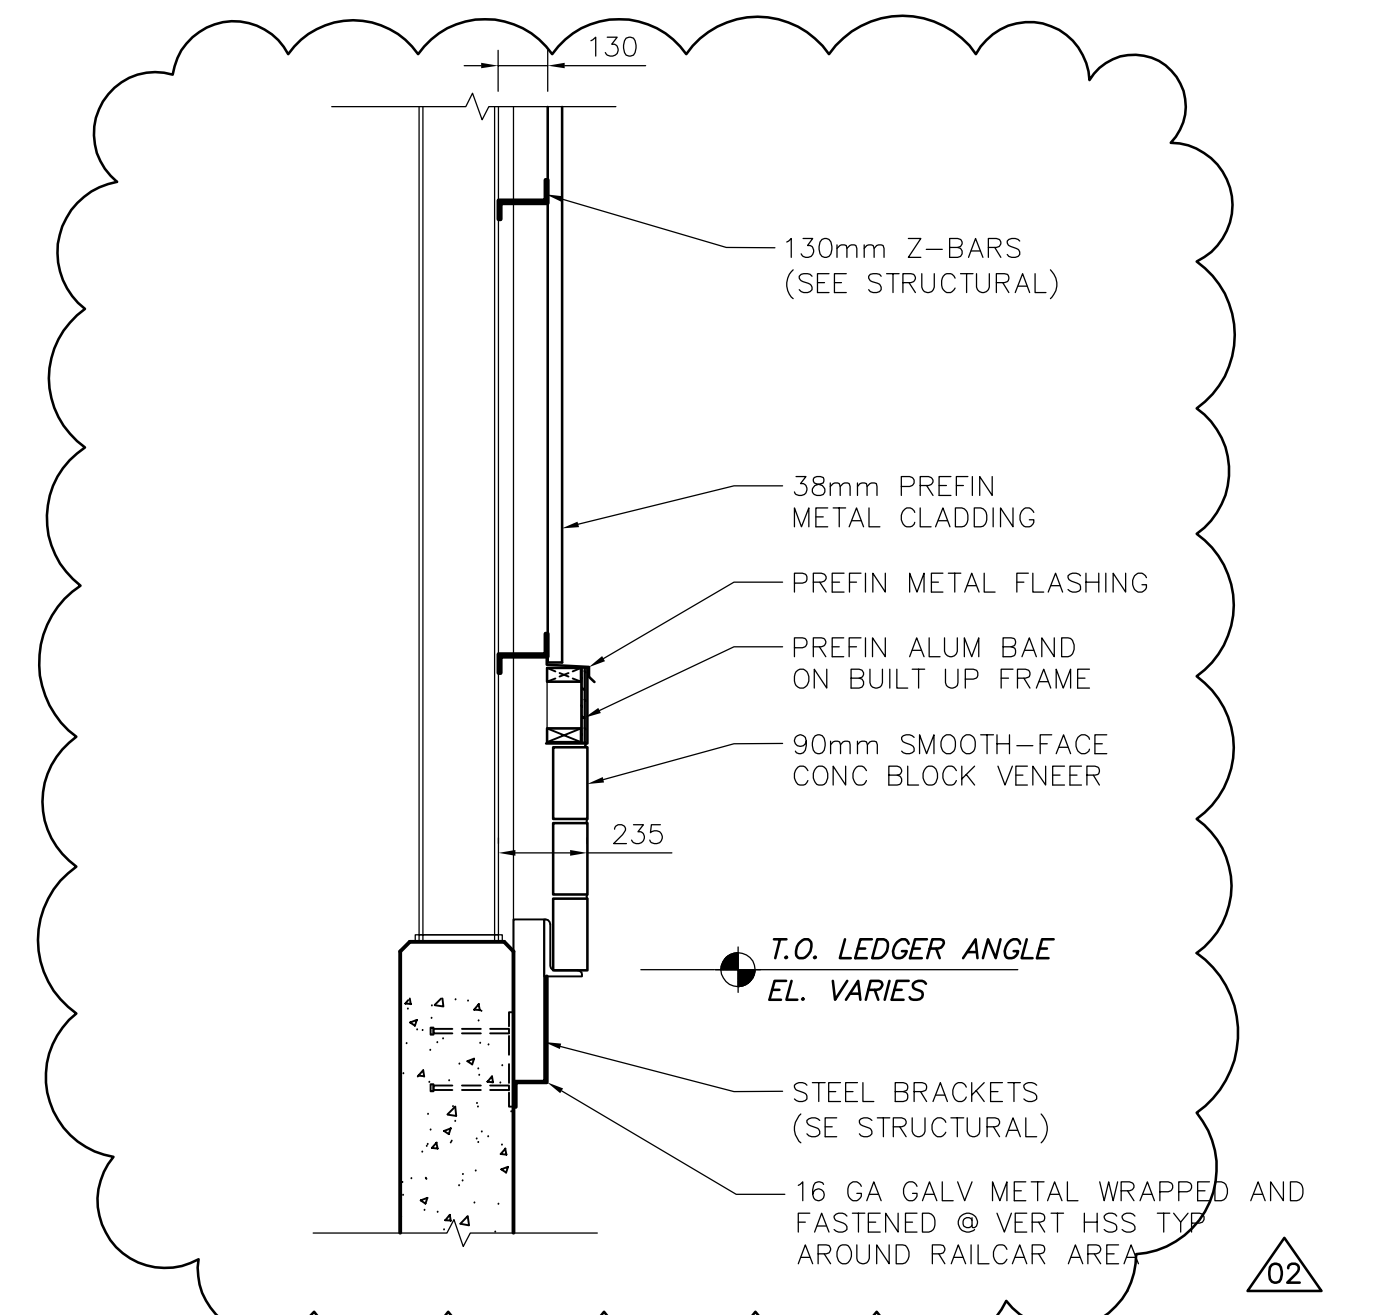

**5 SECTION DETAIL**  
 WS-B0110 1:20

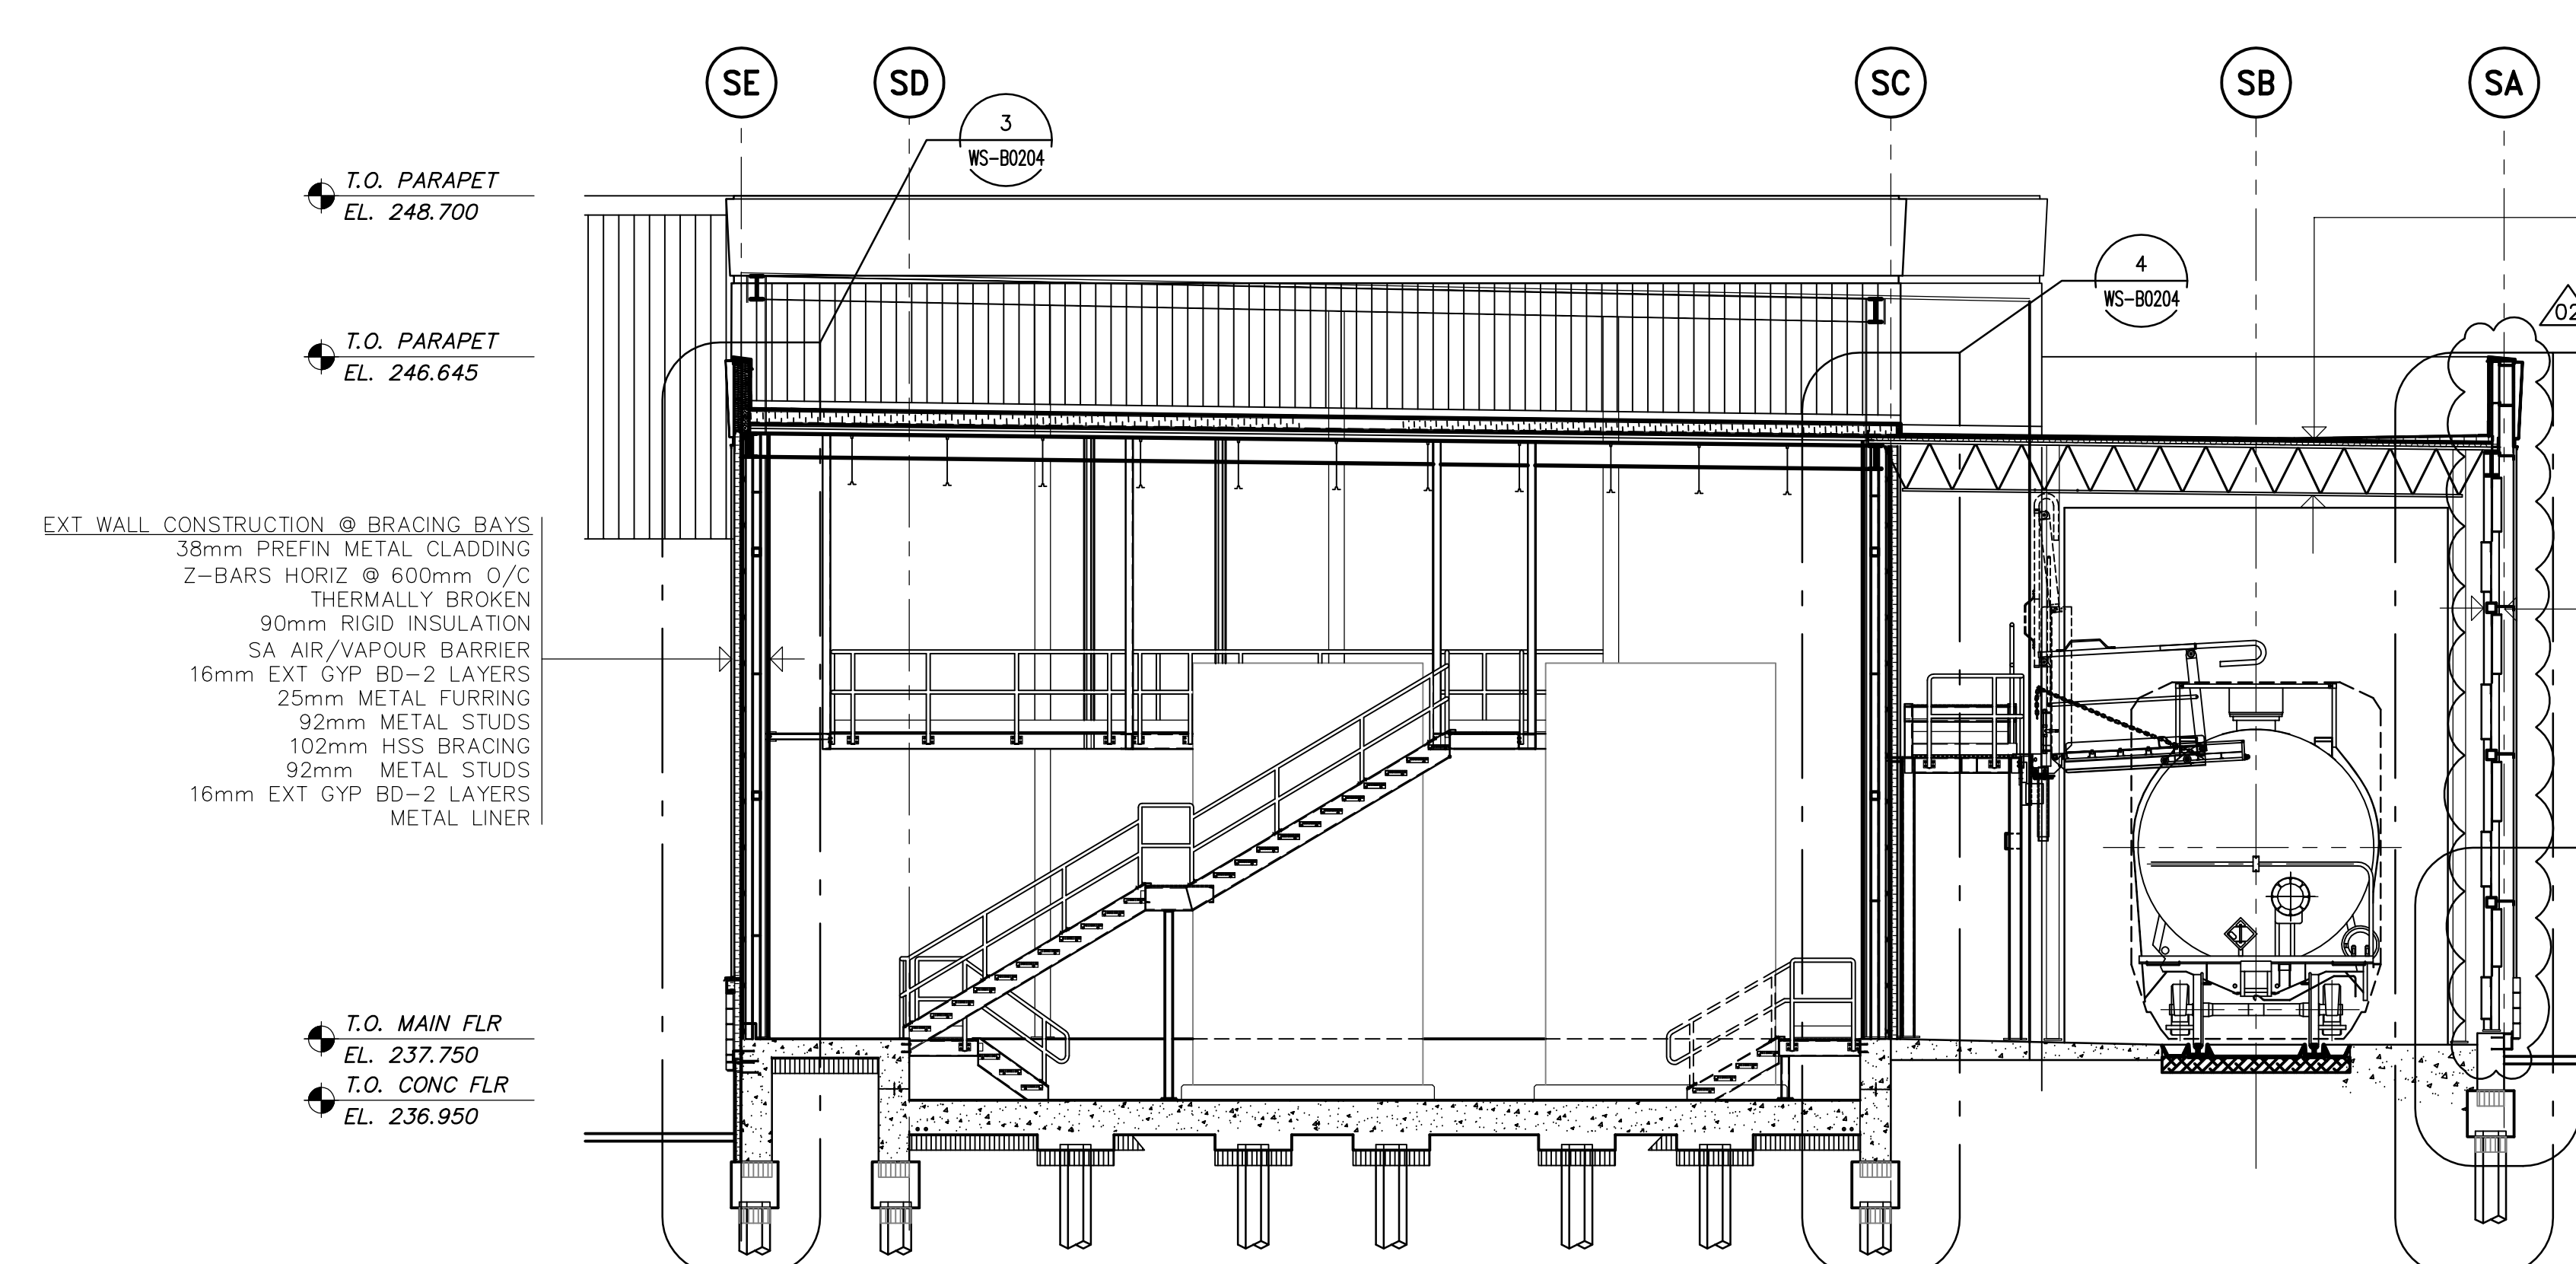

**4 BUILDING SECTION**  
 WS-B0100 1:75

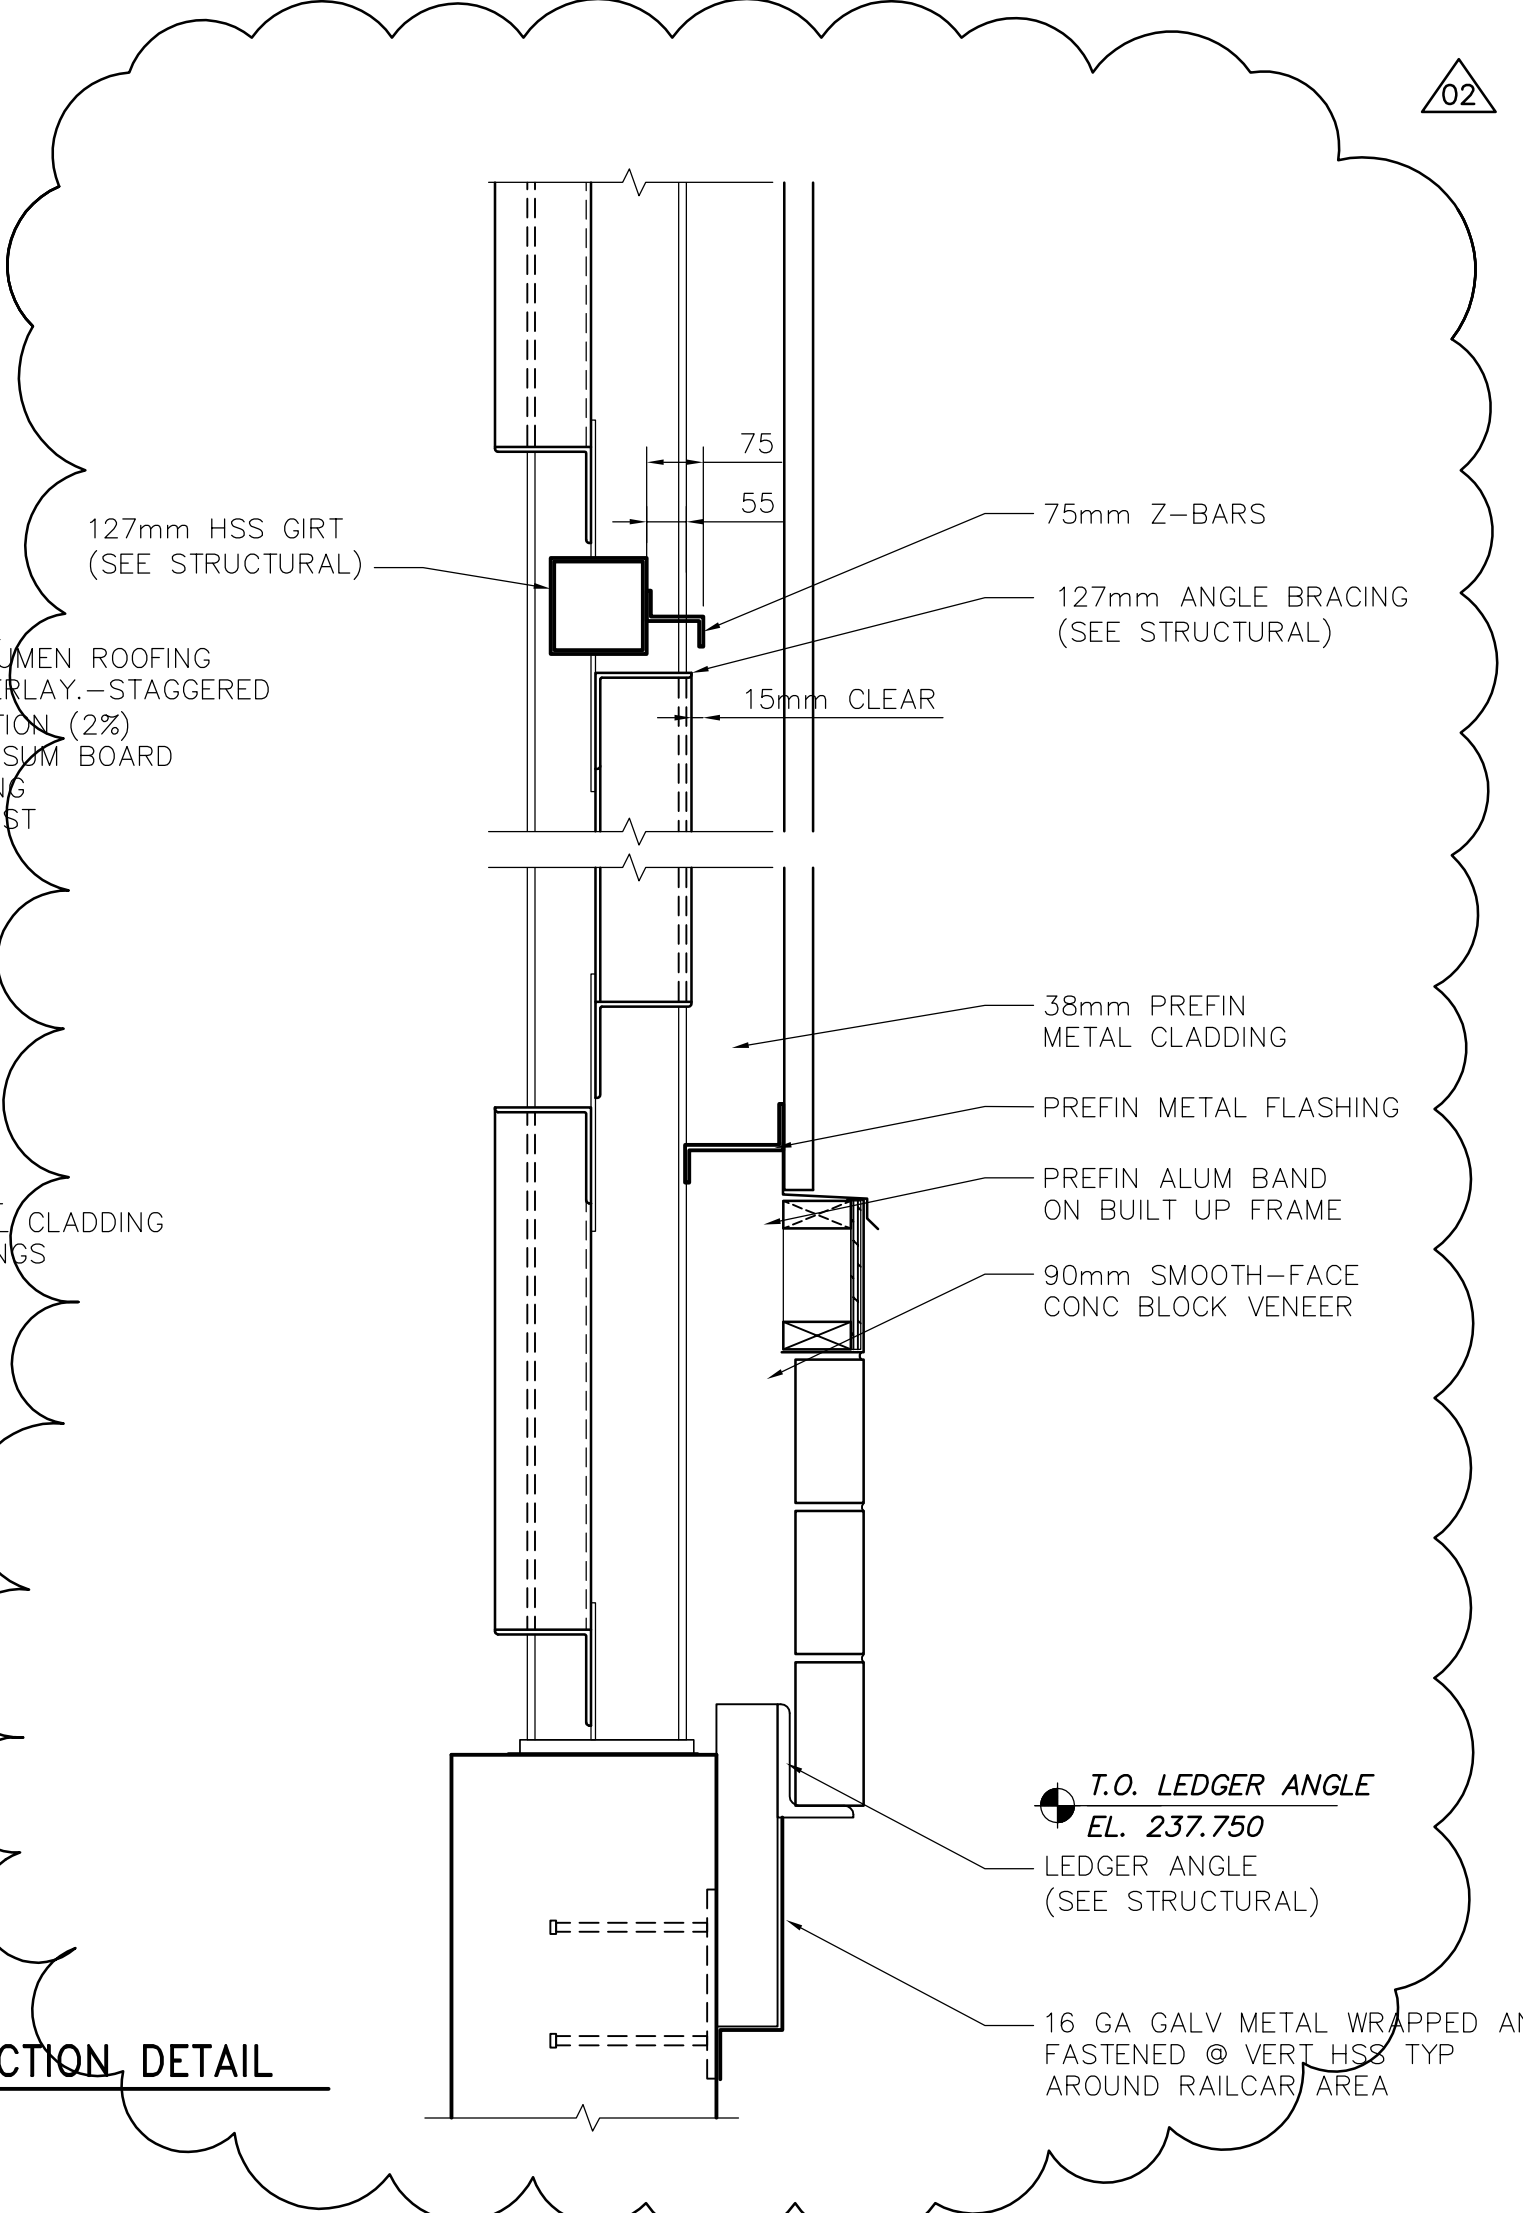

**6 SECTION DETAIL**  
 WS-B0202 1:10



NO.	REVISIONS	DATE	BY	DATE	2006/09/01	DATE	2007/01/31
02	792-2006 ADDENDUM 5	07/04/11	AL				
01	792-2006 ADDENDUM 4	07/04/05	AL				
00	ISSUED FOR TENDER	07/01/31	AL				

DESIGNED BY	NC	CHECKED BY	LK
DRAWN BY	AL	APPROVED BY	AHL
SCALE:	AS SHOWN	RELEASED FOR CONSTRUCTION BY:	R. SOROKOWSKI

ENGINEER'S SEAL	ORIGINAL SIGNED BY	NEIL COOPER
		2007/01/31
CONSULTANT DRAWING NO.	WS-B0202	

**THE CITY OF WINNIPEG**  
 WATER AND WASTE DEPARTMENT  
 ENGINEERING DIVISION

WATER TREATMENT PLANT  
 BULK CHEMICAL BUILDING  
 SODIUM HYPOCHLORITE AND CHEMICAL STORAGE BUILDING

ARCHITECTURAL  
 BUILDING SECTIONS

CITY FILE NUMBER  
 SHEET OF  
 CITY DRAWING NUMBER  
 1-0601S-A-B0202-001-020