SHEET: COW-A1 (05/2005)

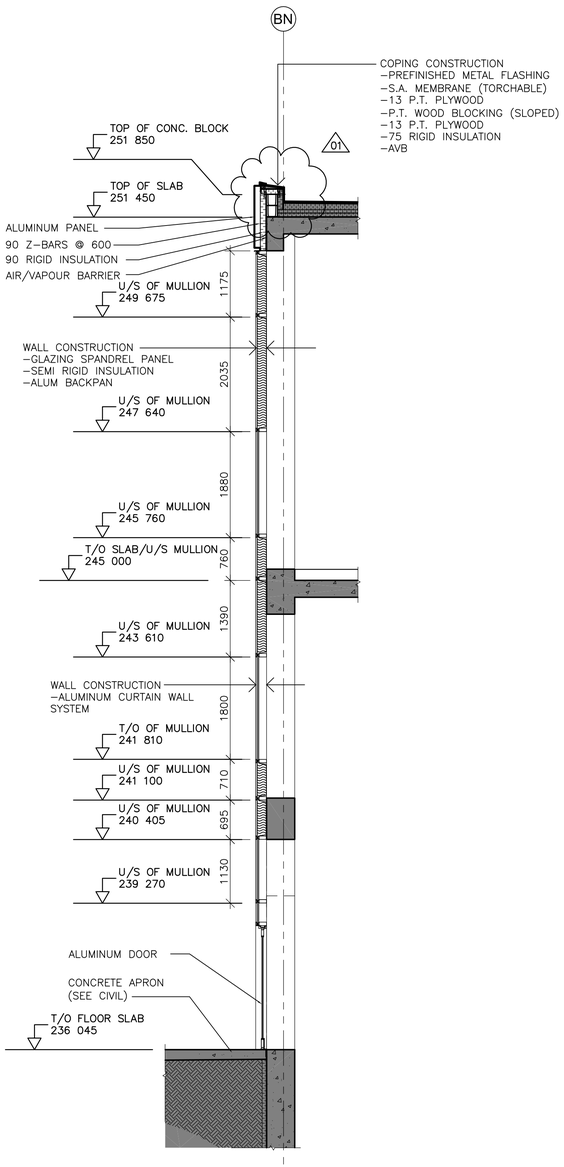

12 WB-B0110 WALL SECTION 1 : 50

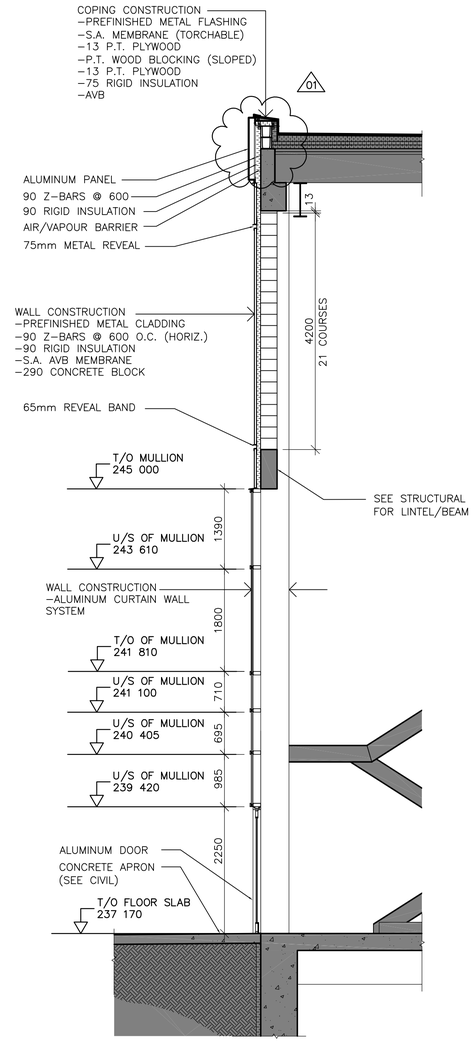

13 WB-B0110 WALL SECTION 1 : 50

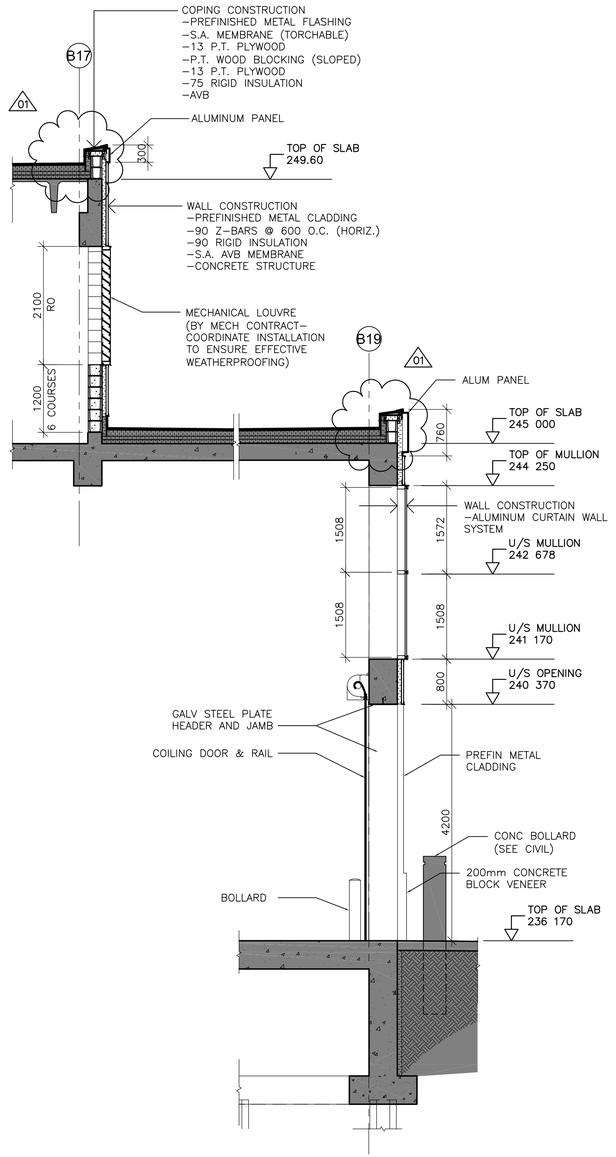

14 WB-B0110 WALL SECTION 1 : 50

PROVINCE OF MANITOBA
NEIL COOPER
ARCHITECT
INC.
No.090
APPROVED ARCHITECTURAL CORPORATION

B.M.
ELEV.

NO.	REVISIONS	DATE	BY
01	793-2006 ADDENDUM 1	07/03/29	LK
00	ISSUED FOR TENDER	07/03/19	LK

CH2MHILL
Fredericksen Cooper ARCHITECTS
EarthTech A Tyco International Ltd. Company

DESIGNED BY	NC	CHECKED BY	LK
DRAWN BY	IC	APPROVED BY	AHL
SCALE:	AS SHOWN	RELEASED FOR CONSTRUCTION BY:	R. SOROKOWSKI
DATE	2005/11/28	DATE	2007/03/19

ENGINEER'S SEAL
ORIGINAL SIGNED BY
NEIL COOPER
2007/03/19

CONSULTANT DRAWING NO.
WB-B0254

Winnipeg
THE CITY OF WINNIPEG
WATER AND WASTE DEPARTMENT
ENGINEERING DIVISION

WATER TREATMENT PLANT
MAIN BUILDING
BUILDING ENVELOPE

ARCHITECTURAL
WALL SECTIONS

CITY FILE NUMBER
SHEET OF
CITY DRAWING NUMBER
1-0601B-A-B0254-001-010

Last Save: 2007-03-28 11:04 AM

E:\NC\JOBDATA\2004\04018 WINNIPEG WATER TREATMENT\02A-CAD\WTP\CONT DWGS\FCA\WALL SECTIONS-TRACTUS\793-2006 ADDENDUM 1\DN_WB-B0254_FC.DWG