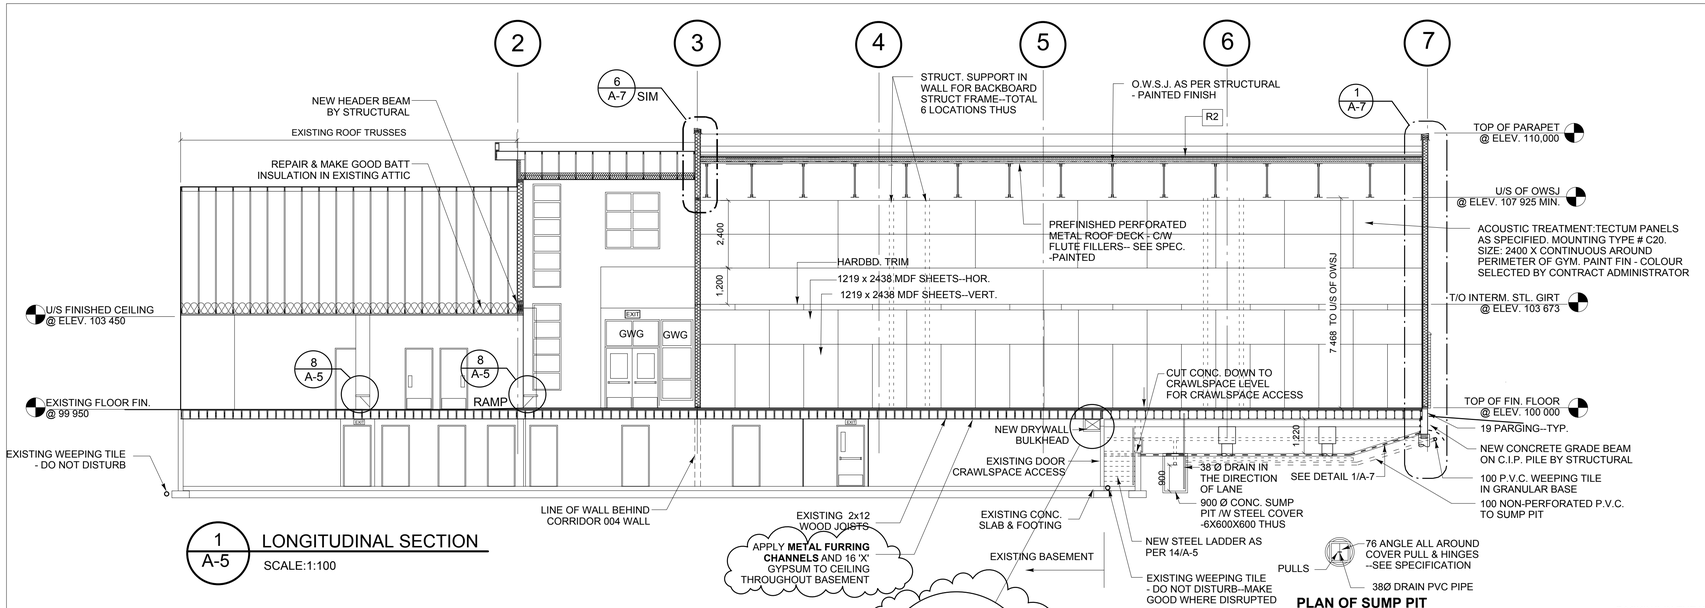

1 A-5 LONGITUDINAL SECTION
SCALE:1:100

PLAN OF SUMP PIT

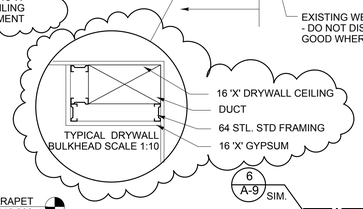

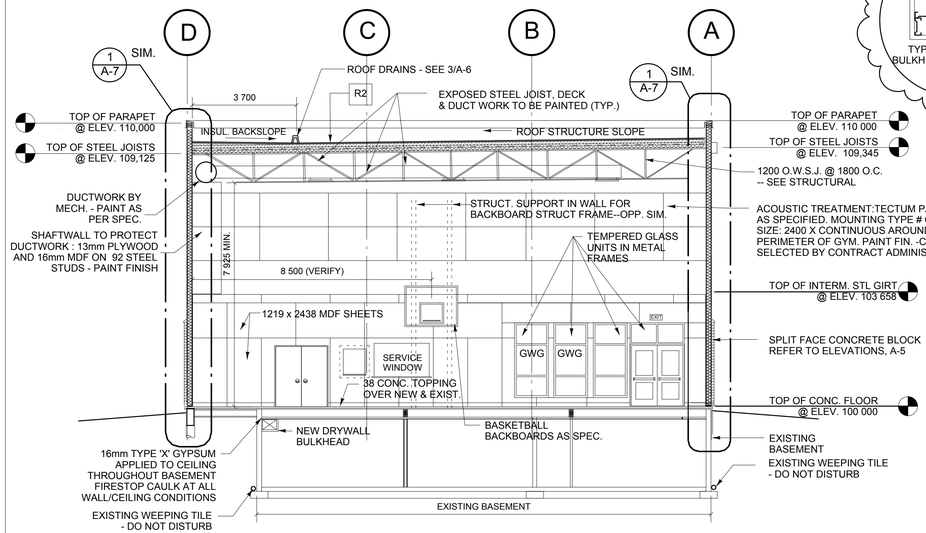

2 A-5 CROSS SECTION THRU GYMNASIUM
SCALE1:100

3 A-5 SECTION THRU LOBBY
SCALE 1:100

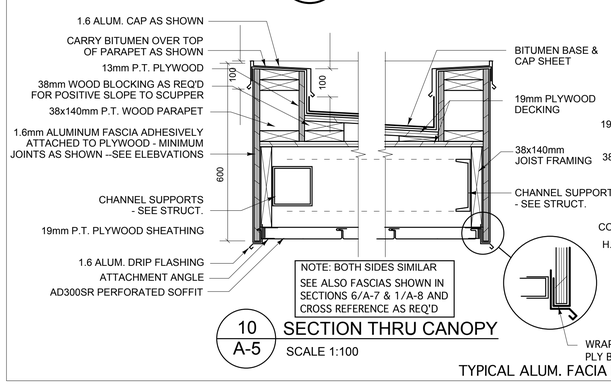

10 A-5 SECTION THRU CANOPY
SCALE 1:100

TYPICAL ALUM. FACIA DET.

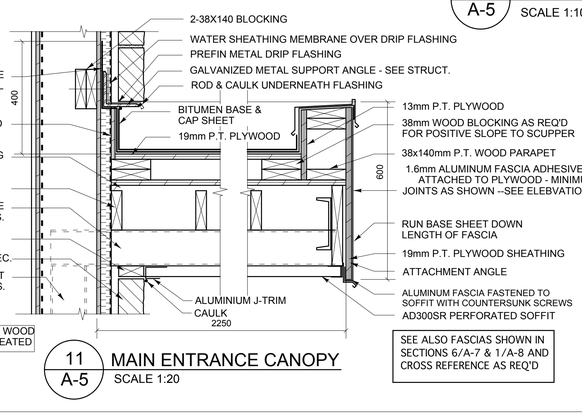

11 A-5 MAIN ENTRANCE CANOPY
SCALE 1:20

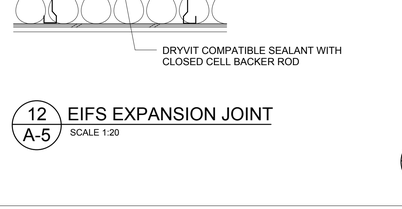

12 A-5 EIFS EXPANSION JOINT
SCALE 1:20

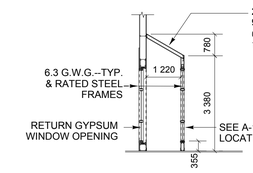

4 A-5 SECTION THRU STAIR
SCALE 1:100

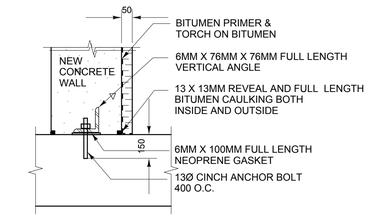

5 A-5 CONCRETE JOINT SEAL DET.
SCALE 1: 10

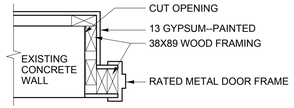

6 A-5 DOOR OPENING FRAMING
SCALE 1: 10

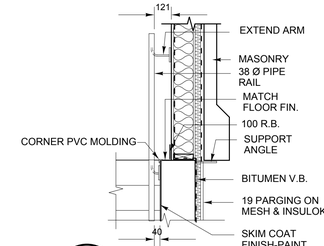

7 A-5 STAIR WALL
SCALE 1: 20

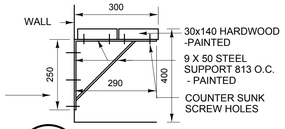

8 A-5 BENCH DETAIL
SCALE 1: 10

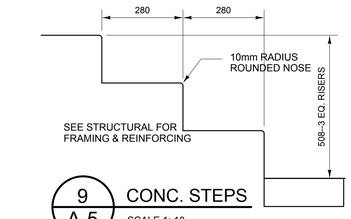

9 A-5 CONC. STEPS
SCALE 1: 10

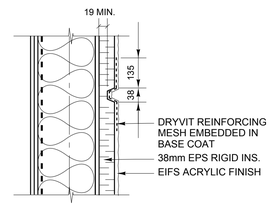

13 A-5 EIFS REVEAL
SCALE: 1:10

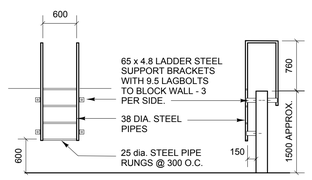

14 A-5 CRAWLSPACE ACCESS LADDER
SCALE: 1:10

R1: 01-28-2008 - ISSUED FOR CLARIFICATION
revisions

This drawing must not be scaled.

The general Contractor must verify all dimensions, datums and levels prior to commencement of work. All errors and omissions must be reported immediately to the Architect.

Variations and modifications to work shown on this drawing shall not be carried out without written permission from the Architect.

This drawing is the exclusive property of the Architect and cannot be reproduced without written permission of the Architect. Reproduction must bear the name of the Architect. Copyright © 2007.

seals

PROVINCE OF MANITOBA APPROVED ARCHITECTURAL CORPORATION HAROLD G. FUNK ARCHITECT INC. No. 075 11-14-2007

PROVINCE OF MANITOBA HAROLD G. FUNK REGISTERED ARCHITECT 11-14-2007

engineers

architect
HAROLD FUNK ARCHITECT INC.
401-55 Donald Street Winnipeg MB R3C 1L8
Tel. (204) 943-5087 Fax (204) 949-9231

project

VALOUR COMMUNITY CENTRE GYMNASIUM ADDITION AND RENOVATIONS

715 Telfer St. North, Winnipeg, Manitoba

sheet title

BUILDING SECTIONS

project no. 06 1288
scale AS SHOWN
drawn by B.P.
approved by H.F
date 28 JANUARY 2008

sheet no.
A-5