


WORK REMOVED FROM OVERALL PROJECT

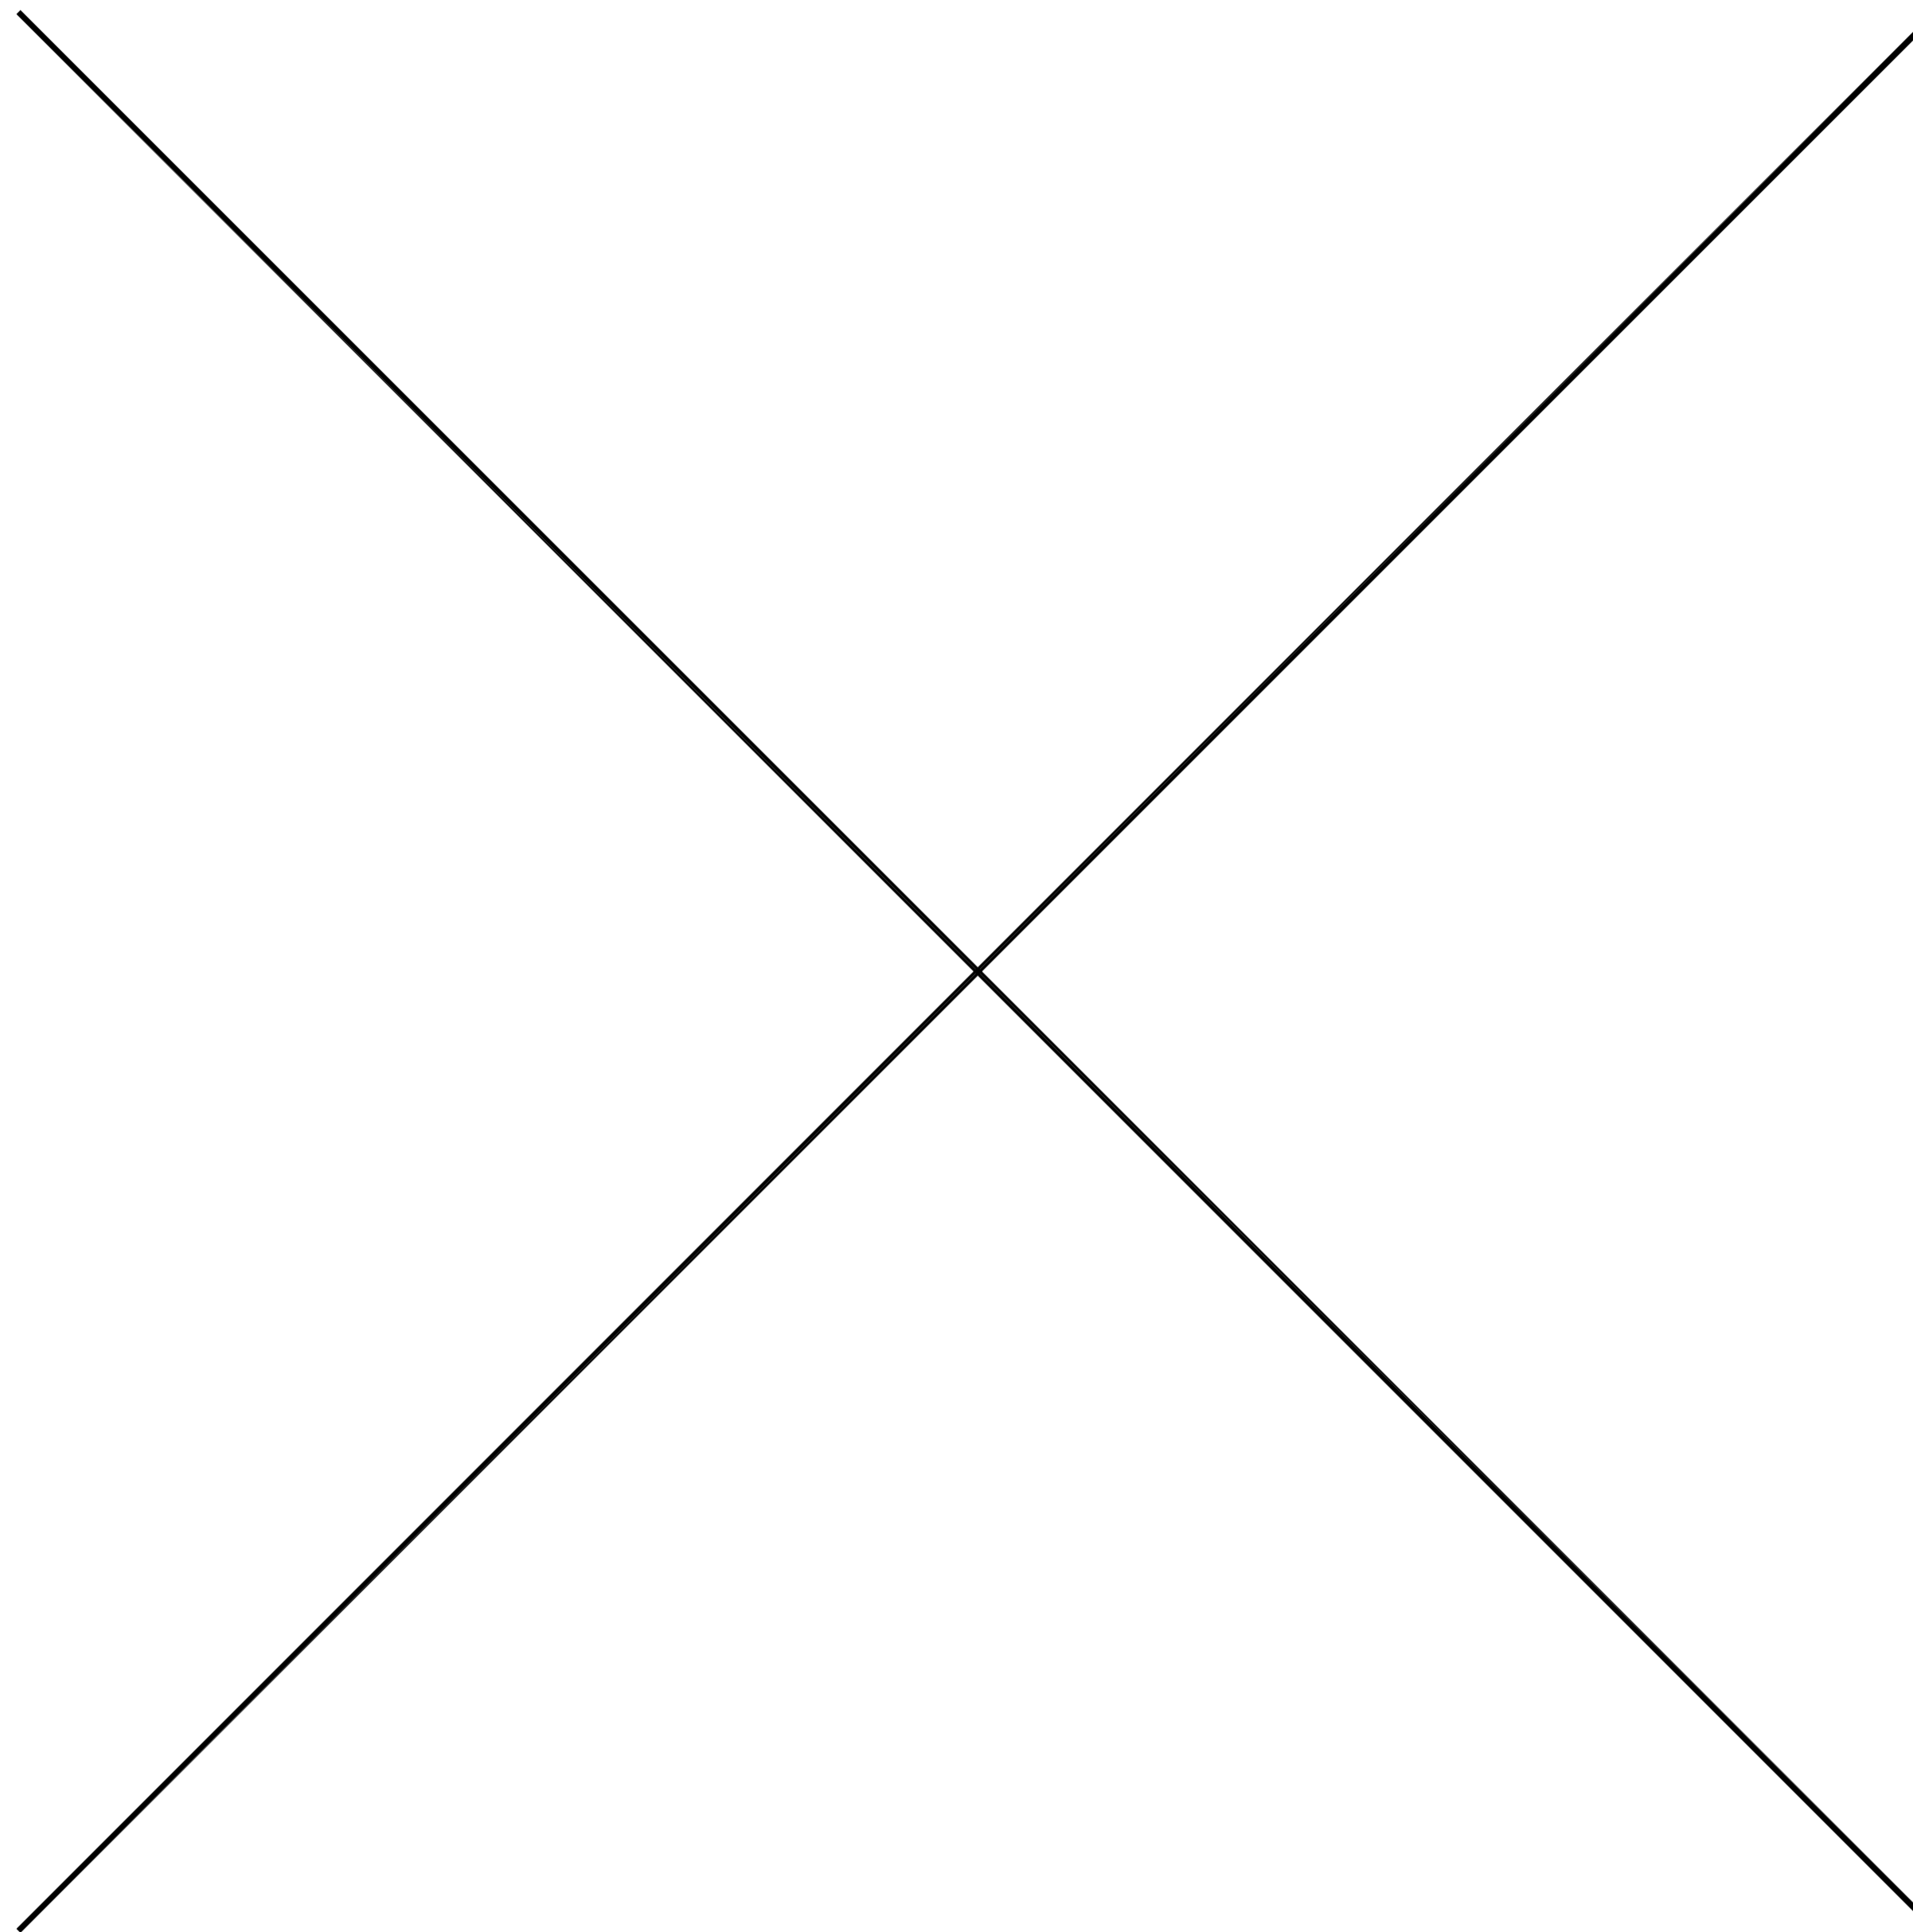

150 mm W.M.	WATER MAIN	150 mm W.M.	HYDRO	150 mm W.M.	WATER MAIN	150 mm W.M.	UNDERGROUND STRUCTURES	B.M. ELEV. 63-026 232.364	DESIGNED BY R.T.P.		ENGINEER'S SEAL	THE CITY OF WINNIPEG TRANSIT DEPARTMENT	CITY DRAWING NUMBER
300 mm L.D.S.	LAND DRAINAGE SEWER	300 mm L.D.S.	CONCRETE	300 mm L.D.S.	LAND DRAINAGE SEWER	300 mm L.D.S.	DATE	DRAWN BY P.M.W./A.J.P.	RELEASED FOR CONSTRUCTION		ON STREET TRANSIT PRIORITY IMPROVEMENTS - PHASE 1		SHEET 5 OF 14
250 mm W.W.S.	WASTE WATER SEWER	250 mm W.W.S.	ASPHALT	250 mm W.W.S.	WASTE WATER SEWER	250 mm W.W.S.	NOTE:	CHECKED BY D.B.W.	HOR. SCALE 1:250		ST MARY'S CORRIDOR		
	MANHOLE		PLANING		WASTE WATER SEWER		LOCATION OF UNDERGROUND STRUCTURES AS SHOWN ARE BASED ON THE BEST INFORMATION AVAILABLE. BUT NO GUARANTEE IS GIVEN THAT ALL EXISTING UTILITIES ARE SHOWN OR THAT THE GIVEN LOCATIONS ARE EXACT. CONFIRMATION OF EXISTENCE AND EXACT LOCATION OF ALL SERVICES MUST BE OBTAINED FROM THE INDIVIDUAL UTILITIES BEFORE PROCEEDING WITH CONSTRUCTION.	APPROVED BY	VERTICAL 1:10		ST MARY'S RD @ BISHOP GRANDIN BLVD		
	CATCH BASIN		PAVING STONES		WASTE WATER SEWER				DATE JUNE 15 / 2007				
	CURB INLET		PARTIAL DEPTH REPAIR		WASTE WATER SEWER								
	JUNCTIONS		PROPERTY LINE		WASTE WATER SEWER								
	CULVERT		SURVEY BAR		WASTE WATER SEWER								
	GAS		PARAPLEGIC RAMP		WASTE WATER SEWER								
EXISTING	LEGEND-PLAN	PROPOSED	EXISTING	LEGEND-PLAN	PROPOSED	EXISTING	LEGEND-PROFILE	PROPOSED					